



MORE THAN ARCHITECTS

## ADDENDUM

NO. 3

TO THE DRAWINGS AND THE PROJECT MANUAL

**PROJECT NAME:** Johnson High School 2025 Additions and Renovations

**CLIENT NAME:** Hays CISD

**LOCATION:** Buda, TX

**PROJECT NUMBER:** 1954-07-01

**PROPOSAL DATE:** 22 May, 2025

**ADDENDUM DATE:** 15 May, 2025

For additional information regarding this project, contact Gigi Morgan at 800.687.1229.



**THIS ADDENDUM INCLUDES:**

Civil Items	5 Pages
Sports Items	2 Pages
Structural Items	9 Pages
Plumbing Items	2 Pages
Mechanical Items	3 Pages
Electrical Items	7 Pages
Technology Items	1 Page

**AND ALL ATTACHED REVISED SPECIFICATION & DRAWING REFERENCES IN THE ADDENDUM**



Project Name: Johnson High School 2025 Additions and Renovations  
Client: Hays CISD  
Buda, TX  
Project Number: 1954-07-01



## CIVIL ITEMS FOR ADDENDUM NO. 3

### NOTICE TO PROPOSERS:

- A. This Addendum shall be considered part of the contract documents for the above-mentioned project as though it had been issued at the same time and incorporated integrally therewith. Where provisions of the following supplementary data differ from those of the original contract documents, this Addendum shall govern and take precedence.
- B. Proposers are hereby notified that they shall make any necessary adjustments in their estimate on account of this Addendum. It will be construed that each Proposer's proposal is submitted with full knowledge of all modifications and supplemental data specified therein. Acknowledge receipt of this addendum in the space provided on the proposal form. Failure to do so may subject Proposer to disqualification.

REFERENCE IS MADE TO THE DRAWINGS AS NOTED:

### DRAWINGS:

AD No 3, Civil Item 1: **To the Drawings, Sheet C4.01, "DIMENSION CONTROL PLAN (1 OF 2),"**

1. Modification of MAC footprint.

AD No 3, Civil Item 2: **To the Drawings, Sheet C6.01, "GRADING PLAN (1 OF 2),"**

1. Modification of MAC footprint.

AD No 3, Civil Item 3: **To the Drawings, Sheet C7.01, "UTILITY PLAN (1 OF 2),"**

1. Addition of utility vault.


AD No 3, Civil Item 4: **To the Drawings, Sheet C8.01, "STORM PLAN (1 OF 2),"**

1. Addition of storm line to utility vault

### END OF CIVIL ADDENDUM

**Huckabee**



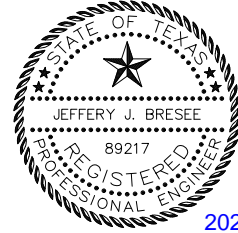

2025-05-14

F-7524

A handwritten signature in blue ink that reads "Jeffery J. Bresee".

### SPORTS ITEMS FOR ADDENDUM NO. 3

#### **NOTICE TO PROPOSERS:**

- A. This Addendum shall be considered part of the contract documents for the above-mentioned project as though it had been issued at the same time and incorporated integrally therewith. Where provisions of the following supplementary data differ from those of the original contract documents, this Addendum shall govern and take precedence.
- B. Proposers are hereby notified that they shall make any necessary adjustments in their estimate on account of this Addendum. It will be construed that each Proposer's proposal is submitted with full knowledge of all modifications and supplemental data specified therein. Acknowledge receipt of this addendum in the space provided on the proposal form. Failure to do so may subject Proposer to disqualification.

REFERENCE IS MADE TO THE DRAWINGS AND THE PROJECT MANUAL AS NOTED:

#### **DRAWINGS:**

##### AD No 1, Sports Item 1: To the Drawings, Sheet F1

- 1) Tension netting behind football goal posts have been adjusted to be 100 ft long.
- 2) Added note 70FF to the sheet and labeled it at all four soccer field corners.
- 3) Added note 70GG to the sheet and labeled it at all four soccer field corners.

#### **END OF SPORTS ADDENDUM**

**Huckabee**





## STRUCTURAL ITEMS FOR ADDENDUM NO. 3

### NOTICE TO PROPOSERS:

- A. This Addendum shall be considered part of the contract documents for the above-mentioned project as though it had been issued at the same time and incorporated integrally therewith. Where provisions of the following supplementary data differ from those of the original contract documents, this Addendum shall govern and take precedence.
- B. Proposers are hereby notified that they shall make any necessary adjustments in their estimate on account of this Addendum. It will be construed that each Proposer's proposal is submitted with full knowledge of all modifications and supplemental data specified therein. Acknowledge receipt of this addendum in the space provided on the proposal form. Failure to do so may subject Proposer to disqualification.

REFERENCE IS MADE TO THE DRAWINGS AND THE PROJECT MANUAL AS NOTED:

### DRAWINGS:

**AD No 3, Struct Item 1: To the Drawings, Sheet S1.2 "GENERAL NOTES",**

- 1) Added delegated design for grout retaining walls at Mudskipper system.

**AD No 3, Struct Item 2: To the Drawings, Sheet S2.1A1 "FOUNDATION PLAN – AREA A",**

- 1) Revised overall dimensions for building.

**AD No 3, Struct Item 3: To the Drawings, Sheet S2.1A2 "ROOF FRAMING PLAN – AREA A"**

- 1) Revised overall dimensions for building.

**AD No 3, Struct Item 4: To the Drawings, Sheet S2.1B1 "FOUNDATION PLAN – AREA B"**

- 1) Revised location of plumbing vault.

**AD No 3, Struct Item 5: To the Drawings, Sheet S2.1B2 "ROOF FRAMING PLAN – AREA B"**

- 1) Revised section callouts at canopies.

**AD No 3, Struct Item 6: To the Drawings, Sheet S3.2 "CONCRETE DETAILS"**

- 1) Revised plumbing vault detail.

**AD No 3, Struct Item 7: To the Drawings, Sheet S4.10 "MASONRY WALL ELEVATIONS"**

- 1) Revised wall details.

**AD No 3, Struct Item 8: To the Drawings, Sheet S4.11 "MASONRY WALL ELEVATIONS"**

- 1) Revised wall details.

### END OF STRUCTURAL ADDENDUM

**Huckabee**





*B.J. Hendrix*

**05/14/2025**

## PLUMBING ITEMS FOR ADDENDUM NO. 3

### **NOTICE TO PROPOSERS:**

- A. This Addendum shall be considered part of the contract documents for the above-mentioned project as though it had been issued at the same time and incorporated integrally therewith. Where provisions of the following supplementary data differ from those of the original contract documents, this Addendum shall govern and take precedence.
- B. Proposers are hereby notified that they shall make any necessary adjustments in their estimate on account of this Addendum. It will be construed that each Proposer's proposal is submitted with full knowledge of all modifications and supplemental data specified therein. Acknowledge receipt of this addendum in the space provided on the proposal form. Failure to do so may subject Proposer to disqualification.

REFERENCE IS MADE TO THE DRAWINGS AND THE PROJECT MANUAL AS NOTED:

### **DRAWINGS:**

AD No 3, Plumb Item 1: **To the Drawings, Sheet P0.10, "Schedules - Plumbing,"**

- 1) Revised floor sink "FS2" to have "hinged" full grate.

### **END OF PLUMBING ADDENDUM**

**Huckabee**





*B.J. Hendrix*  
**05/14/2025**

## MECHANICAL ITEMS FOR ADDENDUM NO. 3

### NOTICE TO PROPOSERS:

- A. This Addendum shall be considered part of the contract documents for the above-mentioned project as though it had been issued at the same time and incorporated integrally therewith. Where provisions of the following supplementary data differ from those of the original contract documents, this Addendum shall govern and take precedence.
- B. Proposers are hereby notified that they shall make any necessary adjustments in their estimate on account of this Addendum. It will be construed that each Proposer's proposal is submitted with full knowledge of all modifications and supplemental data specified therein. Acknowledge receipt of this addendum in the space provided on the proposal form. Failure to do so may subject Proposer to disqualification.

REFERENCE IS MADE TO THE DRAWINGS AND THE PROJECT MANUAL AS NOTED:

### DRAWINGS:

AD No 3, Mech Item 1: **To the Drawings, Sheet M0.10, "Notes and Legends - Mechanical,"**

- 1) Added accessories note "8" to RTU-B1 and RTU-B2 to interlock units with overhead door.


AD No 3, Mech Item 2: **To the Drawings, Sheet M2.12, "First Floor Plan - Area B - Mechanical,"**

- 2) Added spiral duct detail to sheet. Supply grilles to be set at 30° below horizontal.

**END OF MECHANICAL ADDENDUM**

**Huckabee**



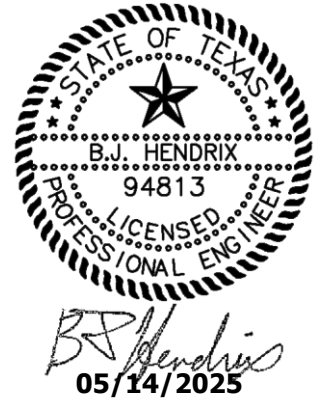

## ELECTRICAL ITEMS FOR ADDENDUM NO. 3

### NOTICE TO PROPOSERS:

- A. This Addendum shall be considered part of the contract documents for the above-mentioned project as though it had been issued at the same time and incorporated integrally therewith. Where provisions of the following supplementary data differ from those of the original contract documents, this Addendum shall govern and take precedence.
- B. Proposers are hereby notified that they shall make any necessary adjustments in their estimate on account of this Addendum. It will be construed that each Proposer's proposal is submitted with full knowledge of all modifications and supplemental data specified therein. Acknowledge receipt of this addendum in the space provided on the proposal form. Failure to do so may subject Proposer to disqualification.

REFERENCE IS MADE TO THE DRAWINGS AND THE PROJECT MANUAL AS NOTED:

### DRAWINGS:

AD No 3, Elec Item 1: **To the Drawings, Sheet E0.01, "SCHEDULES, NOTES, AND LEGENDS - ELECTRICAL,"**

- 1) Added General Note II per owner request.

AD No 3, Elec Item 2: **To the Drawings, Sheet E0.10, "SCHEDULES - ELECTRICAL,"**

- 1) Added clarification regarding power pack installation location.

AD No 3, Elec Item 3: **To the Drawings, Sheet E0.12, "PANEL SCHEDULES - ELECTRICAL,"**

- 1) Revised Panel 'LMAC' for sports netting power.

AD No 3, Elec Item 4: **To the Drawings, Sheet E3.11, "FIRST FLOOR PLAN - AREA A - POWER,"**

- 1) Added power for sports netting equipment.

AD No 3, Elec Item 5: **To the Drawings, Sheet E3.12, "FIRST FLOOR PLAN - AREA B - POWER,"**

- 1) Expanded note regarding IDF room rough-in as shown per owner request.

AD No 3, Elec Item 6: **To the Drawings, Sheet ES1.00, "SITE PLAN - ELECTRICAL,"**

- 1) Expanded site circuiting note to include owner requirement for warning tape with all buried conduit..

### END OF ELECTRICAL ADDENDUM

**Huckabee**



# Technology & Security Narrative


Johnson HS 2025 Additions and Renovations Addendum #3 for Hays CISD

May 14, 2025

## Special Space A/V Systems

The multipurpose activity center AV system will be modified to utilize Community R.5-96MAX speakers on the columns at middle of endzone, 17yds, 39yds, 39yds, 17yds, and middle of endzone in lieu of the shown QSC speakers. Wall box at field shall be OWB-X3-SM-GNG mounted at 36" AFF on center. Speakers shall all be mounted at 15'.



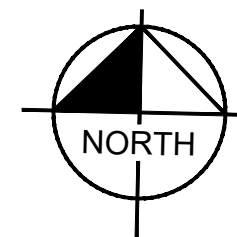

GRAPHIC SCALE IN FEET  
0 15 30 60

## LEGEND

	PROPERTY BOUNDARY
	PROPOSED SAWCUT LINE
	PROPOSED FIRE LANE
	PROPOSED RETAINING WALL (TRIANGLE INDICATE FACE OF WALL)
	PROPOSED PARKING COUNT
	PROPOSED ACCESSIBLE PARKING SPACE
	PROPOSED BARRIER FREE RAMP
	PROPOSED SANITARY SEWER MANHOLE
	PROPOSED CURB INLET
	PROPOSED FIRE HYDRANT
	PROPOSED POWER POLE
	EXISTING SANITARY SEWER MANHOLE
	EXISTING FIRE HYDRANT
	EXISTING POWER POLE
	PROPOSED 6" CONCRETE CURB (REF. DETAIL, C10.00)
	4" PAINTED STRIPE (TYP.)
	4" PAINTED STRIPING, 2' O.C. @ 45°
	FIRE LANE STRIPING (REF. DETAIL, SHEET C5.00)
	ACCESSIBLE PARKING SYMBOL (REF. DETAIL, SHEET C10.00)
	ACCESSIBLE PARKING SIGN (REF. DETAIL, SHEET C10.00)
	CONSTRUCT ON-SITE CONCRETE SIDEWALK (REF. DETAIL, SHEET C10.00)
	CONCRETE WHEELSTOP (REF. DETAIL, SHEET C10.00)
	CONSTRUCT ON-SITE BARRIER FREE RAMP (REF. DETAIL, SHEET C10.00)
	PROPOSED 6" DOG KENNEL FENCE AND GATES
	PROPOSED CONCRETE STAIRS (REF. DETAIL, SHEET C10.00)
	PROPOSED BOLLARDS (REF. DETAIL, SHEET C10.00)
	PROPOSED HANDRAILS (REF. DETAIL, SHEET C10.00)
	PROPOSED FENCE AND GATES (REF. ARCH)
	PROPOSED 6" CURB CUTS
	PROPOSED LIGHT-DUTY CONCRETE PAVEMENT (GENERAL PARKING) (REF. DETAIL, SHEET C10.00)
	PROPOSED MEDIUM-DUTY CONCRETE PAVEMENT (ACCESS DRIVES) (REF. DETAIL, SHEET C10.00)
	PROPOSED HEAVY-DUTY CONCRETE PAVEMENT (BUS LOOP) (REF. DETAIL, SHEET C10.00)
	PROPOSED ON-SITE (PRIVATE) SIDEWALK (REF. DETAIL, SHEET C10.00)
	PROPOSED PUBLIC SIDEWALK (REF. DETAIL, SHEET C10.00)

## NOTES

- ALL DIMENSIONS ARE TO FACE OF CURB UNLESS OTHERWISE NOTED.
- REFER TO ARCHITECTURAL CONSTRUCTION DRAWINGS FOR EXACT BUILDING DIMENSIONS. REFER TO LANDSCAPE ARCHITECT'S PLANS FOR DIMENSIONS AND DETAIL OF HARDSCAPE.
- ALL CURB RADI ARE 3 FEET UNLESS DIMENSIONED OTHERWISE.
- BUILDING, MECHANICAL EQUIPMENT AND SIGNS ARE SHOWN HEREON FOR REFERENCE ONLY. REFER TO CONSTRUCTION PLANS OF THOSE ITEMS FOR LOCATIONS AND DIMENSIONS.
- ALL CONSTRUCTION SPECIFICATIONS WITHIN CITY RIGHT-OF-WAY AND EASEMENTS SHALL COMPLY WITH CITY OF BUDA STANDARDS. PRIOR APPROVAL TO USE ANY NON-STANDARD MATERIAL IS REQUIRED.
- REFERENCE GEOTECHNICAL REPORT FOR ADDITIONAL PAVING AND SOIL PREPARATION NOTES.
- REFERENCE IRRIGATION AND MEP PLANS FOR CONDUIT SIZES AND LOCATIONS UNLESS OTHERWISE NOTED ON THIS SHEET.
- EXPANSION JOINTS SHOULD BE USED WHEREVER THE PAVEMENT WILL ABUT A STRUCTURAL ELEMENT SUBJECT TO DIFFERENT MAGNITUDE OF MOVEMENT, E.G., LIGHT POLES, RETAINING WALLS, EXISTING PAVEMENT, STAIRWAYS, ENTRYWAY PIERS, BUILDING WALLS, OR MANHOLES.
- EXISTING MANHOLE TOPS, VALVE BOXES, ETC. ARE TO BE ADJUSTED AS REQUIRED TO MATCH PROPOSED GRADES. IF NECESSARY, ADJUSTMENTS SHALL BE PERFORMED UPON COMPLETION OF PAVING AND FINE GRADING TO ENSURE A SMOOTH TRANSITION.

## KEY MAP

NT.S.

## BENCHMARK LIST

TBM  
MAGWASHER  
"SOS CONTROL"  
ELEV. = 816.51  
TBM  
MAGWASHER  
"SOS CONTROL"  
ELEV. = 813.61

## CAUTION!!

EXISTING UNDERGROUND UTILITIES IN THE AREA CONTRACTOR IS RESPONSIBLE FOR DETERMINING THE HORIZONTAL AND VERTICAL LOCATION OF ALL UTILITIES PRIOR TO CONSTRUCTION. CONTRACTOR SHALL BE RESPONSIBLE FOR ANY REPAIRS TO EXISTING UTILITIES DUE TO DAMAGE INCURRED DURING CONSTRUCTION. CONTRACTOR SHALL NOTIFY THE ENGINEER OF ANY DISCREPANCIES ON THE PLANS.

SITE PLAN APPROVAL SHEET 13 OF 46  
FILE NUMBER: APPLICATION DATE: 01/23/2025  
APPROVED BY COMMISSION ON: N/A UNDER THE CITY OF BUDA  
UNIFIED DEVELOPMENT CODE  
EXPIRATION DATE: CASE MANAGER:

City Engineer: City of Buda  
Released for General Compliance: ZONING AG  
Rev. 1 Correction 1  
Rev. 2 Correction 2  
Rev. 3 Correction 3

Final plat must be recorded by the Project Expiration Date, if applicable. Subsequent Site Plans which do not comply with the Code current at the time of filing, and all required Building Permits and/or a notice of construction (if a building permit is not required), must also be approved prior to the Project Expiration Date.

ALL RESPONSIBILITY FOR THE ADEQUACY OF THESE PLANS REMAINS WITH THE ENGINEER WHO PREPARED THEM. IN REVIEWING THESE PLANS, THE CITY OF BUDA MUST RELY UPON THE ADEQUACY OF THE WORK OF THE DESIGN ENGINEER.

## TAS NOTE

GROUND AND FLOOR SURFACES ALONG ACCESSIBLE ROUTES AND IN ACCESSIBLE ROOMS AND SPACES INCLUDING FLOORS, WALKS, RAMPS, STAIRS, AND CURB RAMPS, SHALL BE STABLE, FIRM, SLIP-RESISTANT, AND SHALL COMPLY WITH SECTION 302 OF THE TEXAS ACCESSIBILITY STANDARDS.



Know what's below.  
Call before you dig.

JOHNSON HIGH SCHOOL

2025 ADDITIONS


FOR

HAYS C.I.S.D.

BUDA, TEXAS

Project:

**KimleyHorn**  
© 2025 KIMLEY-HORN AND ASSOCIATES, INC.  
TBPE FIRM NO. 928

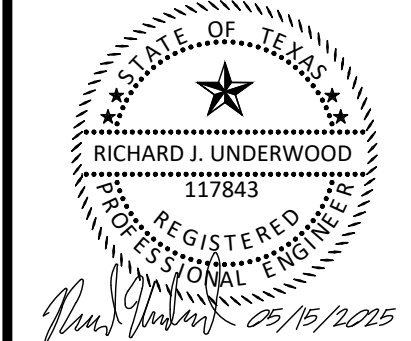

**Huckabee**  
ARCHITECTS • ENGINEERS • PLANNERS  
HUCKABEE & ASSOCIATES, INC.  
www.huckabee-inc.com  
800.687.0225

DIMENSION CONTROL  
PLAN (1 OF 2)

PACKAGE VOLUME

Job No. 1554-07-01 Sheet No.

Issue for Bid

Drawn By: RAU

Date: 05/15/2025

C4.01

DESIGN PROGRESS REVIEW





GRAPHIC SCALE IN FEET  
0 15 30 60

## LEGEND

XXX.XX	PROPOSED SPOT ELEVATION
SW	SIDEWALK
TS	TOP OF STEP
FG	FINISHED GRADE
TW	TOP OF WALL
BW	FINISHED GRADE AT BASE OF WALL
EW	END OF WALL
TC	TOP OF CURB
TG	TOP OF GRATE
EX	EXISTING SPOT ELEVATION
ME	MATCH EXISTING
— 910 —	PROPOSED CONTOURS
— 905 —	EXISTING CONTOURS
— HP — HP — HP —	PROPOSED HIGH POINT
— — — — —	PROPOSED LIMITS OF DISTURBANCE
— — — — —	PROPOSED SWALE
— — — — —	PROPOSED RETAINING WALL (TRIANGLE INDICATES FACE OF WALL)
— — — — —	PROPOSED EXPOSED SLAB (+4")
X X X	DIRECTION OF INTENDED FLOW
— — — — —	PROPOSED CURB RAMP
— — — — —	PROPOSED RAMP WITH HANDRAIL (SEE NOTE 7)
— — — — —	PROPOSED GRADE BREAK/ADA LANDING

## NOTES

- ALL SPOT GRADES ARE TO TOP OF PAVEMENT (TPI) OR TOP OF GRATE (TG), UNLESS OTHERWISE NOTED AS TC (TOP OF CURB). CONTRACTOR TO ADD 8" FOR TOP OF CURB AS NECESSARY.
- NO EARTHEN SLOPE SHALL BE GREATER THAN 3:1, UNLESS OTHERWISE NOTED.
- MAXIMUM SLOPE IN ACCESSIBLE PARKING SPACES, LOADING ZONES AND SIDEWALK LANDINGS SHALL NOT EXCEED 2.0% IN ALL DIRECTIONS.
- MAXIMUM RUNNING SLOPE SHALL NOT EXCEED 5% AND CROSS SLOPE SHALL NOT EXCEED 2% ON ALL SIDEWALKS UNLESS OTHERWISE NOTED. RUNNING SLOPE MAY EXCEED 5% IN PUBLIC R.O.W. IF EXISTING ROAD SLOPE EXCEEDS 5%.
- GENERAL CONTRACTOR TO REFERENCE NOTE 1 REGARDING SPOT ELEVATIONS. COORDINATE WITH DIRT AND LANDSCAPE SUBCONTRACTORS REGARDING PROPOSED SOO AND HYDROMULCH LOCATIONS TO ENSURE ADEQUATE CUT FOR FUTURE VEGETATION.
- EXISTING MANHOLE TOPS, VALVE BOXES, ETC. ARE TO BE ADJUSTED AS REQUIRED TO MATCH PROPOSED GRADES. IF NECESSARY, READJUSTMENTS SHALL BE PERFORMED UPON COMPLETION OF PAVING AND FINE GRADING TO ENSURE A SMOOTH TRANSITION.
- PROPOSED RETAINING WALLS TO BE STRUCTURALLY DESIGNED AND PERMITTED BY CONTRACTOR.

JOHNSON HIGH SCHOOL  
2025 ADDITIONS  
FOR  
HAYS C.I.S.D.  
BUDA, TEXAS

Project:

**Kimley-Horn**  
© 2025 KIMLEY-HORN AND ASSOCIATES, INC.  
TBPE FIRM NO. 928

STATE OF TEXAS  
REGISTERED PROFESSIONAL ENGINEER  
RICHARD J. UNDERWOOD  
117843  
05/15/2025

**Huckabee**  
ARCHITECT • DESIGN • CONSTRUCTION  
HUCKABEE • DESIGN • CONSTRUCTION  
www.huckabee-inc.com  
800.687.0225

GRADING PLAN  
(1 OF 2)

PACKAGE VOLUME


Job No. 1554-07-01 Sheet No. C6.01

Issue For Bid

Drawn By: RAU

Date: 05/15/2025

DESIGN PROGRESS REVIEW

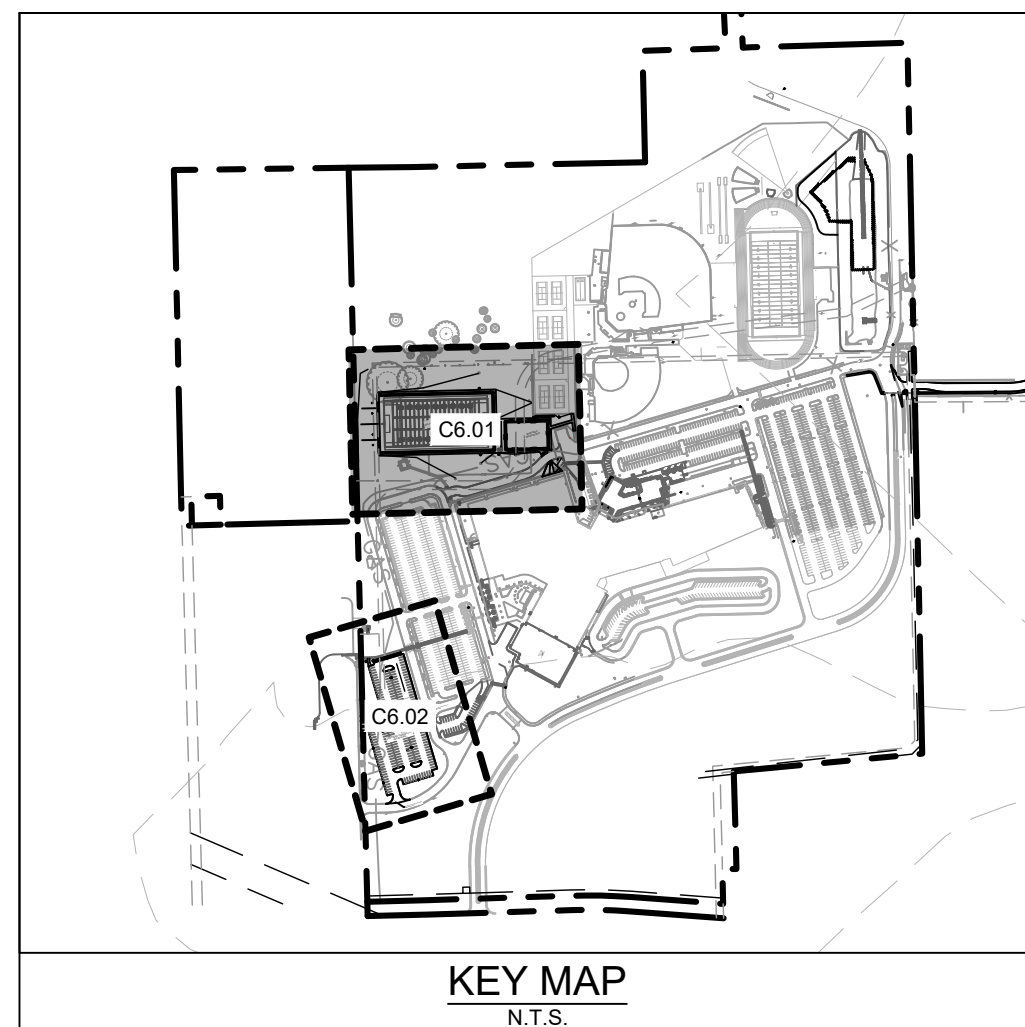

KEY MAP

N.T.S.

## BENCHMARK LIST

TBM  
MAGWASHER  
"SOS CONTROL"  
ELEV. = 816.51


TBM  
MAGWASHER  
"SOS CONTROL"  
ELEV. = 813.61

CAUTION!!

EXISTING UNDERGROUND UTILITIES IN THE AREA CONTRACTOR IS RESPONSIBLE FOR DETERMINING THE HORIZONTAL AND VERTICAL LOCATION OF ALL UTILITIES PRIOR TO CONSTRUCTION. CONTRACTOR SHALL BE RESPONSIBLE FOR ANY REPAIRS TO EXISTING UTILITIES DUE TO DAMAGE INCURRED DURING CONSTRUCTION. CONTRACTOR SHALL NOTIFY THE ENGINEER OF ANY DISCREPANCIES ON THE PLANS.



Know what's below.  
Call before you dig.

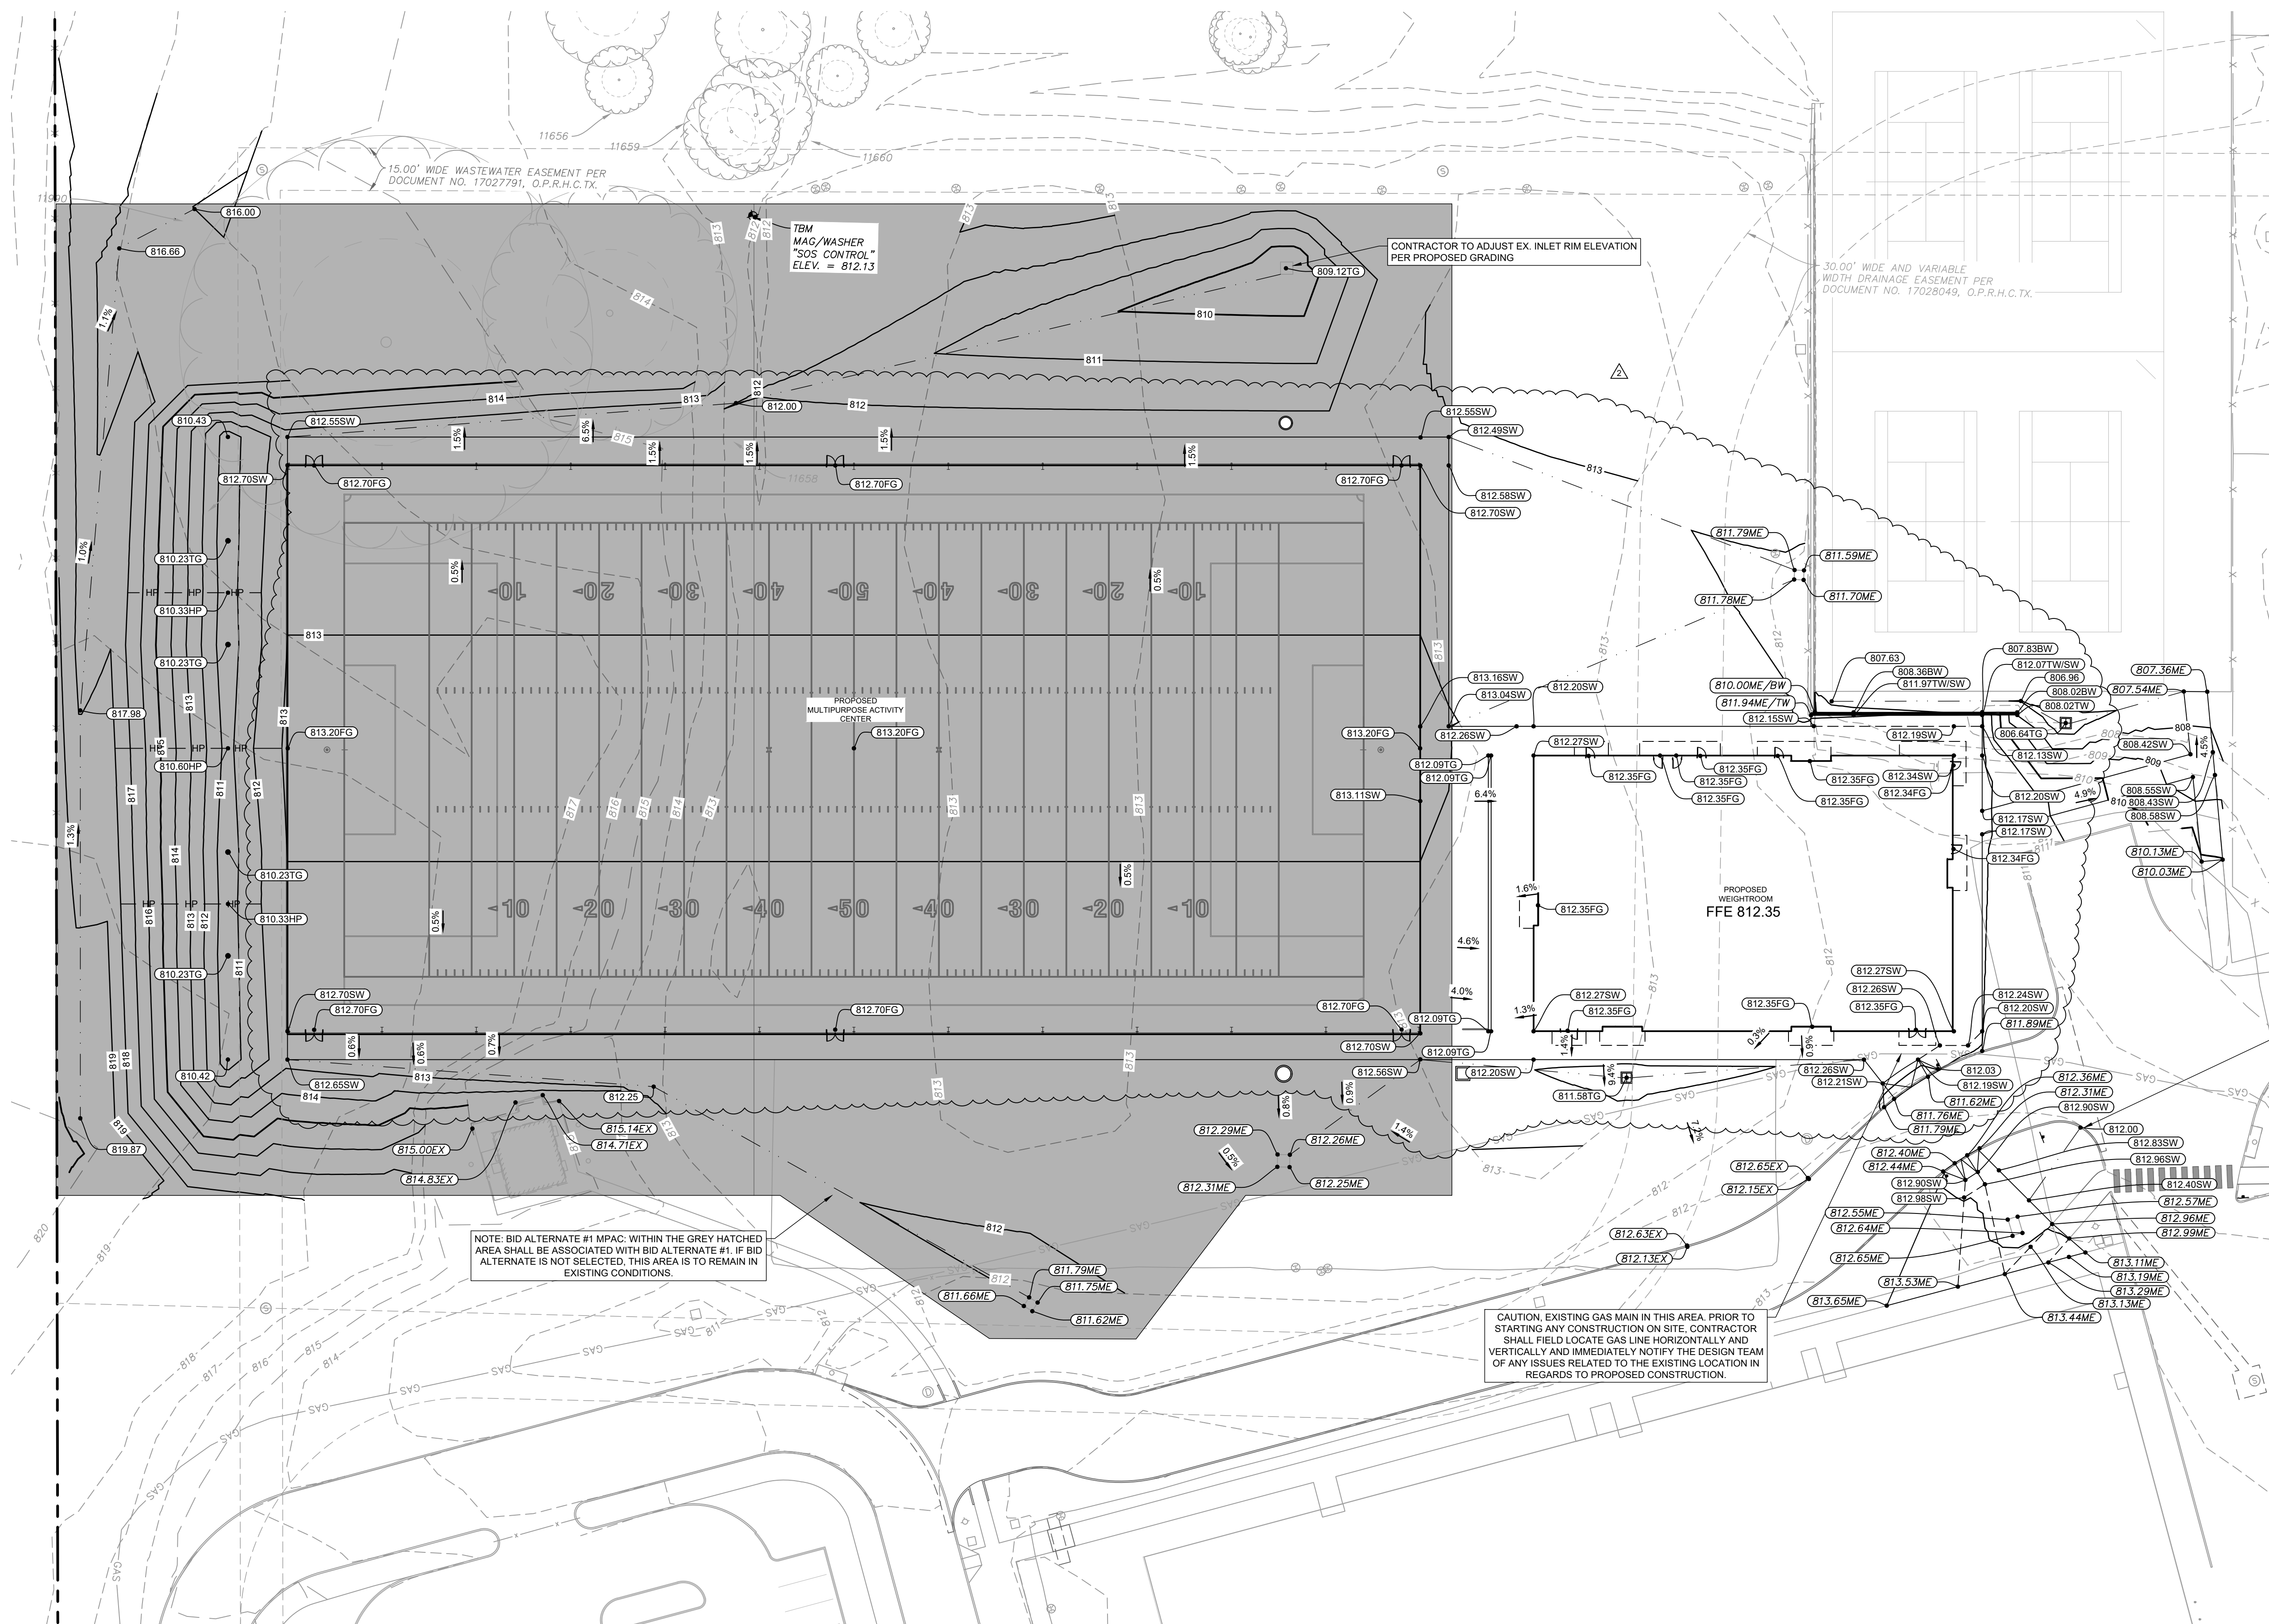

NOTE: BID ALTERNATE #1 MPAC: WITHIN THE GREY HATCHED AREA SHALL BE ASSOCIATED WITH BID ALTERNATE #1. IF BID ALTERNATE IS NOT SELECTED, THIS AREA IS TO REMAIN IN EXISTING CONDITIONS.

NOTE: RETAINING WALL BY OTHERS SHALL TAKE INTO CONSIDERATION THE SURROUNDING PROPOSED IMPROVEMENTS, SUCH AS LIGHT AND PARKING. CONTRACTOR SHALL PROVIDE CONSTRUCTION PLANS, INCLUDING STRUCTURAL DESIGN AND HANDRAIL, FOR THE RETAINING WALL IN CONFORMANCE WITH CITY STANDARDS. CONTRACTOR SHALL SUBMIT PLANS FOR THE OWNER, ARCHITECT, AND ENGINEER REVIEW AND CONTRACTOR SHALL OBTAIN CITY PERMIT.

CAUTION: EXISTING GAS MAIN IN THIS AREA. PRIOR TO STARTING ANY CONSTRUCTION ON SITE, CONTRACTOR SHALL FIELD LOCATE GAS LINE HORIZONTALLY AND VERTICALLY AND IMMEDIATELY NOTIFY THE DESIGN TEAM OF ANY ISSUES RELATED TO THE EXISTING LOCATION IN REGARDS TO PROPOSED CONSTRUCTION.


CONTRACTOR TO SAWCUT A 1" WIDE SECTION OF CURB TO ALLOW DRAINAGE OF THIS LANDSCAPE AREA

PROPOSED WEIGHTROOM  
FFE 812.35



Plotted By: Williams, Scott May 14, 2025 10:45:05am K:\SHA\_Civil\06607098-JOHNSON HS 2025 EXPANSION\CAD\PlanSheets\C-UTIL-06607098.dwg  
This document, together with the concepts and designs presented herein, is an instrument of service, and is intended only for the specific purpose and client for which it was prepared. Reuse of and improper reliance on this document without written authorization and adaptation by Kimley-Horn and Associates, Inc. shall be without liability to Kimley-Horn and Associates, Inc.

Copyright © 2025, Huckabee & Associates, Inc.

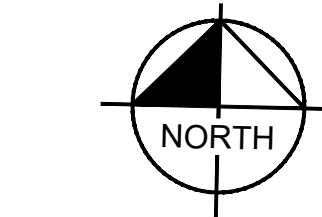

GRAPHIC SCALE IN FEET  
0 15 30 60

#### LEGEND

---	PROPOSED SAWCUT LINE
SS	PROPOSED SANITARY SEWER LINE
W	PROPOSED WATER LINE
---	PROPOSED GAS LINE
UGE	PROPOSED UNDERGROUND ELECTRIC LINE
UGT	PROPOSED UNDERGROUND COMMUNICATION LINE
---	PROPOSED STORM DRAIN LINE
SS	EXISTING SANITARY SEWER LINE
W	EXISTING WATER LINE
---	EXISTING GAS LINE
OHE	EXISTING OVERHEAD ELECTRIC LINE
---	EXISTING STORM DRAIN LINE
⊙	PROPOSED SANITARY SEWER MANHOLE
○	PROPOSED CLEANOUT
⊕	PROPOSED FIRE HYDRANT
⊕	PROPOSED WATER METER
⊕	PROPOSED BACKFLOW PREVENTER
⊕	PROPOSED VALVE
⊕	PROPOSED FITTING
⊕	PROPOSED GAS METER
⊕	PROPOSED POWER POLE
⊕	PROPOSED TRANSFORMER
⊕	PROPOSED CURB INLET
⊕	PROPOSED STORM MANHOLE
⊕	EXISTING SANITARY SEWER MANHOLE
⊕	EXISTING CLEANOUT
⊕	EXISTING FIRE HYDRANT
⊕	EXISTING WATER METER
⊕	EXISTING VALVE
⊕	EXISTING POWER POLE
⊕	EXISTING STORM INLET


#### NOTES

1. CONTRACTOR TO FIELD VERIFY LOCATION OF ALL UTILITIES PRIOR TO CONSTRUCTION. CONTACT ENGINEER IF FIELD CONDITIONS VARY.
2. ALL DIMENSIONS ARE TO CENTERLINE OF PIPE UNLESS NOTED OTHERWISE.
3. UTILITY CONNECTIONS TERMINATE 9' FROM BUILDING ENVELOPE. SEE ARCHITECT AND MEP PLANS FOR CONTINUATION.
4. VALVES 12" AND UNDER WILL BE RESILIENT SEAT GATE VALVES (RSGV).
5. FIRE SPRINKLER LINE SHALL BE SIZED AND INSTALLED BY A LICENSED FIRE SPRINKLER CONTRACTOR.
6. REFER TO CITY OF BUDA DESIGN GUIDELINES FOR ALL WATER METER AND FIRE HYDRANT DETAILS.
7. REFER TO CITY OF BUDA STANDARD CONSTRUCTION DETAILS FOR ALL SANITARY SEWER MANHOLES AND CLEANOUTS.
8. ALL FITTINGS SHALL BE OF DOMESTIC MANUFACTURE AND SHALL BE MECHANICALLY RESTRAINED.
9. CONTRACTOR SHALL REFER AND ADHERE TO ALL TCEQ DESIGN GUIDELINES (CHAPTER 217 AND 290) FOR ALL UTILITY CROSSINGS REQUIREMENTS.
10. CONTRACTOR TO CHECK THAT EXISTING WATER LINES MEET CITY OF BUDA MINIMUM COVER. IF NOT, CONTRACTOR TO INSTALL 480EG VERTICAL BENDS WHERE NECESSARY TO MAINTAIN MINIMUM COVER.
11. REFERENCE WATER AND SANITARY SEWER NOTES ON SHEET C1.00 FOR ADDITIONAL REQUIREMENTS.
12. REFERENCE SHEET C10.02 WATER AND SEWER STANDARD DETAILS.

JOHNSON HIGH SCHOOL  
2025 ADDITIONS  
FOR  
HAYS C.I.S.D.  
BUDA, TEXAS

Project:

**Kimley-Horn**  
© 2025 KIMLEY-HORN AND ASSOCIATES, INC.  
TBP# FIRM NO. 928

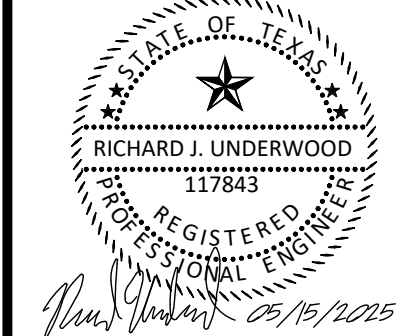

**Huckabee**  
ARCHITECT • DESIGN • CONSTRUCTION  
HUCKABEE • DESIGN • CONSTRUCTION  
www.huckabee-inc.com  
800.687.0225

UTILITY PLAN  
(1 OF 2)

PACKAGE VOLUME

Job No. 1554-07-01 Sheet No. ISSUE FOR BID

Drawn By: Date: 05/15/2025

C7.01


DESIGN PROGRESS REVIEW

#### BENCHMARK LIST

TBM  
MAGWASHER  
"SOS CONTROL"  
ELEV. = 816.51  
TBM  
MAGWASHER  
"SOS CONTROL"  
ELEV. = 813.61


CAUTION!!

EXISTING UNDERGROUND UTILITIES IN THE AREA CONTRACTOR IS RESPONSIBLE FOR DETERMINING THE HORIZONTAL AND VERTICAL LOCATION OF ALL UTILITIES PRIOR TO CONSTRUCTION. CONTRACTOR SHALL BE RESPONSIBLE FOR ANY REPAIRS TO EXISTING UTILITIES DUE TO DAMAGE INCURRED DURING CONSTRUCTION. CONTRACTOR SHALL NOTIFY THE ENGINEER OF ANY DISCREPANCIES ON THE PLANS.

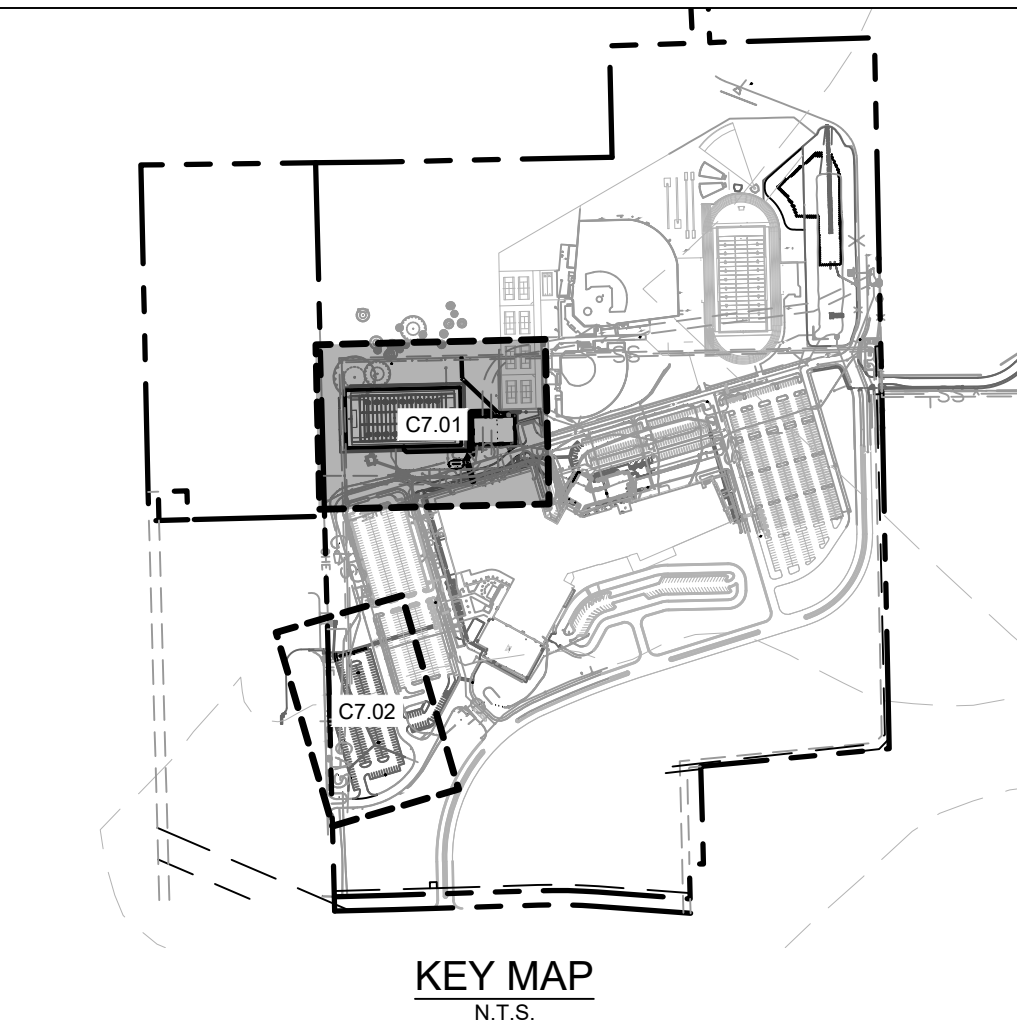

KEY MAP  
N.T.S.



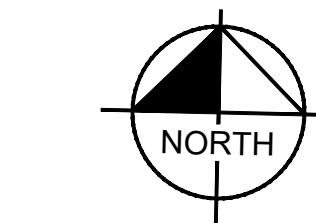


GRAPHIC SCALE IN FEET  
0 15 30 60

LEGEND	
	PROPOSED PROPERTY BOUNDARY
	EXISTING PROPERTY LINE
	PROPOSED EASEMENT
	EXISTING EASEMENT
	PROPOSED RETAINING WALL
	PROPOSED FENCE
	PROPOSED OVERHEAD ELECTRIC
	PROPOSED FIRE WATER LINE
	PROPOSED DOMESTIC WATER LINE
	PROPOSED COMBINATION WATER LINE
	PROPOSED SANITARY SEWER LINE
	PROPOSED STORM DRAIN (<12")
	PROPOSED STORM DRAIN (>=12")
	EXISTING WATERLINE
	EXISTING SANITARY SEWER LINE
	EXISTING GAS LINE
	EXISTING EDGE OF ASPHALT
	EXISTING OVERHEAD ELECTRIC
	PROPOSED CONCRETE RIPRAP
	PROPOSED ROCK RIPRAP
	PROPOSED LIGHT POLE
	PROPOSED SEWER CLEANOUT
	PROPOSED SEWER MANHOLE
	PROPOSED CURB INLET/GRATE INLET
	PROPOSED MANHOLE/JUNCTION BOX
	PROPOSED HEADWALL
	PROPOSED GAS METER
	PROPOSED POWER POLE
	PROPOSED BACKFLOW PREVENTER
	PROPOSED FIRE HYDRANT
	PROPOSED DOMESTIC WATER LINE
	PROPOSED ELECTRIC TRANSFORMER
	EXISTING LIGHT POLE
	EXISTING SIGN
	EXISTING SEWER MANHOLE
	EXISTING POWER POLE
	EXISTING TREE
	EXISTING FIRE HYDRANT
	EXISTING STORM INLET
	CONTRACTOR TO CONNECT DOWNSPOUTS TO PROPOSED STORM LINE B2
	CONTRACTOR TO CONNECT DOWNSPOUTS TO EXISTING 24" HDPE

#### STORM NOTES

- ALL DIMENSIONS ARE TO CENTERLINE OF PIPE UNLESS NOTED OTHERWISE.
- REFERENCE STORM SEWER NOTES ON SHEET C1.00 FOR PIPE MATERIAL REQUIREMENTS.
- REFERENCE SHEET C10.01 FOR STORM SEWER DETAILS.
- CONTRACTOR TO FIELD VERIFY LOCATION OF ALL UTILITIES PRIOR TO CONSTRUCTION. CONTACT ENGINEER IF FIELD CONDITIONS VARY.
- DRAIN BASINS TO BE NYLORLAST OR APPROVED EQUAL.
- CONTRACTOR TO FIELD VERIFY PRIOR TO THE START OF CONSTRUCTION AND NOTIFY ENGINEER IF DIFFERS FROM PLAN.
- TRENCH DRAIN SHALL BE PLACED WITHIN CIVIL FLATWORK AND SHALL BE DISCONNECTED FROM STRUCTURAL SLAB. CONTRACTOR TO USE NOS 3" PRO SERIES OR APPROVED EQUAL AND TIE INTO NEAREST ADJACENT STORM LINE WITH 6" SCHEDULE 40 PVC PIPE.
- WHEN SAWCUTTING EXISTING PAVEMENT, CONTRACTOR SHALL ENSURE A 5' MINIMUM SPACING BETWEEN JOINTS. OTHERWISE, CONTRACTOR SHOULD REMOVE AND REPAIR UP TO THE NEAREST JOINT.

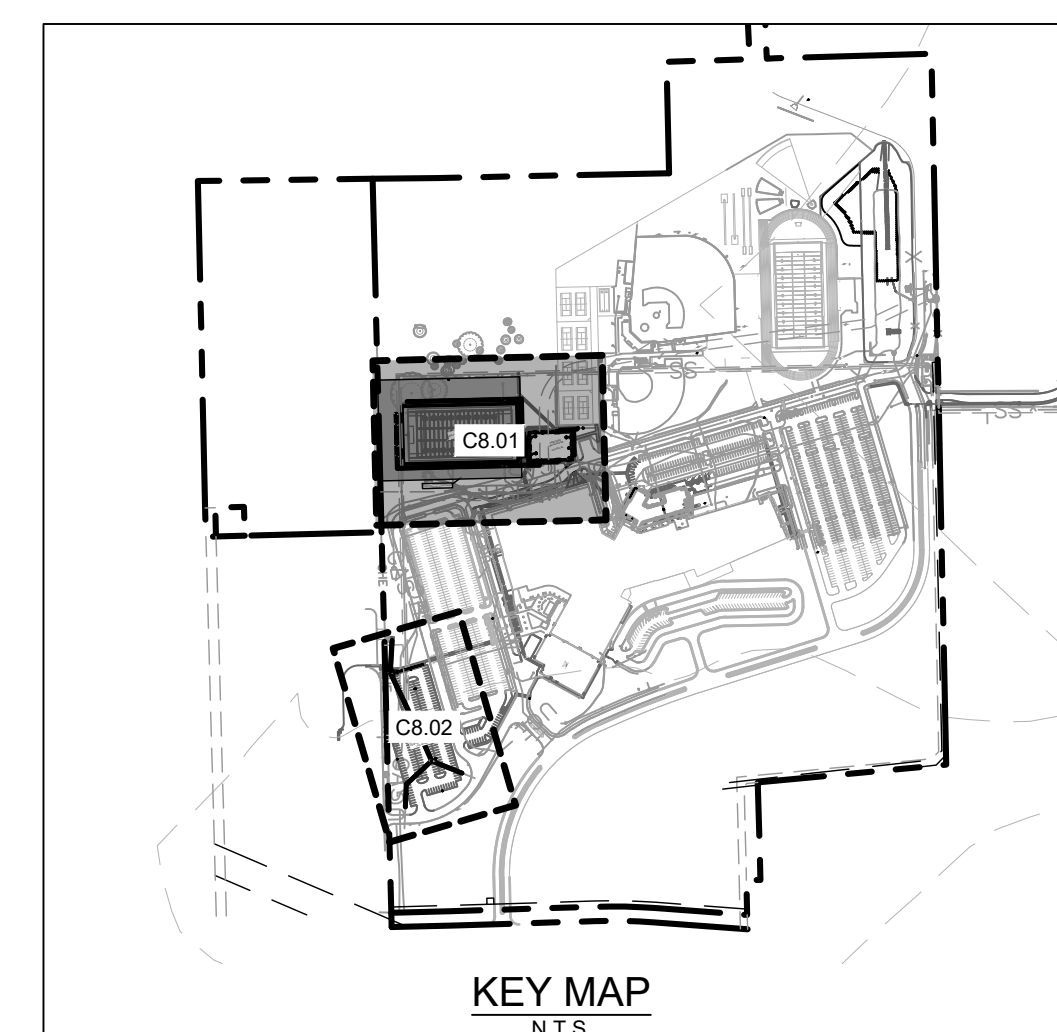

#### BENCHMARK LIST

TBM  
MAGWASHER  
"SOS CONTROL"  
ELEV. = 816.51  
TBM  
MAGWASHER  
"SOS CONTROL"  
ELEV. = 813.61

#### CAUTION!!

EXISTING UNDERGROUND UTILITIES IN THE AREA CONTRACTOR IS RESPONSIBLE FOR DETERMINING THE HORIZONTAL AND VERTICAL LOCATION OF ALL UTILITIES PRIOR TO CONSTRUCTION. CONTRACTOR SHALL BE RESPONSIBLE FOR ANY REPAIRS TO EXISTING UTILITIES DUE TO DAMAGE INCURRED DURING CONSTRUCTION. CONTRACTOR SHALL NOTIFY THE ENGINEER OF ANY DISCREPANCIES ON THE PLANS.

SITE PLAN APPROVAL SHEET 24 OF 46  
FILE NUMBER: APPLICATION DATE: 01/23/2025  
APPROVED BY COMMISSION ON: N/A UNDER THE CITY OF BUDA  
UNIFIED DEVELOPMENT CODE  
EXPIRATION DATE: CASE MANAGER:


City Engineer: City of Buda  
RELEASED FOR GENERAL COMPLIANCE: ZONING AG  
Rev. 1 Correction 1  
Rev. 2 Correction 2  
Rev. 3 Correction 3

Final plat must be recorded by the Project Expiration Date, if applicable. Subsequent Site Plans which do not comply with the Code current at the time of filing, and all required Building Permits and/or a notice of construction (if a building permit is not required), must also be approved prior to the Project Expiration Date.

ALL RESPONSIBILITY FOR THE ADEQUACY OF THESE PLANS REMAINS WITH THE ENGINEER WHO PREPARED THEM. IN REVIEWING THESE PLANS, THE CITY OF BUDA MUST RELY UPON THE ADEQUACY OF THE WORK OF THE DESIGN ENGINEER.

JOHNSON HIGH SCHOOL  
2025 ADDITIONS  
FOR  
HAYS C.I.S.D.  
BUDA, TEXAS

**KimleyHorn**  
© 2025 KIMLEY-HORN AND ASSOCIATES, INC.  
TBP# FIRM NO. 928

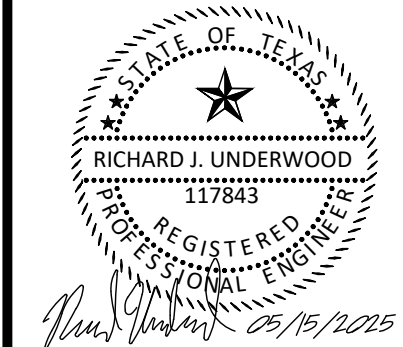

**Huckabee**  
ARCHITECTS • PLANNERS • ENGINEERS  
10000 N. MICHIGAN AVE., SUITE 1000  
DALLAS, TEXAS 75243  
www.huckabee-inc.com  
800.687.0225

STORM PLAN  
(1 OF 2)

PACKAGE VOLUME

Job No. 1554-07-01 Sheet No. C8.01

Issue For Bid

Drawn By: RAU

Date: 05/15/2025


DESIGN PROGRESS REVIEW







Know what's below.  
Call before you dig.

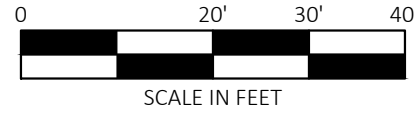

SITE BENCHMARK	
TBM#1	IRON ROD W/ CAP
	"500 CONTROL"
	ELEV. = 814.11
TBM#2	IRON ROD W/ CAP
	"500 CONTROL"
	ELEV. = 812.13

NOTE:  
SEE ARCHITECTURAL PLANS FOR EXACT LOCATIONS AND DIMENSIONS OF PORCHES, RAMPS, VESTIBULE, SLOPED PAVING, TRUCK DOCKS, BUILDING UTILITY ENTRANCE LOCATIONS AND PRECISE BUILDING DIMENSIONS.

#### EXISTING LEGEND

400	CLEANOUT	CHAINLINK FENCE LINE
⚡	FIRE HYDRANT	STORM DRAIN
— —	LIGHT POLE	X"SS SANITARY SEWER
+	SCOREBOARD	X"W WATER
○	TREE	

#### GENERAL NOTES


- A. CONTRACTOR SHALL RE-ESTABLISH DISTURBED GRASS AROUND FIELD WITH COMMON BERMUDA GRASS.
- B. ALL SLOPES AND AREAS DISTURBED BY CONSTRUCTION SHALL BE GRADED SMOOTH AND 4" OF TOPSOIL APPLIED. IF ADEQUATE TOPSOIL IS NOT AVAILABLE ON SITE, THE CONTRACTOR SHALL PROVIDE TOPSOIL, APPROVED BY THE OWNER, AS NEEDED. THE AREA SHALL THEN BE SEED, FERTILIZED, MULCHED, WATERED, AND MAINTAINED UNTIL HARDY GRASS GROWTH IS ESTABLISHED IN ALL AREAS (SEE LANDSCAPE PLAN FOR SEED MIX AND PROPER APPLICATION RATE). ANY AREAS DISTURBED FOR ANY REASON PRIOR TO FINAL ACCEPTANCE OF THE PROJECT SHALL BE CORRECTED BY THE CONTRACTOR AT NO ADDITIONAL COST TO THE OWNER.
- C. ALL DIMENSIONS ARE TAKEN FROM FACE OF CONCRETE AND FACE OF CHAIN LINK FENCE.

#### FIELD AND TURF NOTES

- 70A. INSTALL PADS AT BUILDING COLUMNS AS NOTED ON A4.12 AND A1.1C1. ADD TO SPECIFICATION 32.8450.
- 70G. INSTALL SHOCK PAD AS SPECIFIED BENEATH ENTIRE SYNTHETIC TURF AREA.
- 70H. ALL FOOTBALL FIELD LINES SHALL BE 4 INCH WIDE AND WHITE IN COLOR PER COLOR RENDER.
- 70I. END ZONE LINES SHALL BE 8 INCH WIDE AND WHITE IN COLOR PER COLOR RENDER.
- 70K. BACK OF END ZONE SHALL BE 8 INCH WIDE AND WHITE IN COLOR PER COLOR RENDER.
- 70L. FIELD NUMBERING AND ARROWS SHALL BE SOLID WHITE IN COLOR.
- 70M. BASE PLATES TO BE WHITE INLAID SYNTHETIC TURF.
- 70N. ALL BASEBALL/SOFTBALL FIELD LINES SHALL BE 4 INCH WIDE AND BLUE IN COLOR PER COLOR RENDER.
- 70P. ALL SOCCER FIELD LINES SHALL BE 4 INCH WIDE AND GRAY IN COLOR PER COLOR RENDER.
- 70R. INSTALL TENSION SPORTS NETTING TO BE ATTACHED TO FRAMING OF STEEL STRUCTURE PER SPECIFICATIONS.
- 70S. CONTRACTOR PROVIDE ALLOWANCE FOR FIELD CUSTOMIZATION.
- 70T. INSTALL STANDARD SOCCER GOAL.
- 70U. INSTALL TENSION BATTING CAGE NETTING AS SPECIFIED.
- 70X. INSTALL GREEN SYNTHETIC TURF SYSTEM.
- 70Z. INSTALL ALTERNATING GREEN SYNTHETIC TURF SYSTEM.
- 70DD. INSTALL SPORTS NETTING PER SPECIFICATIONS.
- 70EE. PROPOSED SPORT FIELD COVER, TO BE CONSTRUCTED BY OTHERS AND SHOWN ON THIS PLAN FOR REFERENCE. REFER TO ARCHITECTURAL PLANS FOR FINAL PLACEMENT AND REQUIREMENTS.
- 70FF. INSTALL SOCCER FLAGS AT ALL CORNERS OF FIELD.
- 70GG. CONTRACTOR TO PROVIDE KWIK GOAL PREMIER WEIGHTED MODEL SOCCER FLAG, OR APPROVED EQUAL.

#### FIELD AND TURF DETAIL

- 72C. FOOTBALL FIELD ALTERNATING GREEN
- 91A. GOAL POST WITH PAD INSTALLATION

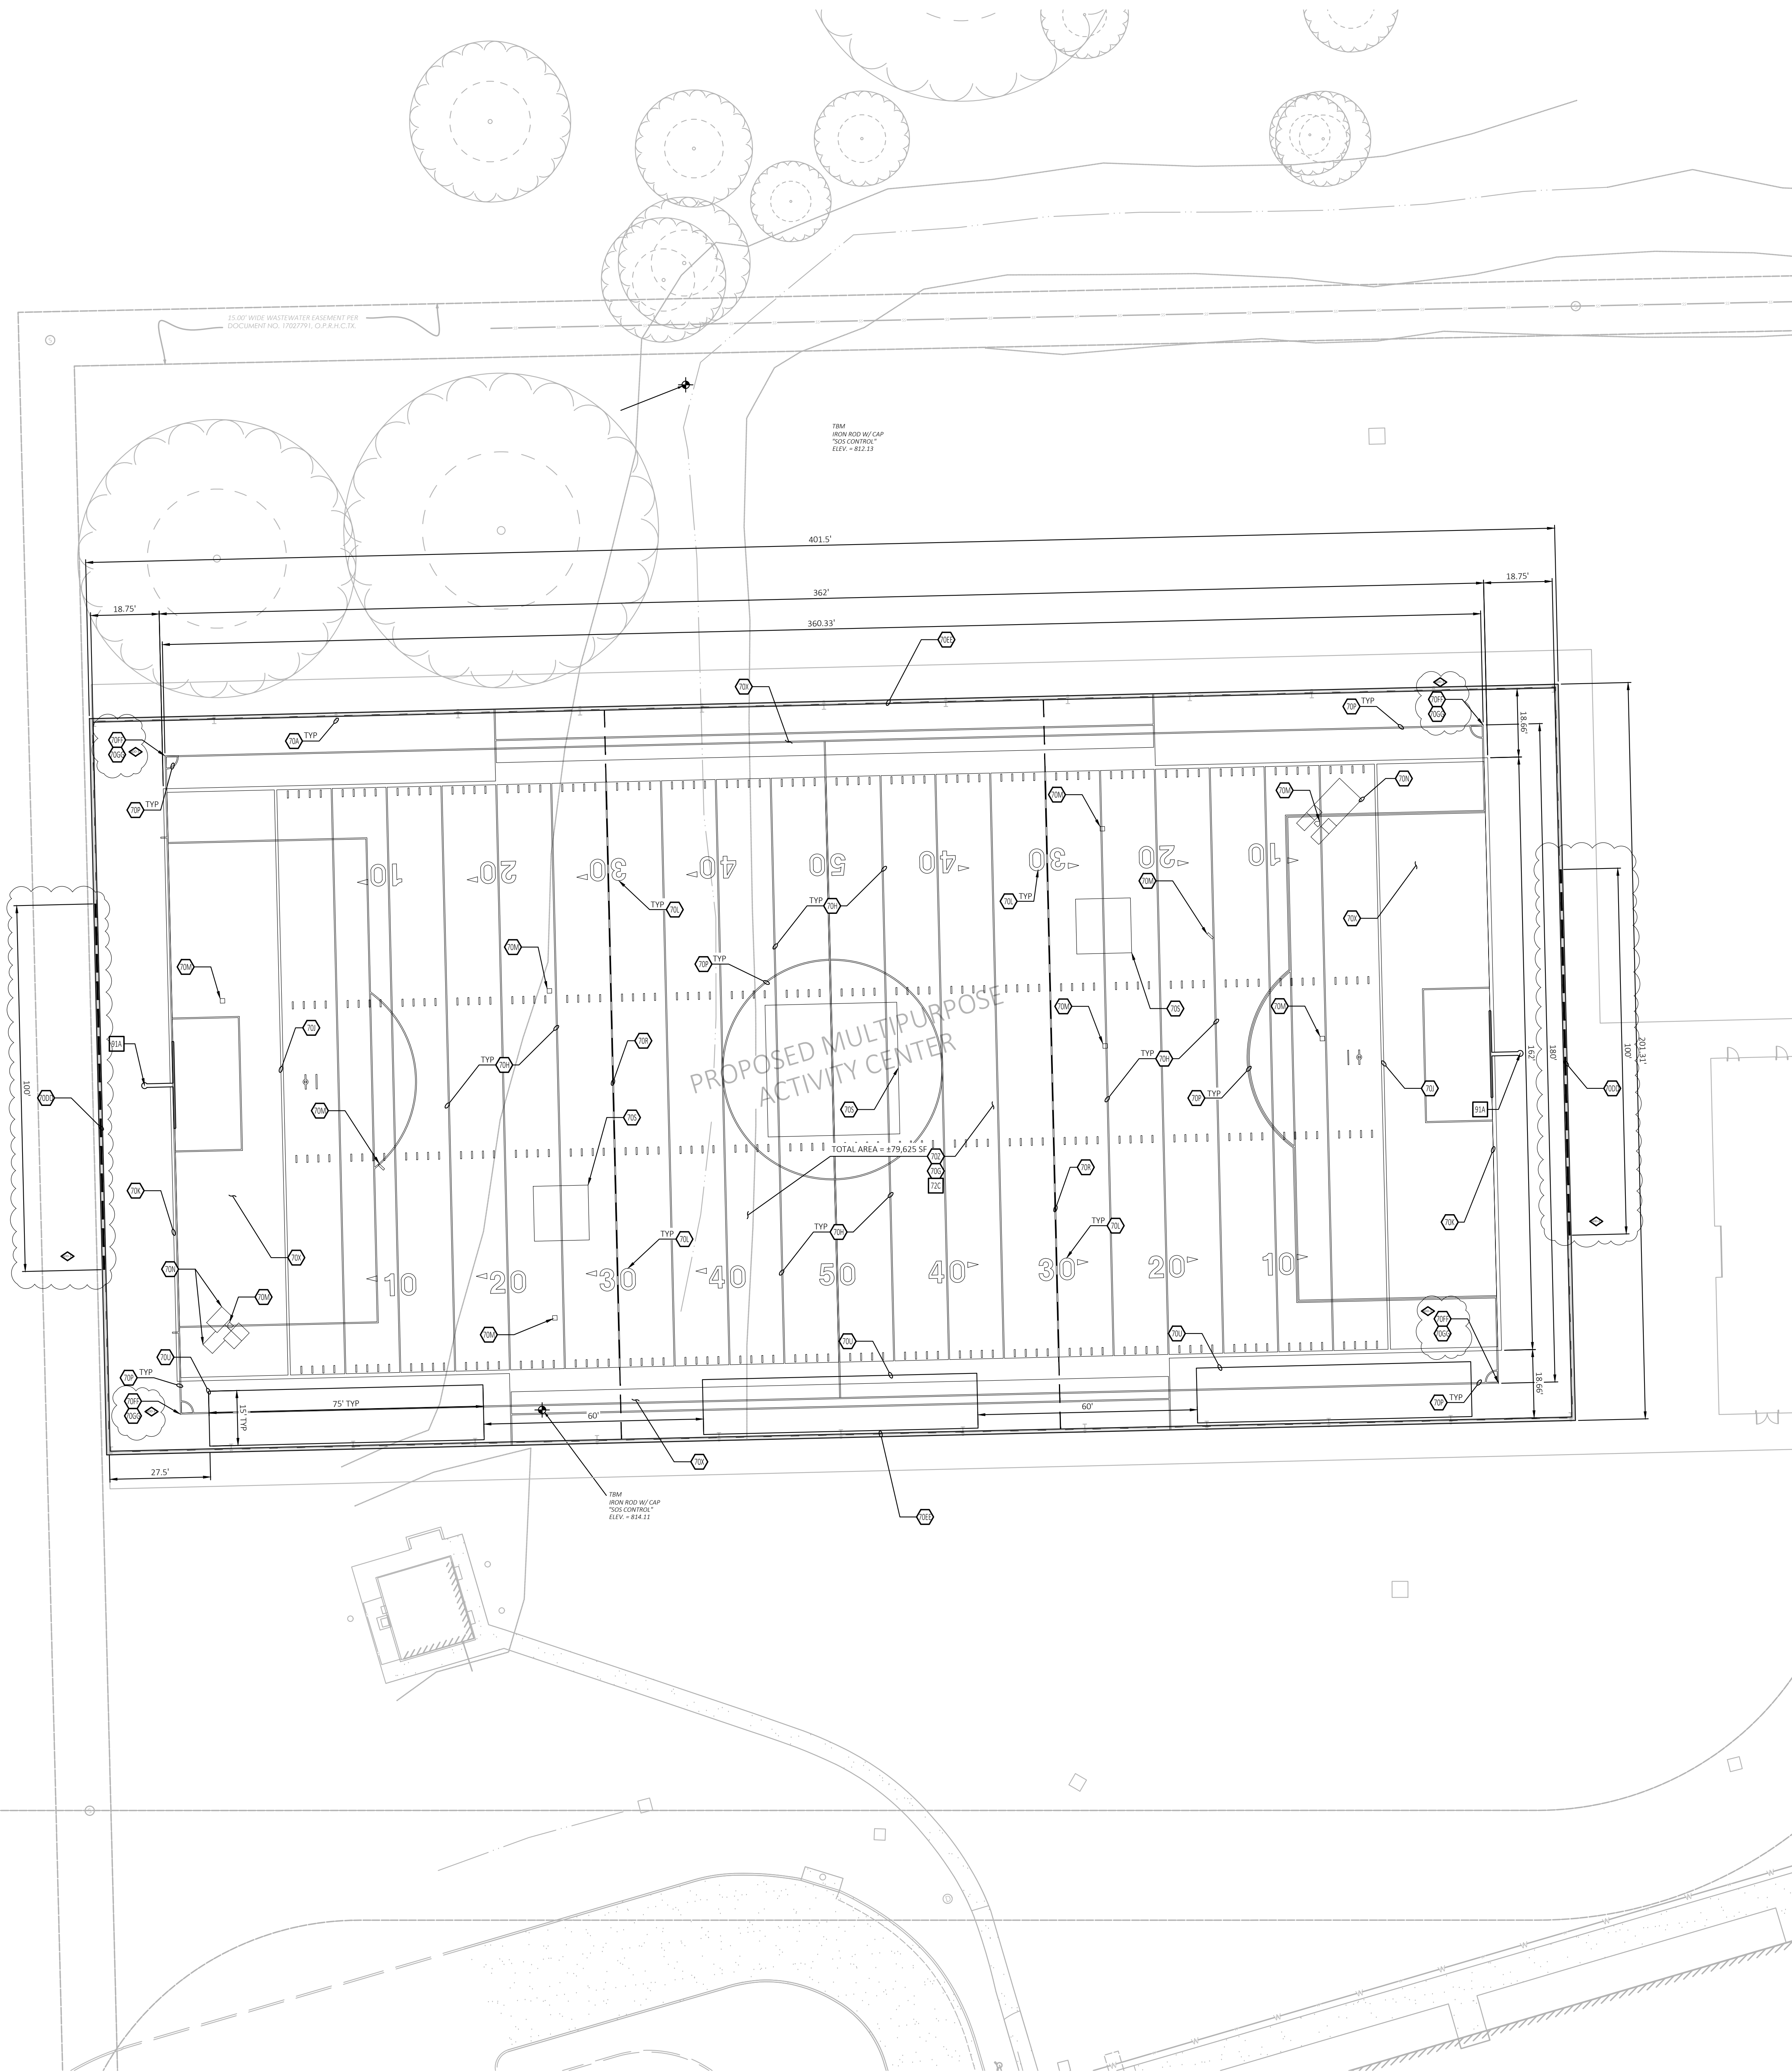

JOHNSON HIGH SCHOOL  
2025 ADDITIONS + RENOVATIONS  
FOR  
HAYS CISD  
BUDA, TX

Project:



F-7524  
JEFFERY J. BRESSEE  
TX 0017

**Huckabee**  
www.huckabee-inc.com  
800.687.1229

SURFACE PLAN  
- ALTERNATE 1

Job No.  
34208  
Drawn By:  
MDT  
Date:  
05/20/2025  
Sheet No.  
100% CD  
F1

PROJECT RELEASE TYPE



# GENERAL NOTES

Copyright © 2024, Huckabee & Associates, Inc.

## SECTION 4 - STRUCTURAL MASONRY

### SECTION 4.1- GENERAL

- 4.1.1 See Architectural Drawings and Specifications for details and dimensions of masonry work.
- 4.1.2 Grout lifts at reinforced masonry walls shall be accomplished in accordance with TMS 402/602.

### SECTION 4.2- STRUCTURAL PROPERTIES

- 4.2.1 Required compressive strength of structural assembly = 2000 psi
- 4.2.2 Load-bearing Concrete Masonry Units: ASTM C90 Normal-weight Required net area compressive strength = 2000 psi
- 4.2.3 Mortar: ASTM C270 Type S
- 4.2.4 Grout: ASTM C476  
Required 28-day compressive strength of grout 2000 psi

### SECTION 4.3- REINFORCING

#### JOINT REINFORCEMENT

- 4.3.1 Horizontal joint reinforcing shall be "Ladder Type" 9 gage welded wires spaced 16 inches on center vertically.
- 4.3.2 Provide prefabricated 'L' and 'T' shaped sections at wall intersections.
- 4.3.3 Lap horizontal wires at least 9' at splices.

#### BAR REINFORCEMENT

- 4.3.4 Reinforcing bars shall conform to ASTM A615 Grade 60.
- 4.3.5 Bar reinforcing shall be lapped at splices per schedule in typical details. Stagger splices in adjacent horizontal bars at least 4'-0".
- 4.3.6 Vertical reinforcing in cells to be grouted shall be placed using fabricated bar positioners to maintain location within cell.
- 4.3.7 Grout solid cells below adjacent grade or finish floor elevation and cells with vertical or horizontal bar reinforcement.

#### STRUCTURAL WALLS

- 4.3.8 Unless shown otherwise on plans or details, reinforcing for load-bearing CMU walls shown in the structural drawings shall be as follows:

Wall Type	Wall Thickness	Vert Reinf	Dowels
W1	12 inches	2 #5 @ 24 max	2 #5(0-10/4-0) @ 24 max

#### Notes:

- a) Structural Walls are to be W1 type unless otherwise noted.
- b) Align and lap dowels with vertical wall reinforcing.
- c) At wall openings, see wall opening reinforcing schedule in typical details for reinforcing of jambs and lintels.

#### NON-STRUCTURAL WALLS

- 4.3.9 Unless shown otherwise on plans or details, reinforcing for CMU walls not shown in the structural drawings shall be as follows:

Wall Thickness	Vert Reinf	Dowels
8 inches	1 #5 @ 32 max	1 #5(0-10/4-0) @ 32 max
12 inches	2 #5 @ 32 max	2 #5(0-10/4-0) @ 32 max

#### Notes:

- a) Align and lap dowels with vertical wall reinforcing.
- b) At wall openings, see wall opening reinforcing schedule in typical details for reinforcing of jambs and lintels.
- c) Post-installed dowels are acceptable at non-structural CMU. Drill & embed dowels 9 bar diameters minimum with adhesive.

- 4.3.10 Grout and reinforce the first cell at corners, ends of walls, and each side of a control joint with 1 vertical bar for 6- or 8-inch CMU walls or 2 vertical bars for 12-inch CMU walls. Jambs adjacent to openings in structural masonry are to be grouted and reinforced per applicable details.

- 4.3.11 Install single course depth bond beam with at least one horizontal bar at the top of CMU walls.

### SECTION 4.4- CONTROL JOINTS

- 4.4.1 Do not locate vertical control joints in CMU walls through an opening or within the jamb or lintel bearing adjacent to an opening. Control joints must be vertical from the wall foundation to the top of wall.
- 4.4.2 Maximum spacing of control joints not to exceed 25 feet.
- 4.4.3 See plans for control joint locations in load-bearing CMU walls.

### SECTION 4.5- REQUIRED SUBMITTALS

- 4.5.1 Prior to construction, contractor is to submit CMU reinforcing layout and fabrication drawings for review. Submittal shall contain the following information:
- a) CMU wall thickness
- b) Material properties
- c) Plans and wall elevations that show wall reinforcing details, openings, beam pockets, and lintels
- d) Control joint locations

## SECTION 5 - STRUCTURAL STEEL

### SECTION 5.1- STRUCTURAL FRAME

- 5.1.1 Structural Steel Properties:
- |   |                                |
|---|--------------------------------|
| High Strength Steel                       | ASTM A992 Grade 50             |
| Use for W Shapes and WT's                 |                                |
| Structural Steel (Normal Strength)        | ASTM A36                       |
| Use for Angles, Channels, and Plates, UNO |                                |
| Steel Pipes                               | ASTM A53, Grade B              |
| Hollow Structural Sections (HSS)          | ASTM A500, Grade C             |
| Erection Bolts                            | ASTM A307                      |
| High Strength Bolts                       | ASTM F3125, A325N UNO          |
| Anchor Rods                               | ASTM F1554 Gr. 36 UNO          |
| Headed Stud Anchors                       | ASTM A29 Gr. 1010-1020, Type B |
- 5.1.2 Continuity Plates (Full Depth column stiffeners aligned with beam flanges, or Full Depth beam stiffeners aligned with column flanges) shall match the steel grade of the base member.

#### WELDING

- 5.1.3 Unless otherwise noted, angles, plates, rods, and miscellaneous framing shall be welded at contact joints and supports. Weld sizes shall conform to AWS D1.1 minimums, except where noted otherwise.
- 5.1.4 Where fillet weld sizes are not indicated on weld symbols, fillet size shall be 1/16th inch smaller than thickness of thinner of materials being joined.
- 5.1.5 Complete penetration welds are indicated by notation "CJP" on weld symbols, partial penetration by "PJP".

#### STRUCTURAL BOLTS

- 5.1.6 Bolts indicated on details shall be 3/4 inch diameter, unless noted otherwise.
- 5.1.7 Bolts shall be tightened by the AISC "Snug Tight" method unless noted otherwise.

## MISCELLANEOUS

- 5.1.8 Edge angles at perimeters of floors and roofs shall be continuous and spliced per typical details.
- 5.1.9 Steel members shown to be curved shall be rolled in a manner that will not cause distortion or buckling. Should alterations to the member size, such as a thicker flange or web, be required to ensure this outcome, the additional steel shall be provided at no additional cost to the contract.
- 5.1.10 Unless noted otherwise, steel members shall be hot dip galvanized at exterior conditions. Field welds to be repaired in accordance with ASTM A780.
- COMPOSITE STEEL BEAMS
- 5.1.11 Beams shall have shear studs spaced at 2 feet maximum on center, whether shown or not.
- 5.1.12 Composite steel beams do not require shoring during placement of concrete slab, unless noted otherwise.
- SHEAR STUDS
- 5.1.13 Shear studs shall be fusion-welded, headed studs of high strength steel.
- 5.1.14 Unless noted otherwise, studs shall have a shank diameter of 3/4-inch. See details for length of studs measured after welding.

### SECTION 5.2- STEEL JOISTS AND JOIST GIRDERS

- 5.2.1 Joist Legend:
- |       |   |
|-------|---|
| 22K6  | - SJI K-SERIES JOIST.                   |
| 22KCS | - SJI KCS-SERIES JOIST.                 |
| 24LH8 | - SJI LH-SERIES JOIST.                  |
| 22KSP | - SPECIAL DESIGN FOR SPECIFIED LOADING. |
- 5.2.2 Unless noted or detailed otherwise, typical seat depths shall be:
- |                  |                |
|------------------|----------------|
| K or KCS Series  | - 2-1/2 inches |
| LH or DLH Series | - 5 inches     |
| G Series         | - 7-1/2 inches |
- 5.2.3 Joists and Joist Girders shall be designed for concentrated dead or live load in addition to required uniform dead and live loads, as follows at top and bottom chords:
- Joists: 250 lb. placed at any panel point.
- Joist Girders: 500 lb. placed at any panel point.
- 5.2.4 Design joists supporting mechanical units to support a concentrated load equal to 60% of the weight shown on plan at any joist panel point. Design joists supporting more than one mechanical unit to support a concentrated load equal to 60% of the sum of the weights shown on plan at any joist panel point. These concentrated loads are in addition to the loads noted above.
- 5.2.5 See loading diagram for net uplift requirements due to wind load.
- 5.2.6 Joist loads shown on drawings are nominal loads per building code and have not been multiplied by ASD (Allowable) nor LRFD (Strength) load multipliers unless specifically noted otherwise.
- 5.2.7 Deflection shall not exceed L/240 for total load or L/360 for short term loads (live, snow, or wind).

### SECTION 5.5- STEEL ROOF DECK

- 5.5.1 Steel Roof Deck Schedule:
- a. Deck shall be Type RA unless shown otherwise on plans.
- b. Typical deck yield strength: Fy = 40 ksi minimum
- | Deck Type | Deck Mark | Deck SDI | Deck Gage Profile Height | Min. Ip | Min. In | Min. Sp | Min. Sn | Deck In4 | Deck In4 | Deck In3 | Deck Finish |
|-----------|-----------|----------|--------------------------|---------|---------|---------|---------|----------|----------|----------|-------------|
| RA        | 20        | WR       | 1.5"                     | .177    | .213    | .212    | .223    | G-60     |          |          |             |
- 5.5.2 Steel Roof Deck Connection Schedule:
- a. Shear Capacity listed is allowable (0.6W, 0.7E) and is considered acting in combination with wind uplift pressures.
- b. W/N = sheet width/no. connections each sheet.
- c. Deck Connections are Mark I, except where noted otherwise on Plans.
- d. In addition to the deck connections indicated in the connection schedule, the deck shall be connected at each flute at each support within the first 14 feet from the building perimeter.

Conn Type Mark	Conn # (W/N)	Parallel Edges (In)	Sidelap Conn No./Span	Reqd Shear Capacity (PLF)
I	36/7	6	4	457 @ 6'-0" span

## SECTION 6 - DEFERRED APPROVALS

- 6.1.1 The following items require deferred approval from the enforcement agency. See specifications for additional design services to be provided by Contractor.
1. Cold formed metal framing
  2. Stairs and railings
  3. Steel connection design
  4. Pre-engineered Metal Building (PEMB)
  5. Underslab grout retaining walls for Mudskipper system.
- 6.1.2 The design of the above items is by the Contractor/Manufacturer. Contractor/Manufacturer must prepare all necessary calculations and drawings per the Building Code of Jurisdiction under the supervision of a Structural Engineer, registered in the state in which the project is located, and obtain all necessary plan check approvals from the enforcement agency.
- 6.1.3 Fabrication and installation of the above items shall not be started until detailed plans, specifications and engineering calculations have been accepted and signed by the Architect or Structural Engineer of Record and the signature of the Architect or Professional Engineer who has been delegated responsibility covering the work shown on a particular plan or specification, and approved by the enforcement agency.
- 6.1.4 Submittal documents for deferred items shall be submitted to the registered design professional in responsible charge, who shall review them and forward them to the building official with a notation indicating that the deferred documents have been reviewed and that they have been found to be in general conformance with the design of the building. The deferred items shall NOT be installed until their design and submittal documents have been approved by the building official.

## SECTION 7 - METAL BUILDING SYSTEMS

### SECTION 7.1- GENERAL DESIGN REQUIREMENTS

- 7.1.1 Superstructure is metal building system designed and fabricated by supplier and associated structural engineer.
- 7.1.2 Design and fabricate metal building in accordance with the contract documents, AISC, MBMA, AWS, and AISI specifications. Abide by AWS dimensional tolerances for workmanship and AISC fabrication tolerances for hot-rolled steel.
- 7.1.3 Submit documentation of participation in AISC Quality Certification Program and be designated as an AISC Certified Plant, Category BU, or accreditation with IAS AC 472.
- 7.1.4 Design metal building to support equipment shown or specified in contract documents. Provide additional girts or purlins as required for attachment of equipment.
- 7.1.5 Support cladding and openings from metal building system. Coordinate with Architectural documents for finishes and openings.
- 7.1.6 Limit maximum drift and deflection per criteria below:
- |                                   |         |
|-----------------------------------|---------|
| Structure Risk Category           | III     |
| Ultimate design wind speed, Vult  | 115 mph |
| Allowable design wind speed, Vasd | 89 mph  |
| Serviceability wind speed         | 72 mph  |
| Exposure Classification           | C       |
| Building Frame Drift              | H/300   |
| Wall Girts                        | L/240   |
| Roof Purlins                      | L/240   |
- 7.1.7 Locate columns, rigid frames, portal frames, and bracing as shown in contract documents.


### SECTION 7.2- FOUNDATION INTERACTION

- 7.2.1 Foundation elements shown in structural drawings are based on assumed configurations and loading and are subject to change. Submit signed and sealed drawings and calculations (including foundation reactions) for metal building system to Architect for review of foundation design prior to start of construction.
- 7.2.2 Basis of foundation design is a pinned connection at base of frame columns with no moments transferred to foundation.
- 7.2.3 Anchor rod designs for the frame reactions furnished by the metal building designer are a delegated design by a professional engineer. Submit anchor rod design including size, grade, configuration, embedment into concrete, and additional required anchorage reinforcement and supporting calculations for review prior to metal building fabrication.

COMPONENTS AND CLADDING WIND PRESSURES													
ZONE	DESCRIPTION	POSITIVE PRESSURE (PSF)					NEGATIVE PRESSURE (PSF)					PARAPET PRESSURE (PSF)	
		EFFECTIVE AREA (SQ FT)					EFFECTIVE AREA (SQ FT)					10 SQ FT EFFECTIVE AREA	
		10	20	50	100	200	500	10	20	50	100	200	500
		16	16	16	16	16	16	-28	-28	-28	-28	-24	-19
1'	ROOF INTERIOR	16	16	16	16	16	16	-48	-46	-41	-38	-35	-31
1	ROOF MIDDLE	16	16	16	16	16	16	-64	-60	-55	-51	-46	-41
2	ROOF EDGE	16	16	16	16	16	16	-88	-79	-68	-60	-52	-41
3	ROOF CORNER	16	16	16	16	16	16	-28	-27	-25	-24	-23	-23
4	WALL INTERIOR	28	27	25	24	23	21	-30	-29	-27	-26	-25	-23
5	WALL EDGE	28	27	25	24	23	21	-37	-35	-32	-29	-27	-23

#### NOTES:

1. PRESSURES ARE BASED ON THE ULTIMATE DESIGN WIND SPEED,  $V_{ult}$ , AT A MEAN ROOF HEIGHT  $h = 20$  ft.
2. PRESSURES INCLUDE A DIRECTIONALITY FACTOR,  $K_d$ , OF 0.85 AND AN ELEVATION FACTOR,  $K_e$ , OF 1.0
3. LOADS INDICATED ABOVE ARE ULTIMATE WIND LOADS (1.0W) FOR USE IN APPLICABLE WIND LOAD COMBINATIONS CONSIDERING GRAVITY EFFECTS AS REQUIRED PER ASCE 7-16 SECTION 2.3
4. WIND LOADS ACT ON EACH OUTSIDE FACE OF THE BUILDING. DO NOT ASSUME SHIELDING FROM ADJACENT STRUCTURES. POSITIVE AND NEGATIVE VALUES INDICATE PRESSURES ACTING TOWARD AND AWAY FROM SURFACES, RESPECTIVELY.
5. SEE ADJACENT DIAGRAMS FOR LOCATIONS OF ROOF AND WALL ZONES.
6. PARAPET DESIGN PRESSURES: CONSIDER BOTH CASES BELOW:  
CASE A: POSITIVE WALL PRESSURE APPLIED TO WINDWARD SURFACE +  
NEGATIVE ADJACENT EDGE OR CORNER ZONE ROOF PRESSURE APPLIED TO LEEWARD SURFACE  
CASE B: POSITIVE WALL PRESSURE APPLIED TO WINDWARD SURFACE +  
NEGATIVE WALL PRESSURE APPLIED TO LEEWARD SURFACE
7. WHERE PARAPET HEIGHT IS EQUAL TO OR GREATER THAN 3'-0", NEGATIVE ROOF ZONE 3 PRESSURES EQUAL THOSE FOR ZONE 2, AND POSITIVE ROOF ZONES 2 AND 3 PRESSURES EQUAL THOSE FOR POSITIVE WALL ZONES 4 AND 5, RESPECTIVELY.
8. JOIST MANUFACTURER: DESIGN ROOF MEMBERS TO RESIST NET UPLIFT WIND PRESSURE USING THE FOLLOWING ASD FORMULA:  $0.6D - 0.6W$ , WHERE  $D = 11$  PSF AND  $W =$  TABULATED VALUES.

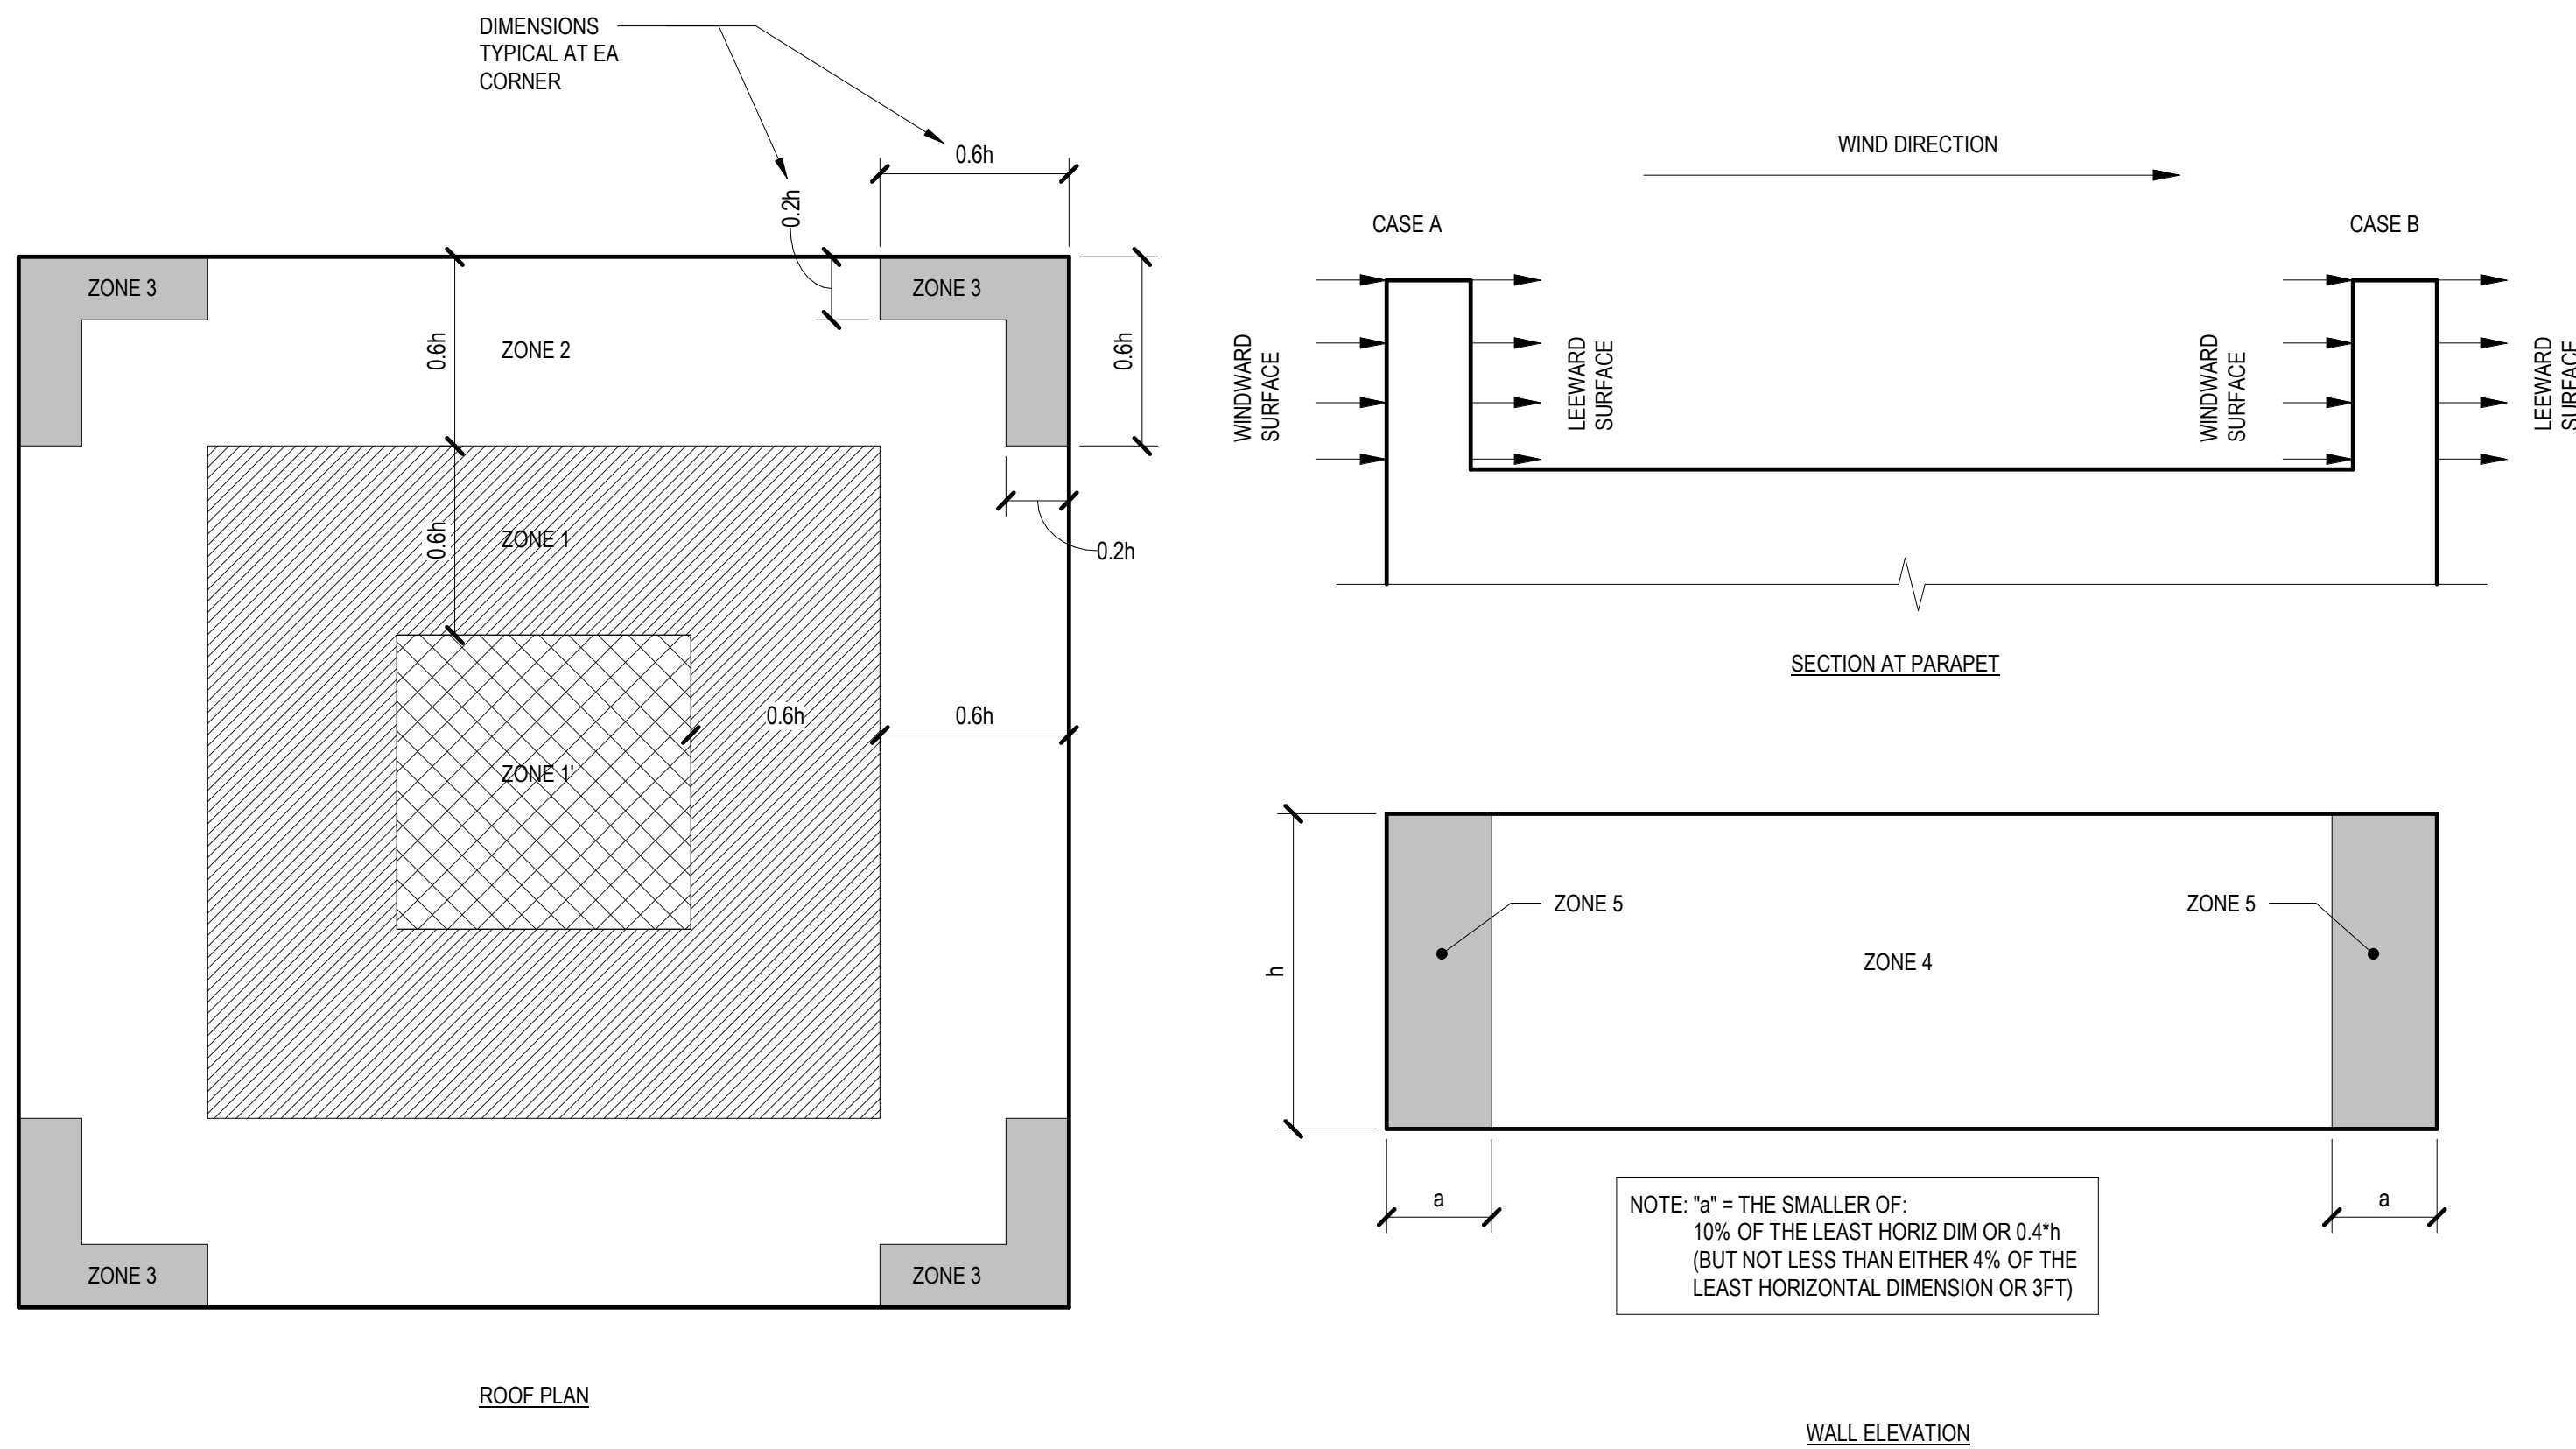

## COMPONENTS & CLADDING WIND PRESSURES - ASCE 7-16 C&C TABLE

1

18" = 1'-0"

ADDENDUM 03

Date 05/15/25

Revision / 1

JOHNSON HIGH SCHOOL  
2025 ADDITIONS  
FOR  
HAYS CISD  
BUDA, TX


Project:



Huckabee  
www.huckabee-inc.com  
800.887.1229

## GENERAL NOTES

PACKAGE	VOLUME
Job No. 1954-07-01	Sheet No.
Drawn By: LAFF	ISSUE FOR BID
Date: 04/22/2025	S1.2

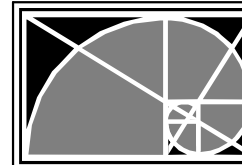

L.A. FUSS PARTNERS, INC.  
Structural Engineers  
3333 Lee Parkway, Suite 300 • Dallas, TX 75219  
LAFF PROJ. NO. 24080 FIRM REG. NO. F-537




JOHNSON HIGH SCHOOL  
2025 ADDITIONS  
FOR  
HAYS CISD  
BUDA, TX


**Huckabee**  
www.huckabee-inc.com  
800.687.1229

FOUNDATION PLAN - AREA A

<b>PACKAGE</b>	<b>VOLUME</b>
b No. 54-07-01 Drawn By: AFP Date: 1/22/2025	Sheet No. ISSUE FOR BID <b>S2.1A1</b>

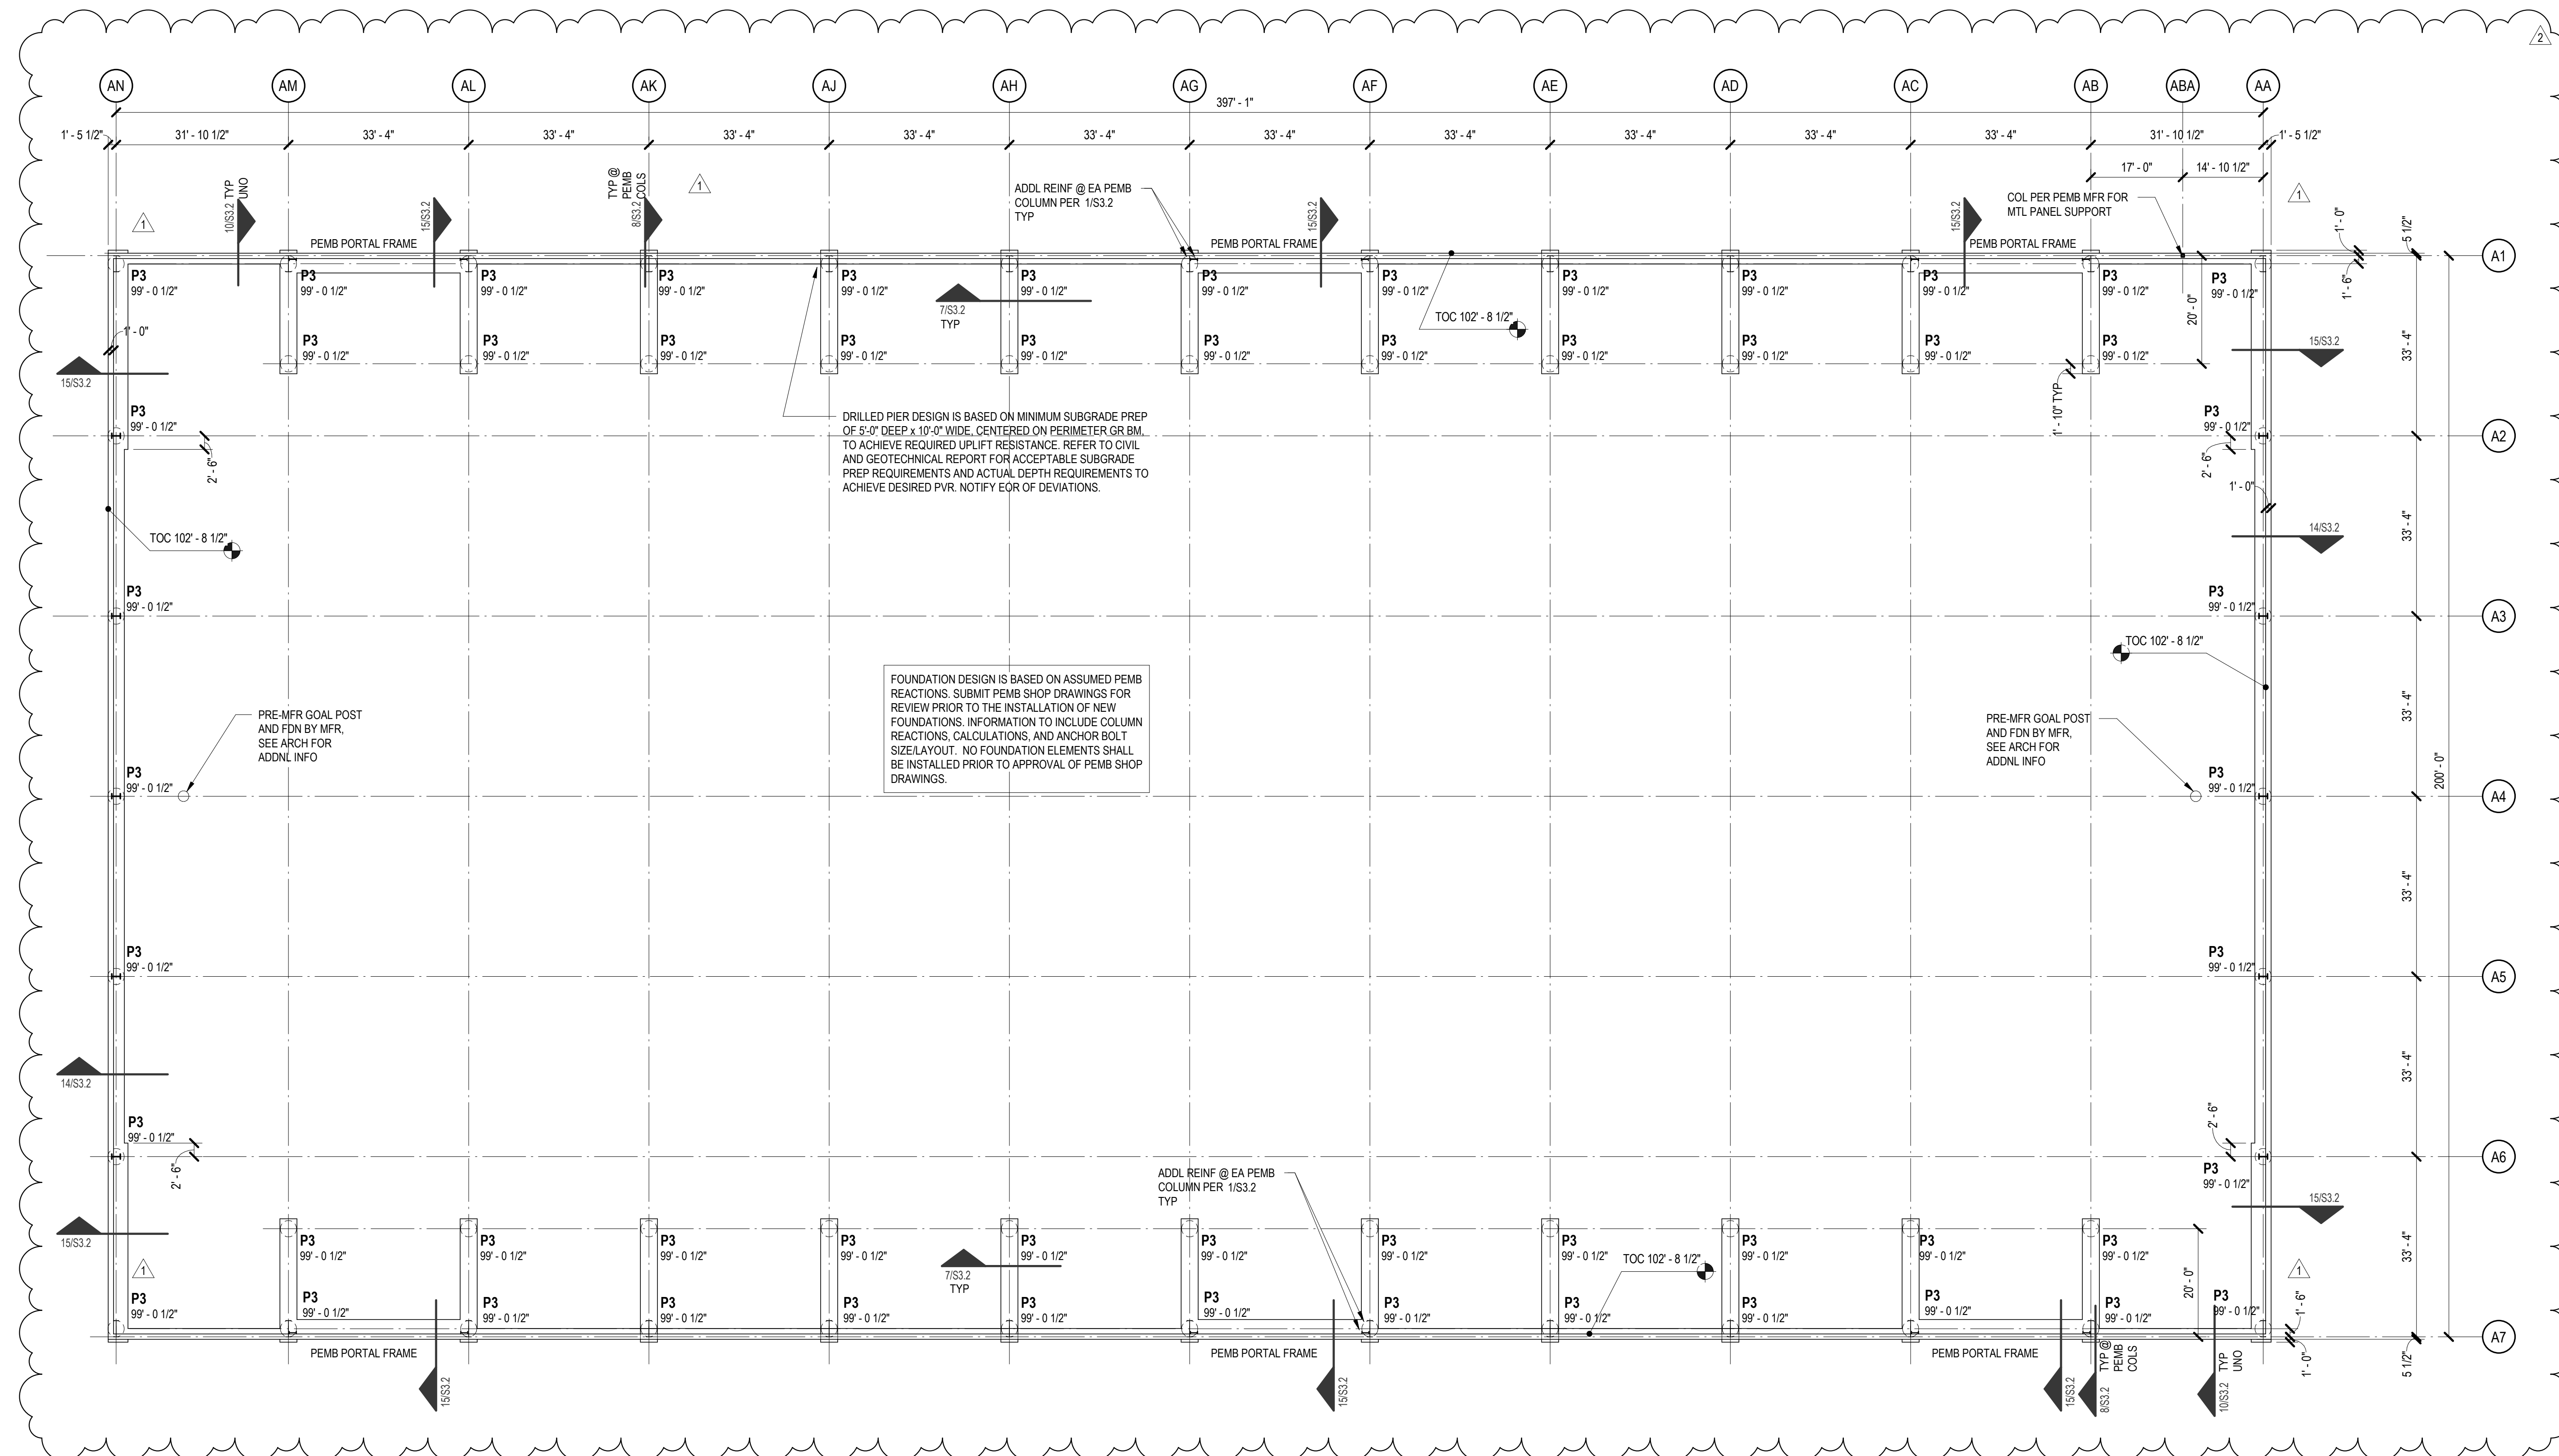

## 1 FOUNDATION PLAN - AREA A

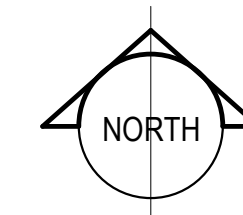
$$1/16'' = 1'-0''$$


## FOUNDATION PLAN NOTES


1. SEE PLAN FOR FINISH FLOOR ELEVATION (RELATIVE TO DATUM 100'-0").
2. TOP OF PIER ELEVATION RELATIVE TO DATUM 100'-0".
3. SHEET INDEX:

SHEET INDEX:

GENERAL NOTES	-S1.1
PIER SCHEDULE	-S3.1
CONCRETE DETAILS	-S3 SERIES

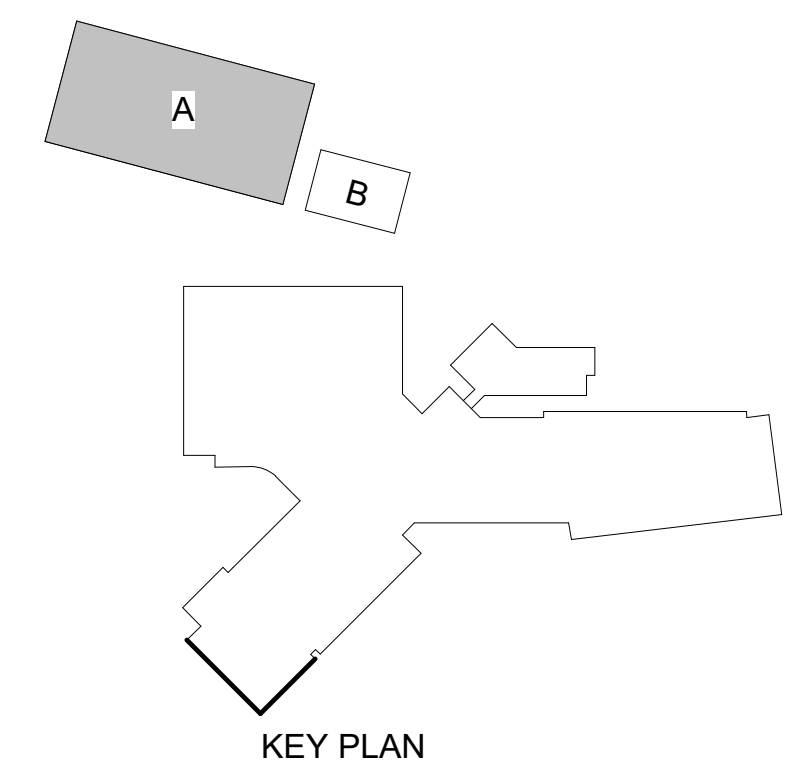


### KEY PLAN

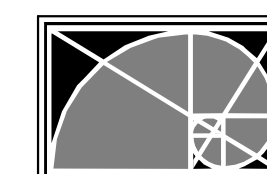

**L.A. FUESS PARTNERS, INC.**  
Structural Engineers  
3333 Lee Parkway, Suite 300 • Dallas, TX 75219  
LAFP PROJ. NO. 24080 FIRM REG. NO. E-537

LAFP PROJ. NO. 24080 FIRM REG. NO. F-537




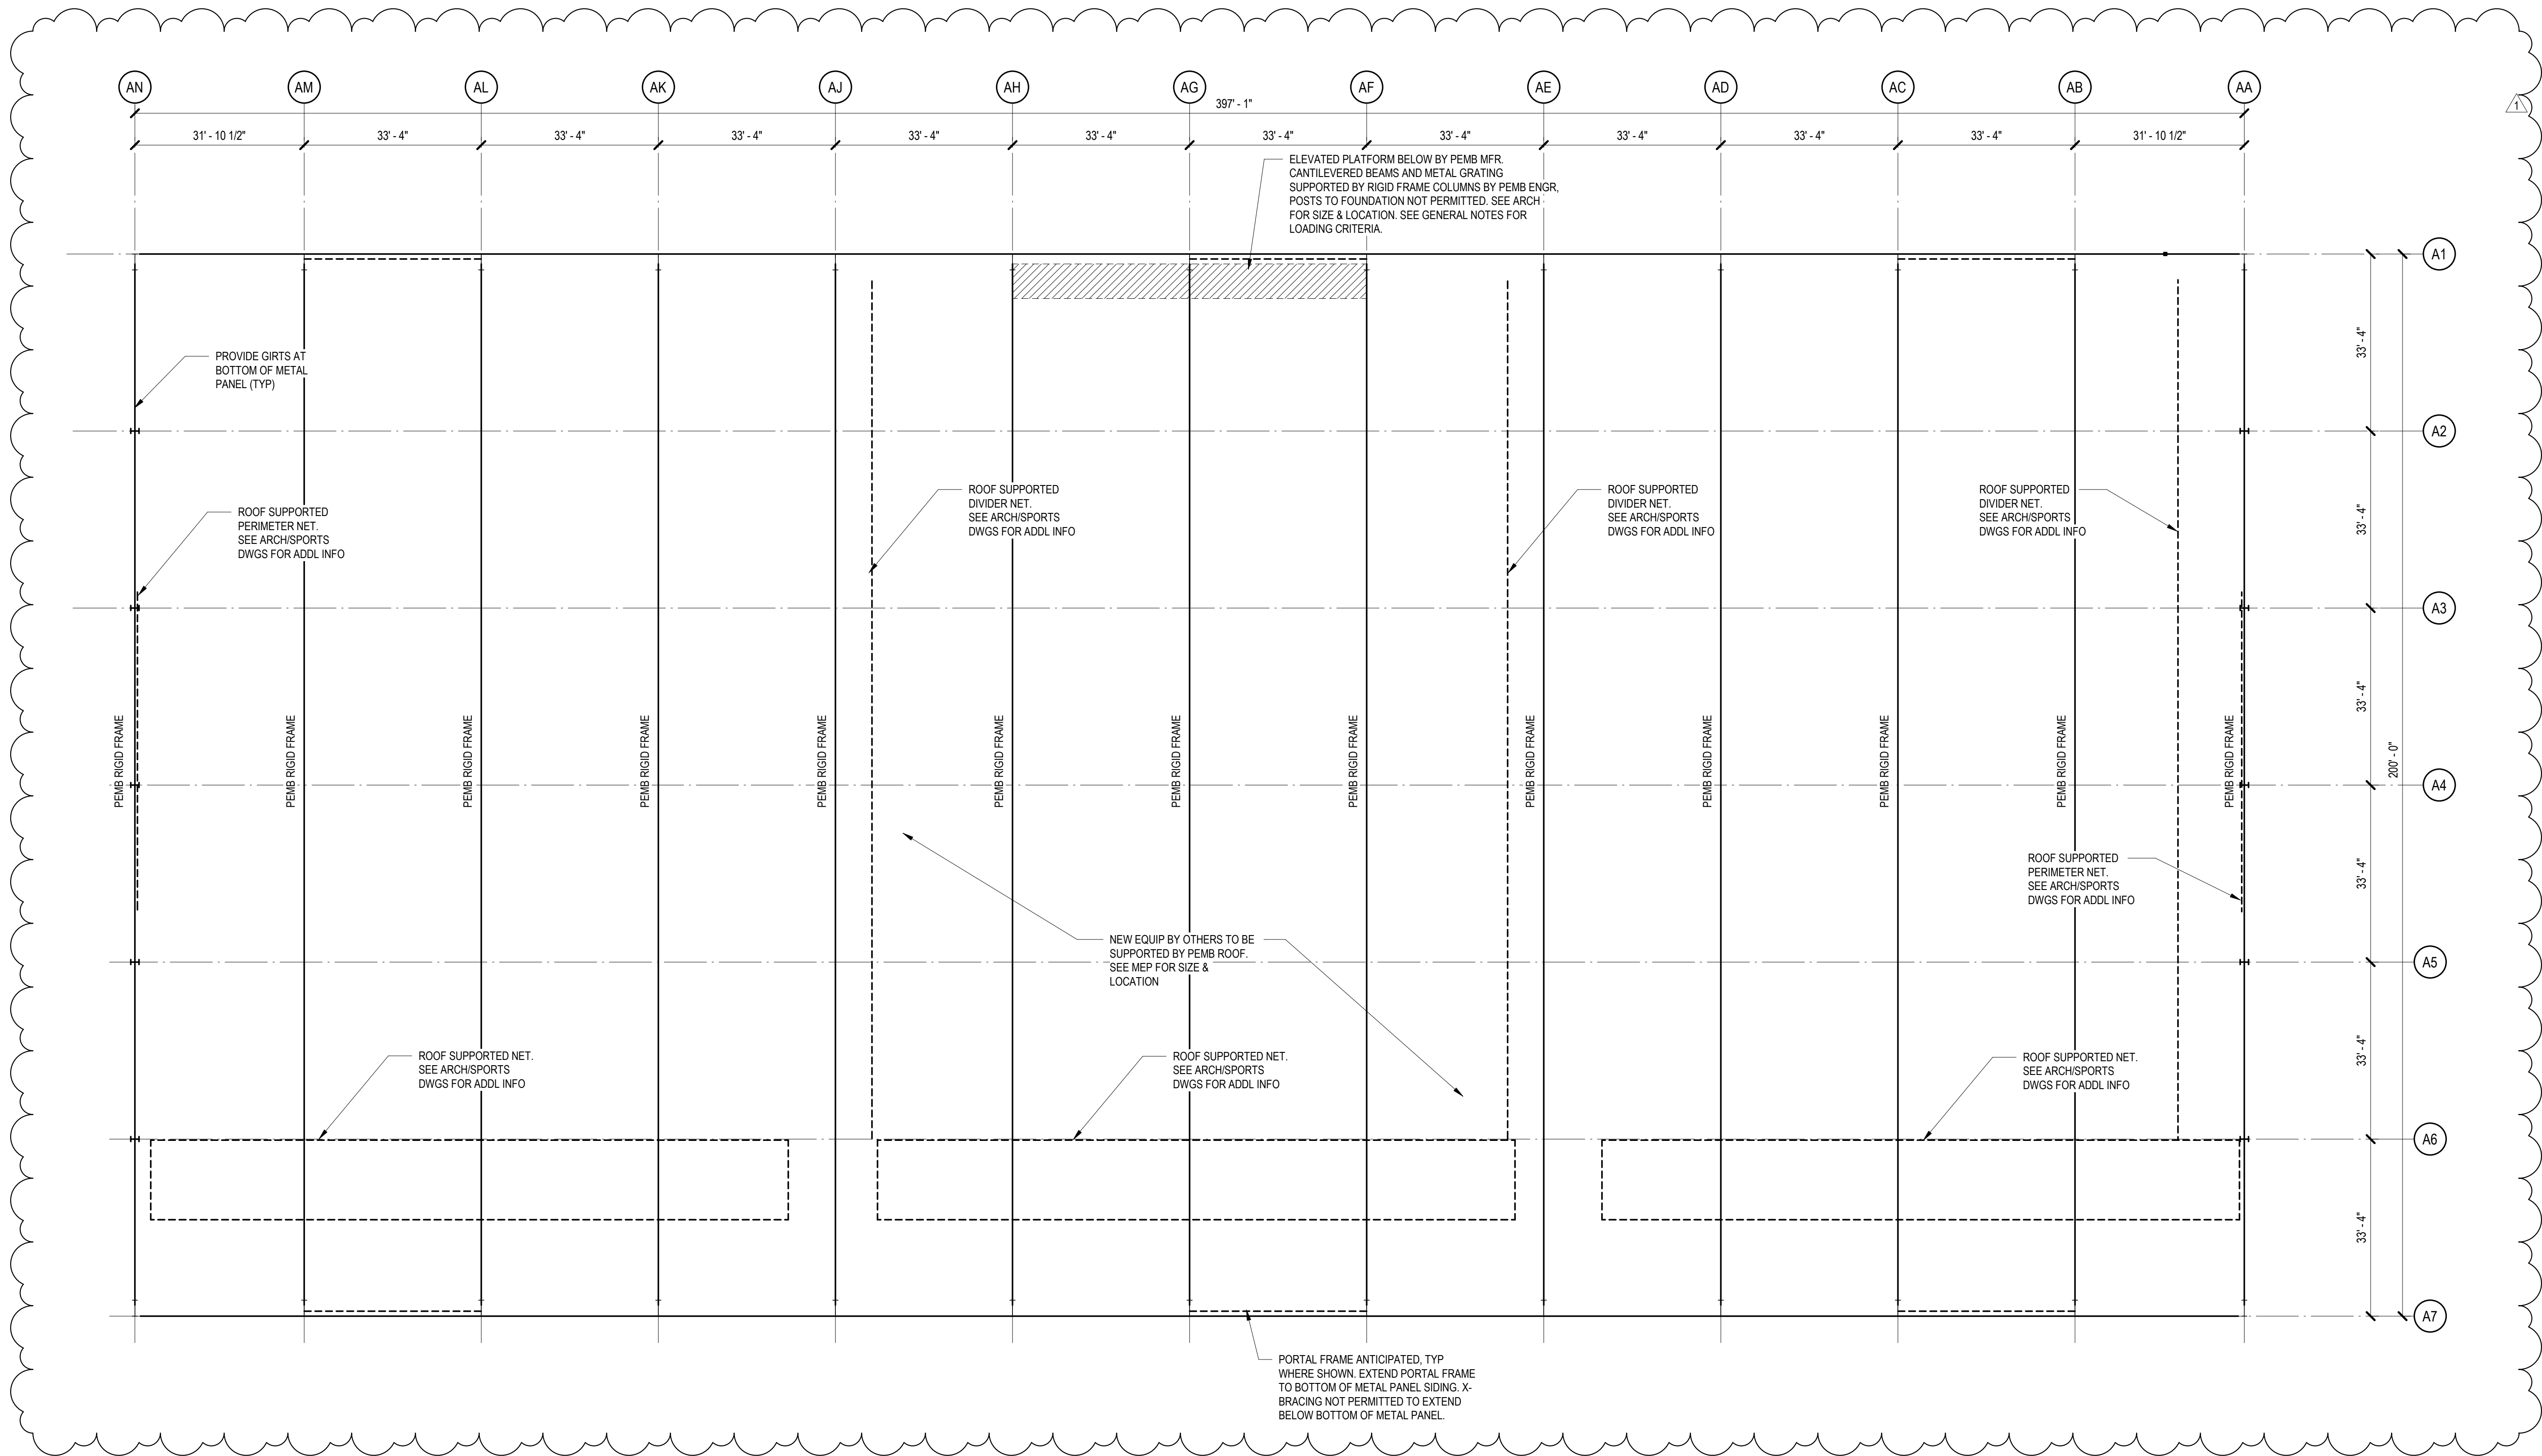


# 1 ROOF FRAMING PLAN - AREA A

1/16" = 1'-0"

## PEMB PLAN NOTES

- PEMB SUPPLIER SHALL BE RESPONSIBLE FOR THE ENTIRE DESIGN OF THE STEEL SUPERSTRUCTURE INCLUDING FLOORS ABOVE GRADE, ROOFING SUPPORT, FASCIAS, FACADE SUPPORT, ANCHOR BOLT LAYOUT & DESIGN, TEMPORARY BRACING, LATERAL ANALYSIS AND RELATED WORK.
- REFER TO INCLUDED STRUCTURAL NARRATIVE FOR ADDITIONAL INFORMATION REGARDING PEMB DESIGN CRITERIA.

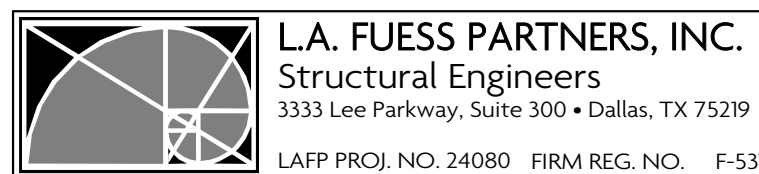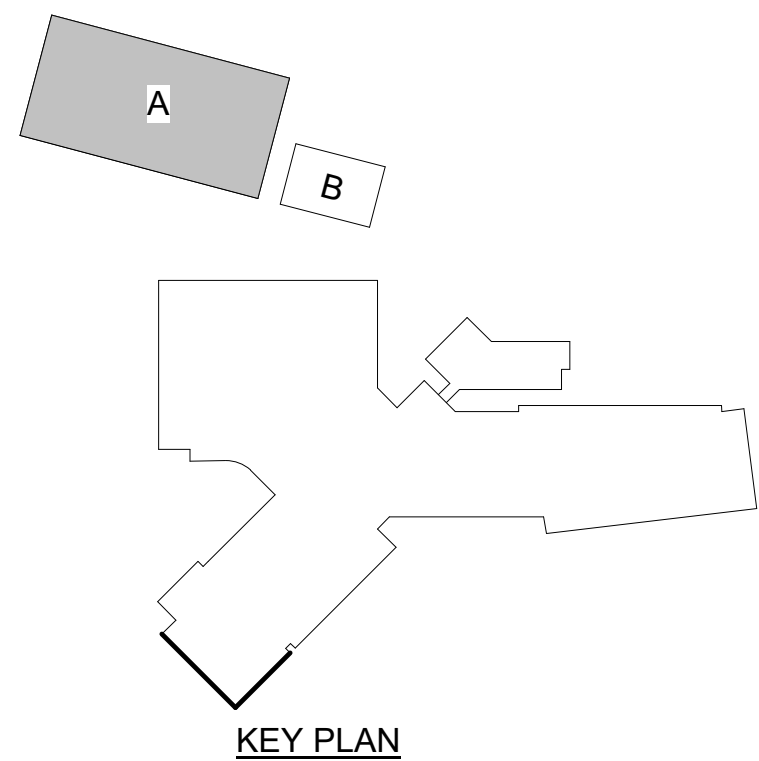


ADDENDUM 03

Date: 05/15/25  
Revision: 1

JOHNSON HIGH SCHOOL  
2025 ADDITIONS  
FOR  
HAYS CISD  
BUDA, TX

Project:

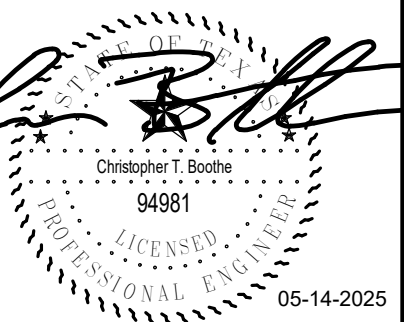


**Huckabee**  
www.huckabee-inc.com  
800.887.1229

ROOF FRAMING PLAN - AREA A


PACKAGE		VOLUME	
Job No. 1954-07-01	Sheet No. ISSUE FOR BID	S2.1A2	
Drawn By: LAFP	Date: 04/22/2025		



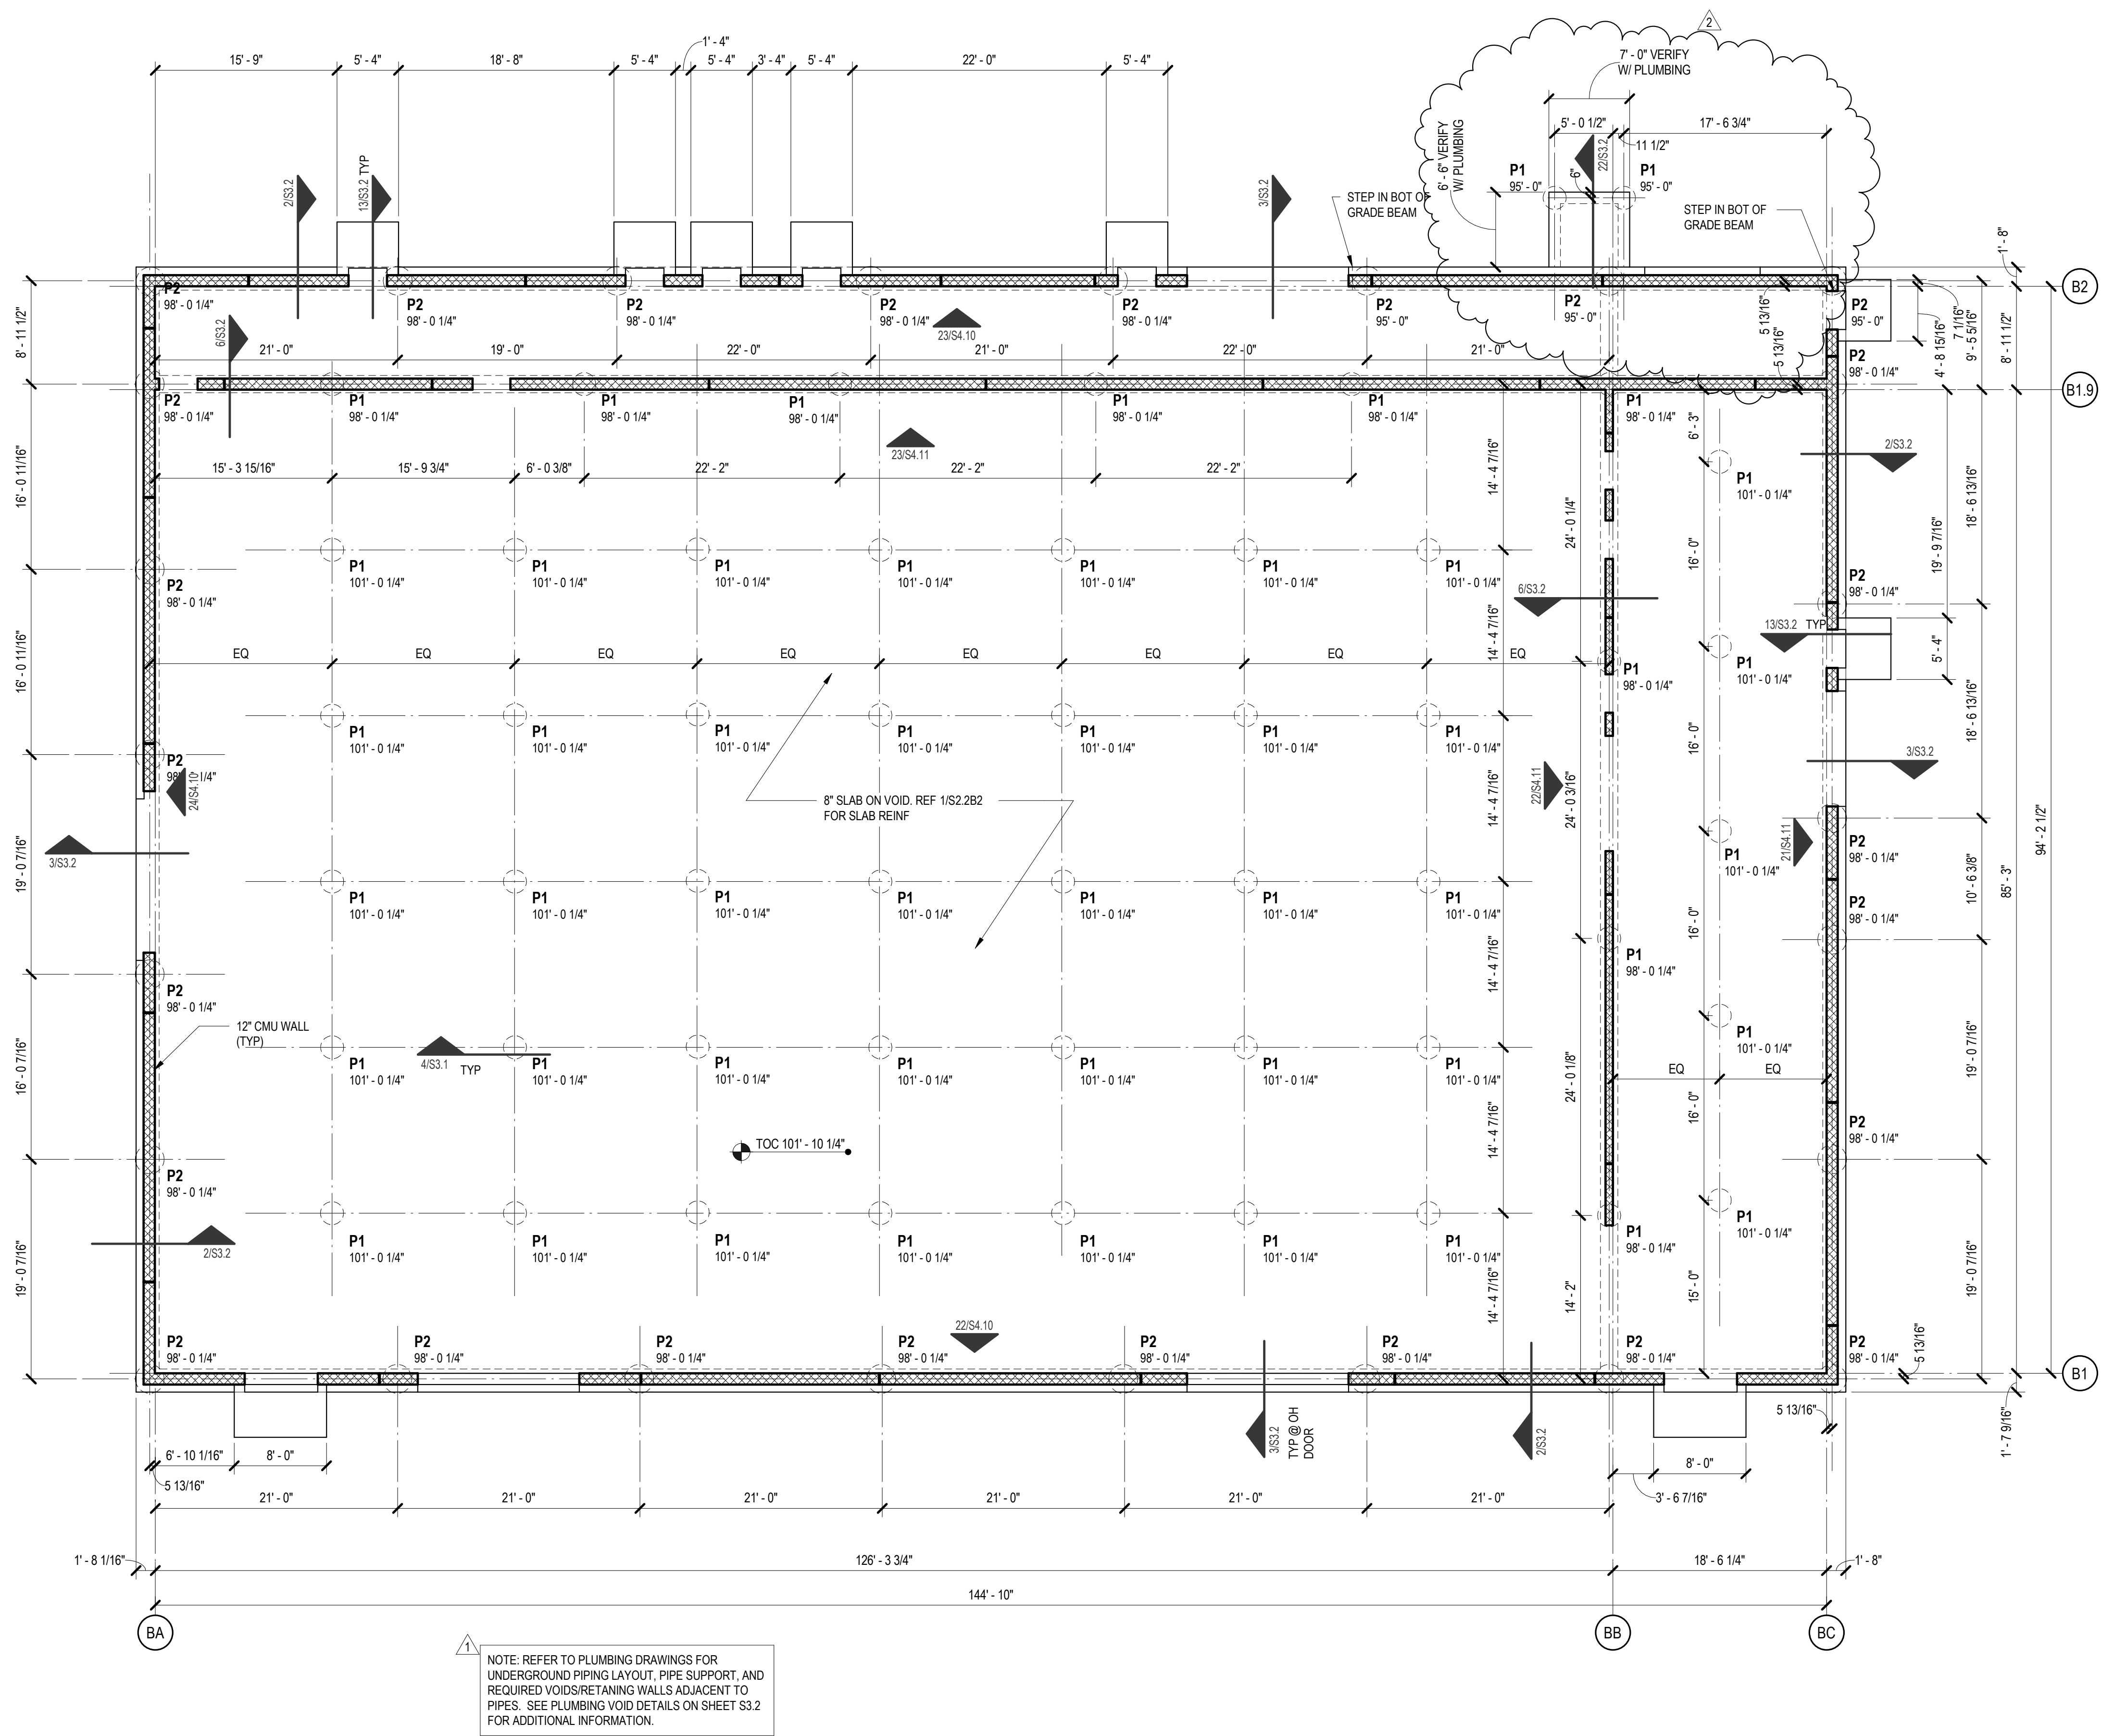


## 1 FOUNDATION PLAN - AREA B

1/8" = 1'-0"

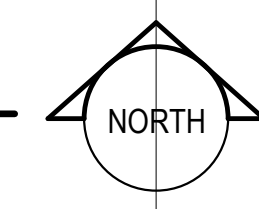


### FOUNDATION PLAN NOTES

- SEE PLAN FOR FINISH FLOOR ELEVATION (RELATIVE TO DATUM 100'-0").
- TOP OF CONCRETE SLAB IS FINISH FLOOR UNLESS SHOWN OTHERWISE.
- TYPICAL FLOOR STRUCTURE IS 8" CONCRETE SLAB ON CARTON FORMS UNLESS NOTED OTHERWISE. SEE GENERAL NOTES, SLAB REINFORCEMENT PLAN NOTES, AND DETAILS FOR ADDITIONAL INFORMATION.
- TOP OF PIER ELEVATION RELATIVE TO DATUM 100'-0".
- SHEET INDEX:
  - GENERAL NOTES -S1.1
  - PIER SCHEDULE -S3.1
  - CONCRETE DETAILS -S3 SERIES
  - MASONRY WALL DETAILS -S4 SERIES

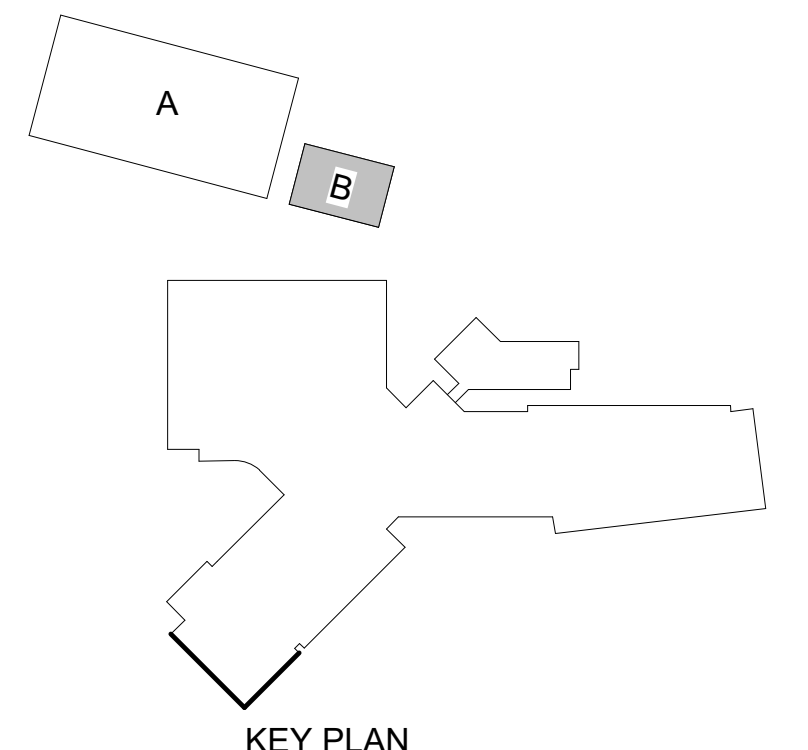

KEY PLAN

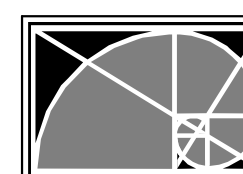

L.A. FUESS PARTNERS, INC.  
Structural Engineers  
3333 Lee Parkway, Suite 300 • Dallas, TX 75219  
LAFIP PROJ. NO. 24080 FIRM REG. NO. F-537

Date  
05/08/25  
05/15/25  
Revision /  
1  
2

ADDENDUM 01  
ADDENDUM 03

JOHNSON HIGH SCHOOL  
2025 ADDITIONS  
FOR  
HAYS CISD  
BUDA, TX

Project:




Huckabee  
www.huckabee-inc.com  
800.887.1229

FOUNDATION PLAN - AREA B


PACKAGE VOLUME  
Job No.  
1954-07-01  
Sheet No.  
S2.1B1  
Drawn By:  
LAFIP  
Date:  
04/22/2025



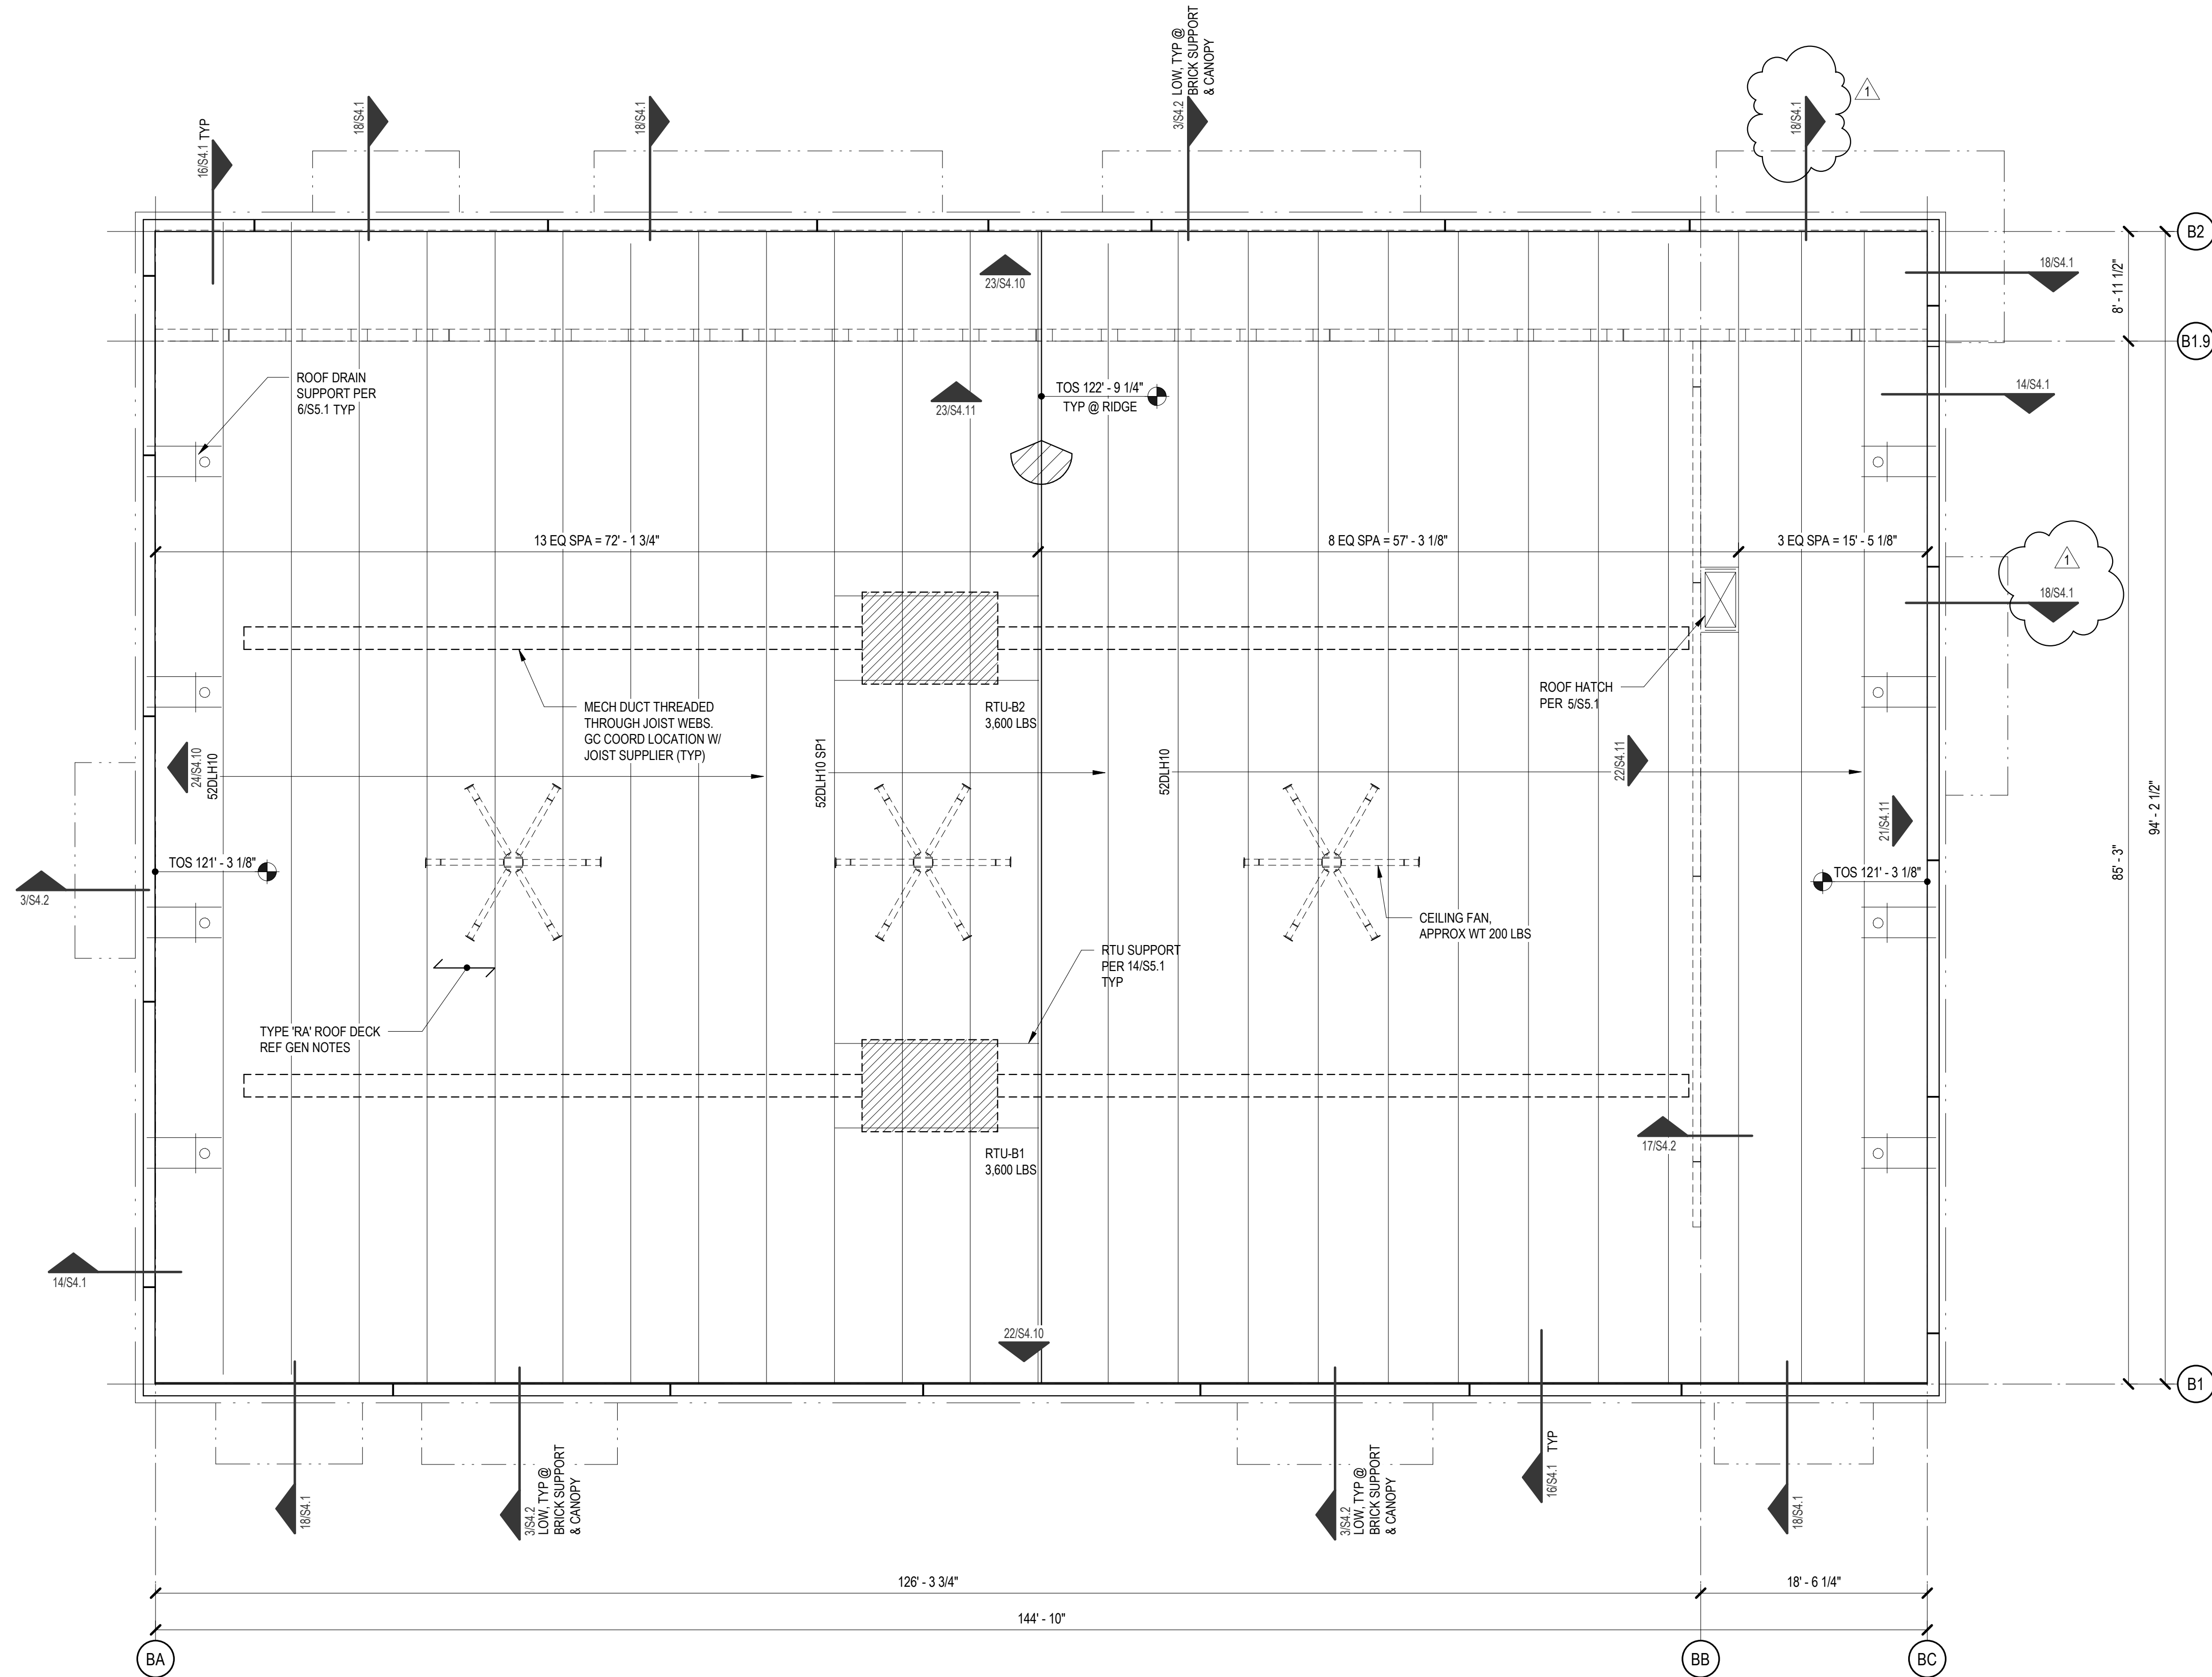


## 1 ROOF FRAMING PLAN - AREA B

1/8" = 1'-0"

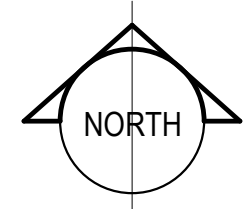


### PLAN NOTES

1. TOP OF ROOF STRUCTURE IS SLOPED FOR DRAINAGE. SEE TOP OF STEEL ELEVATIONS NOTED ON FRAMING PLANS, SLOPES SHALL BE UNIFORM BETWEEN COLUMN CENTERLINES UNO.
2. TOP OF STEEL ELEVATIONS SHOWN ON PLAN ARE BOTTOM OF ROOF DECK (TOP OF BEAM OR JOIST). ELEVATIONS ARE SHOWN RELATIVE TO DATUM 100'-0" UNO. SEE GENERAL NOTES FOR MORE INFO.
3. UNLESS NOTED OTHERWISE, STEEL JOISTS/BEAMS SHALL BE CENTERED ON AND EQUALLY SPACED BETWEEN COLUMN CENTERLINES.
4. JOISTS SUPPORTING MECHANICAL EQUIPMENT SHALL BE DESIGNED FOR TYPICAL ROOF LOADING PLUS A CONCENTRATED LOAD OF 60% OF INDICATED EQUIPMENT WEIGHT PLACED AT ANY PANEL POINT.
5. REFER TO INCLUDED STRUCTURAL NARRATIVE FOR ADDITIONAL INFORMATION REGARDING DESIGN CRITERIA, MATERIALS, FRAMING SYSTEMS INCLUDING ALTERNATES, AND PRICING INFORMATION. SIZES SHOWN ON PLAN ARE FOR REFERENCE ONLY, REFER NARRATIVE FOR PRICING INFORMATION.

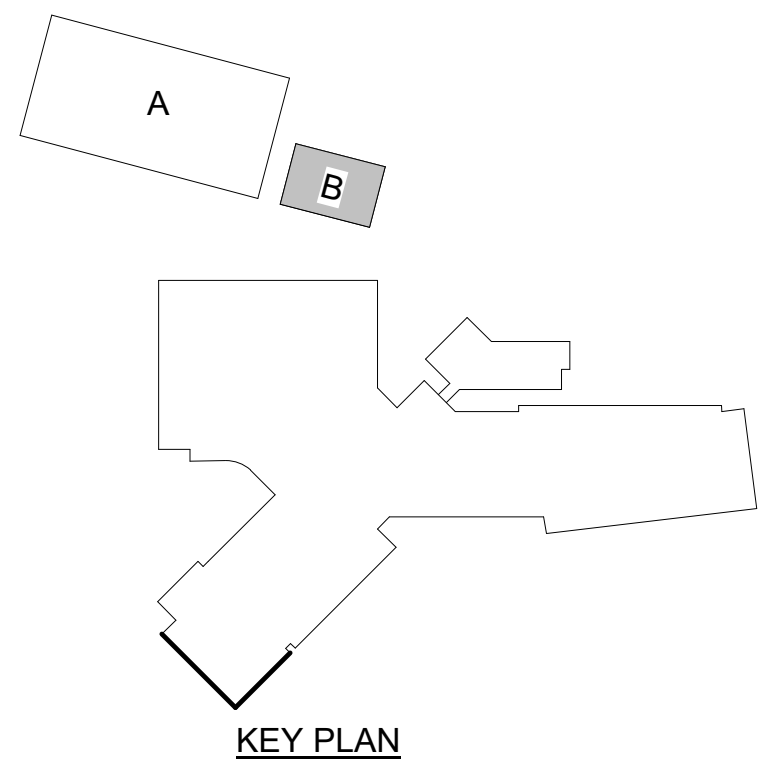


KEY PLAN

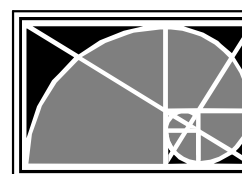


L.A. FUESS PARTNERS, INC.  
Structural Engineers  
3333 Lee Parkway, Suite 300 • Dallas, TX 75219  
LAFF PROJ. NO. 24080 FIRM REG. NO. F-537




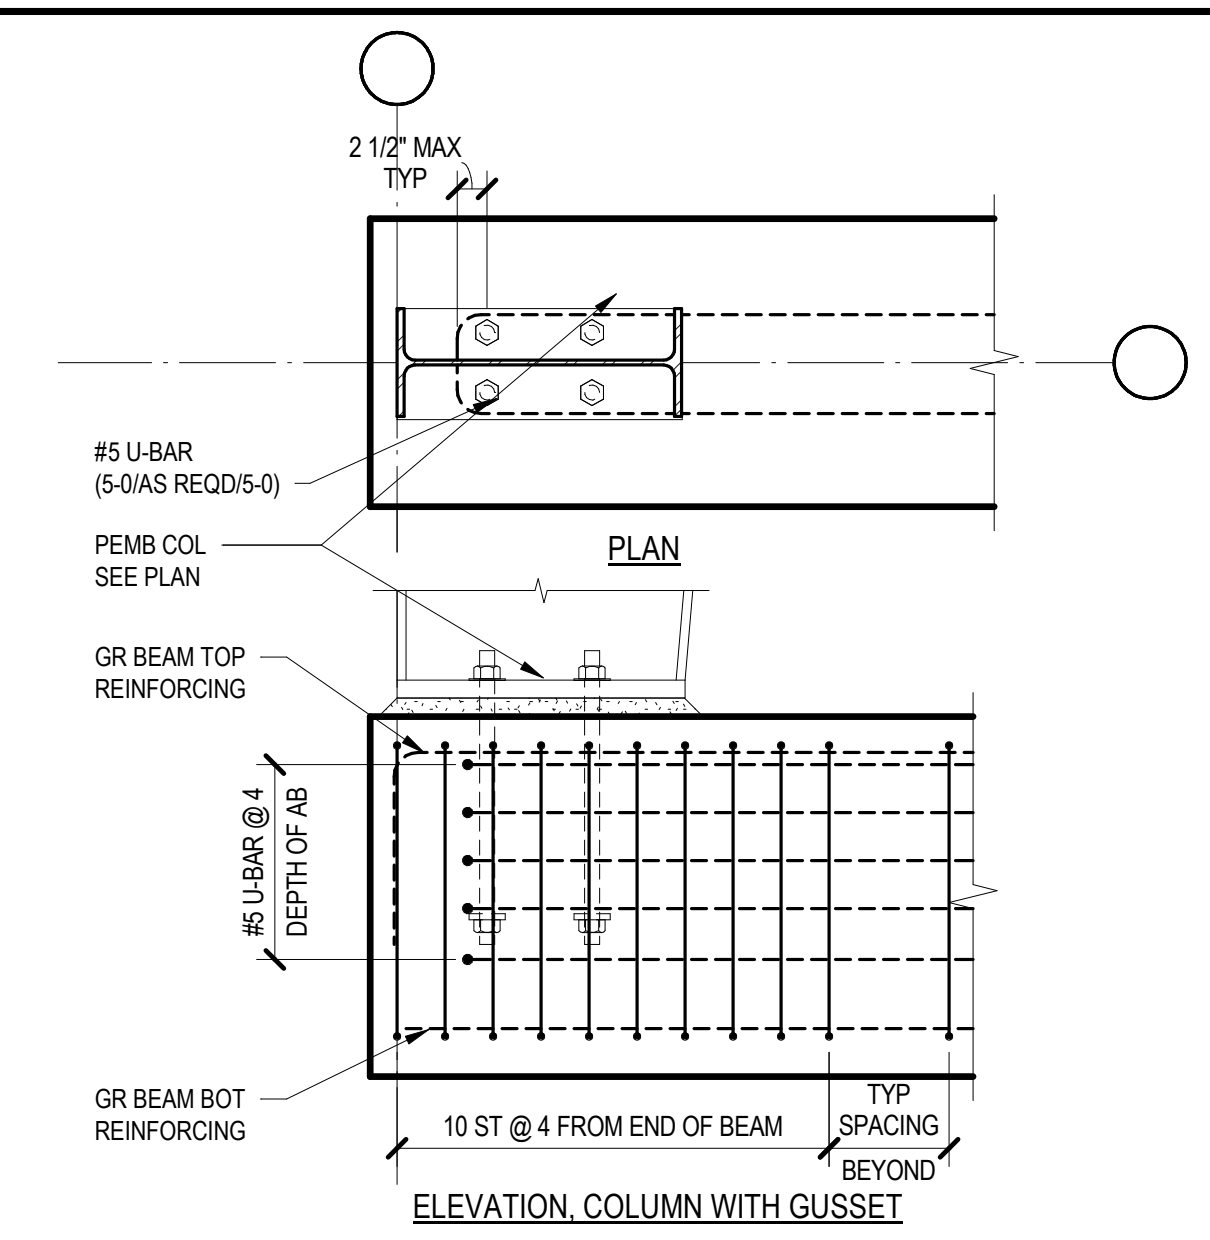


1 GR BM REINF @ PEMB COLUMN  
3/4\"/>

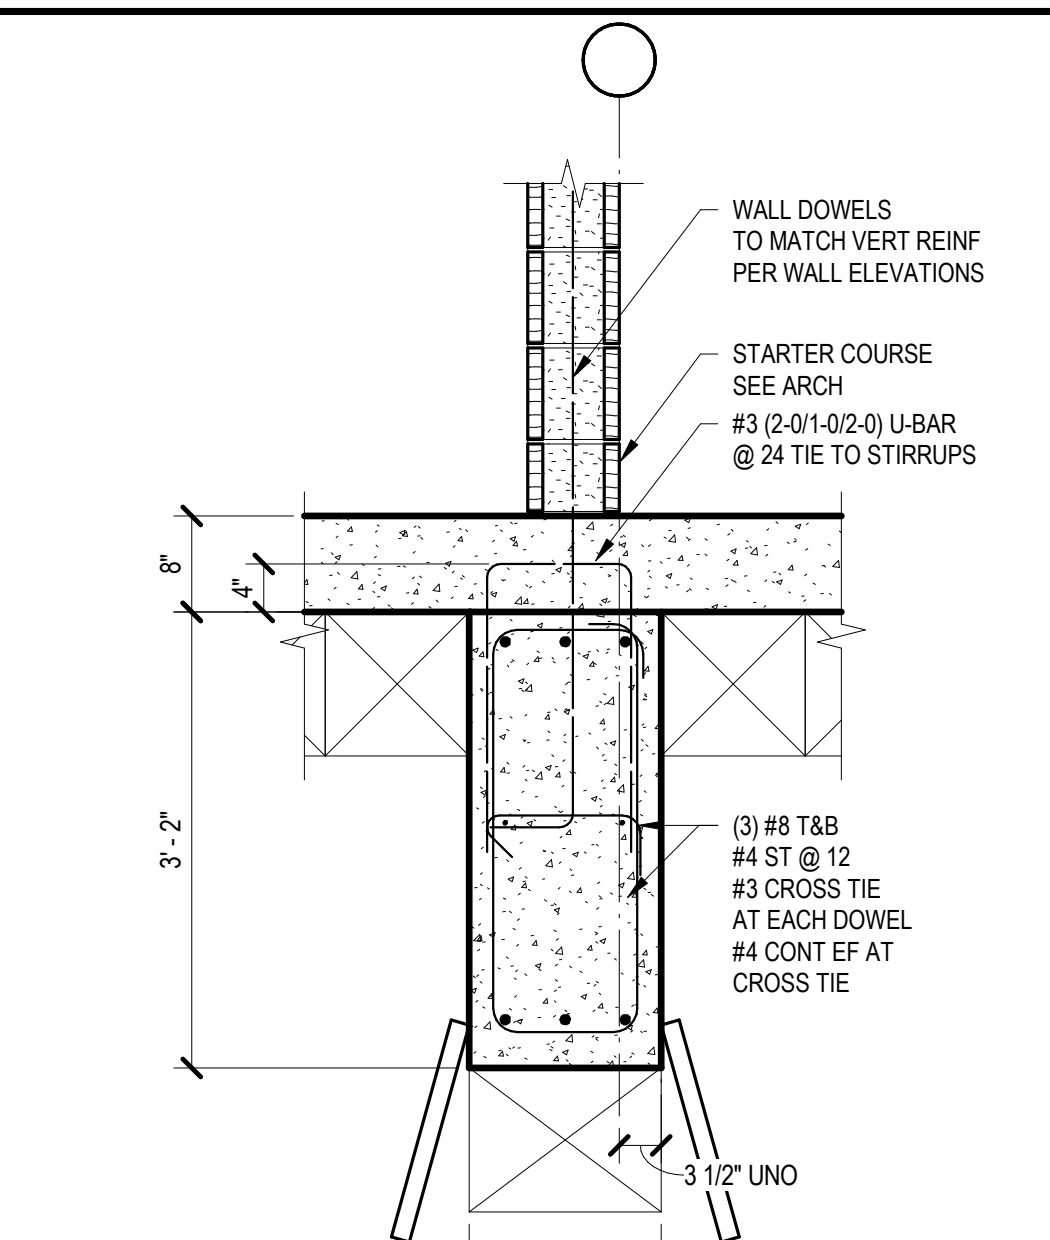


5  
3/4\"/>

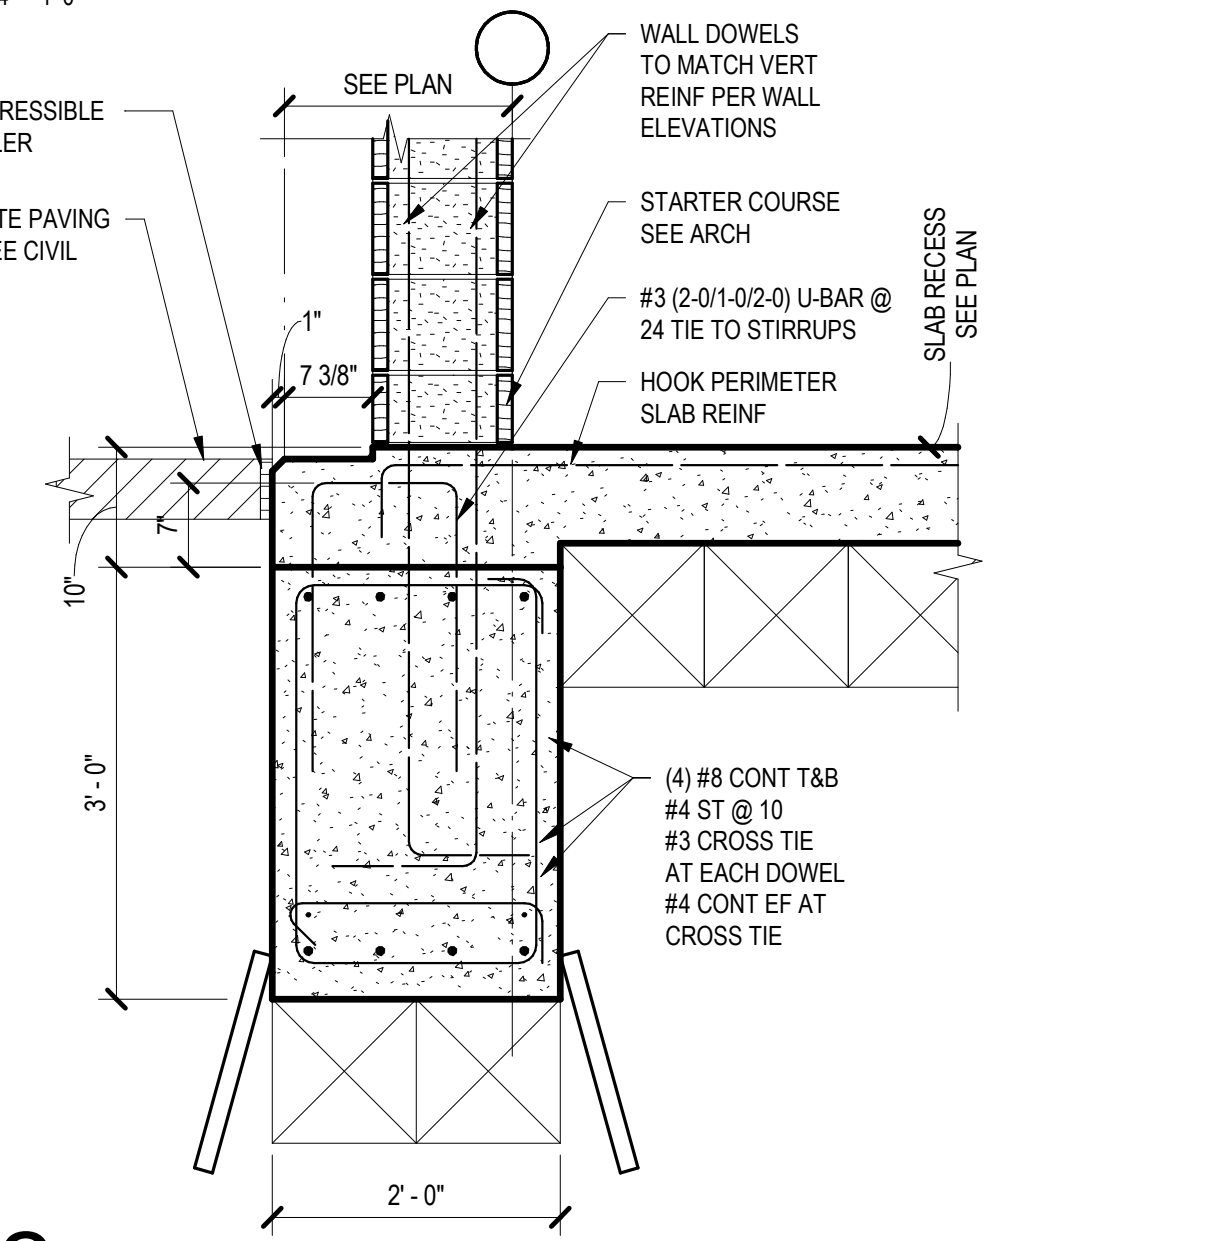


2 OVERHEAD DOOR  
3/4\"/>

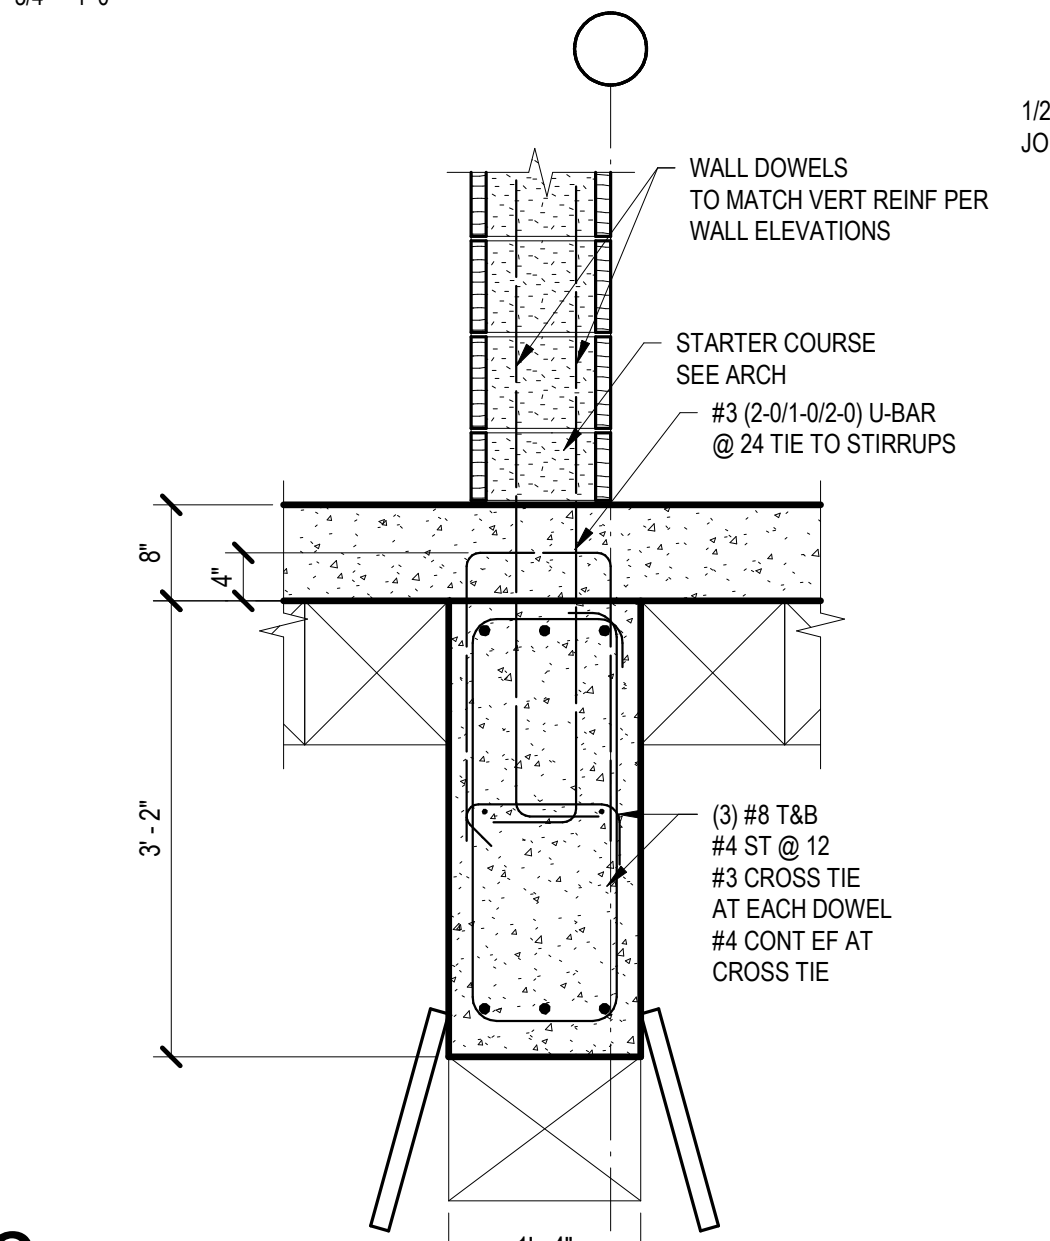


6  
3/4\"/>

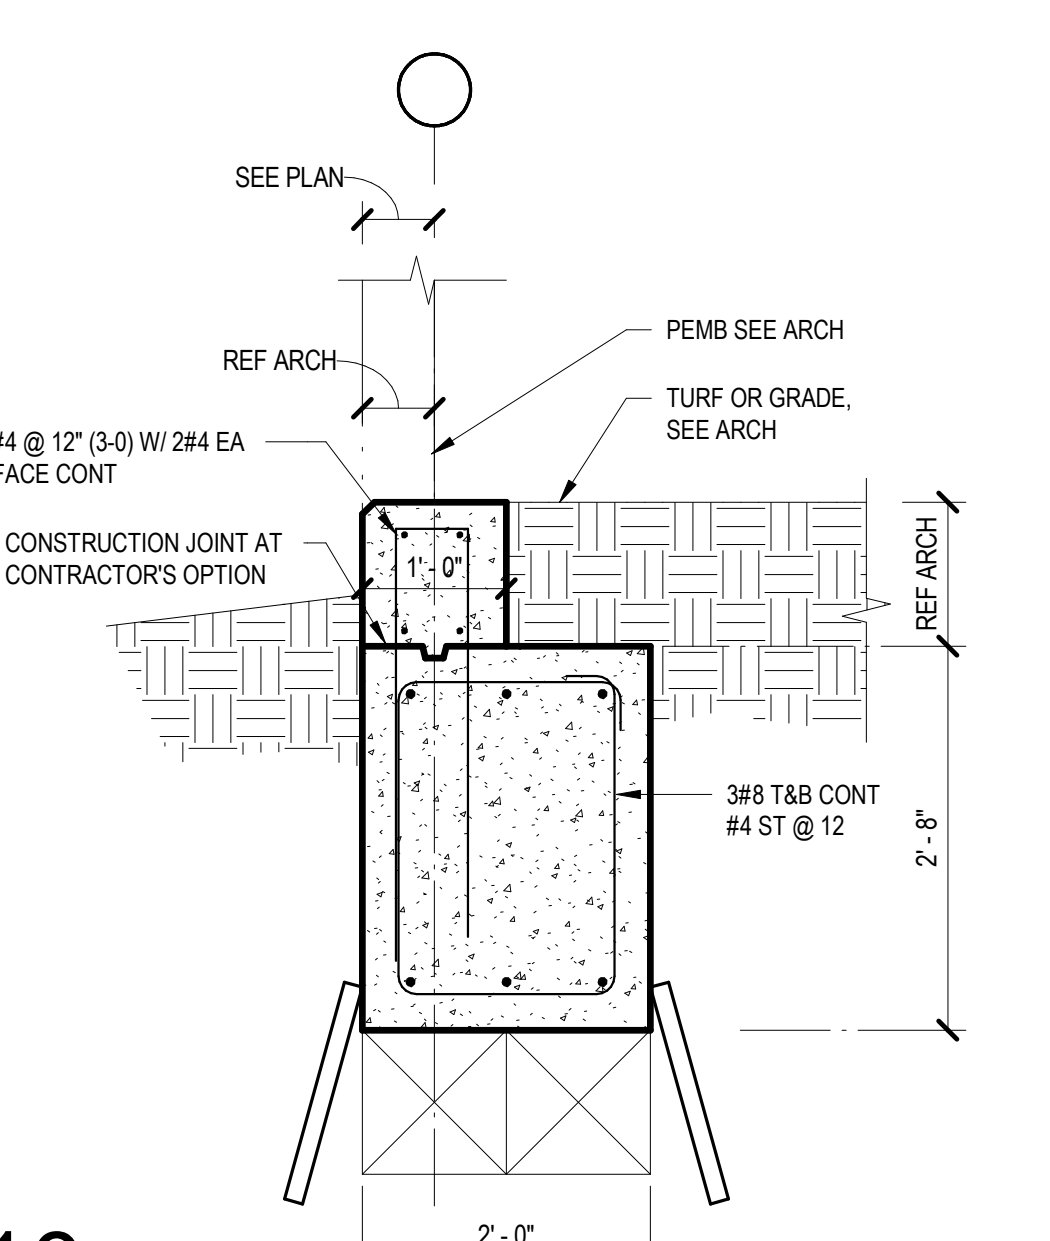


10  
3/4\"/>

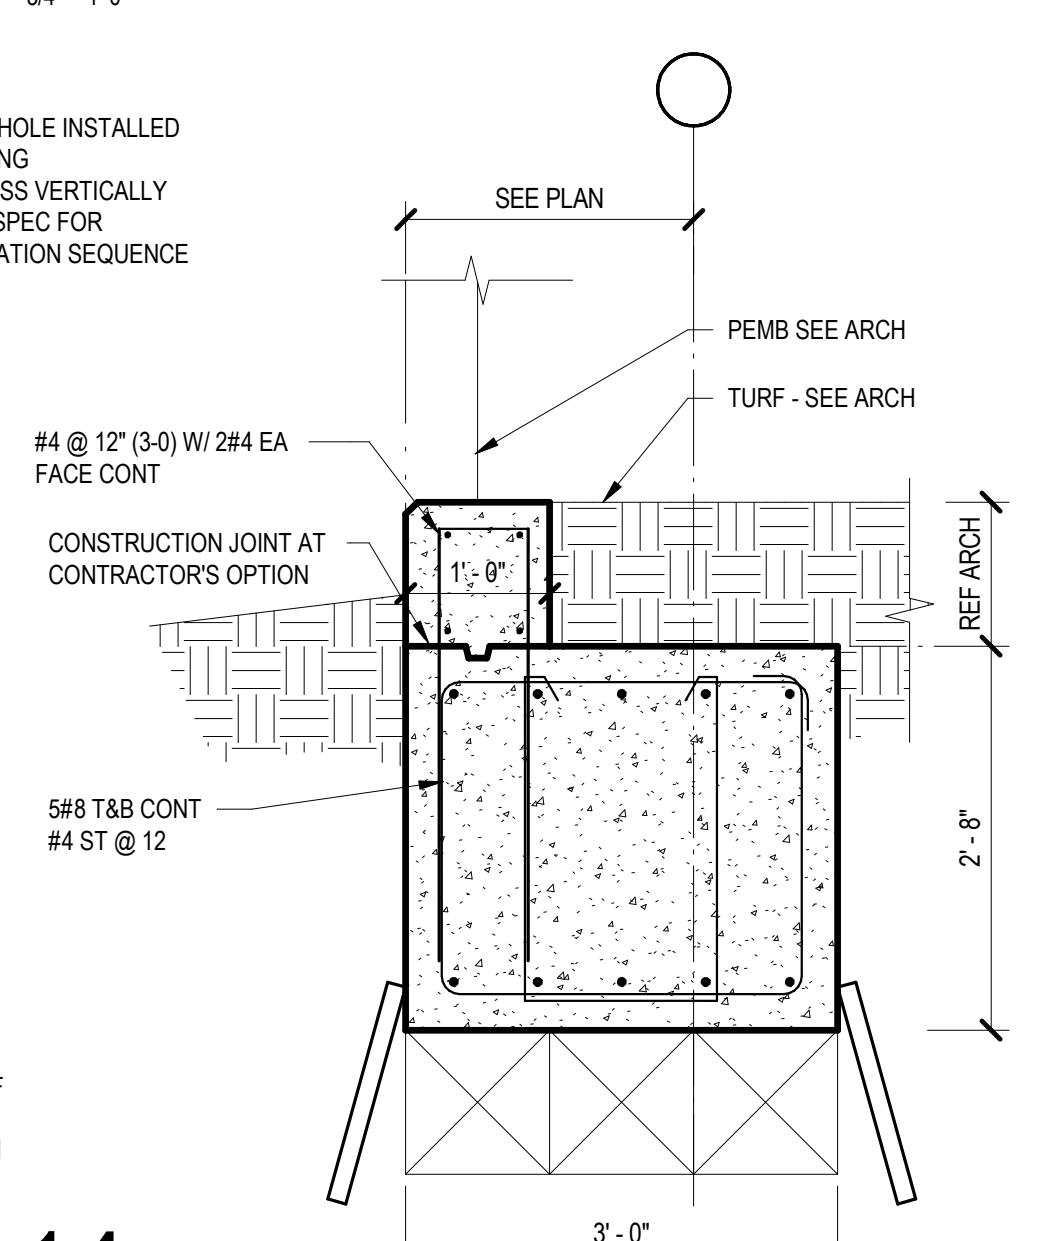


14  
3/4\"/>

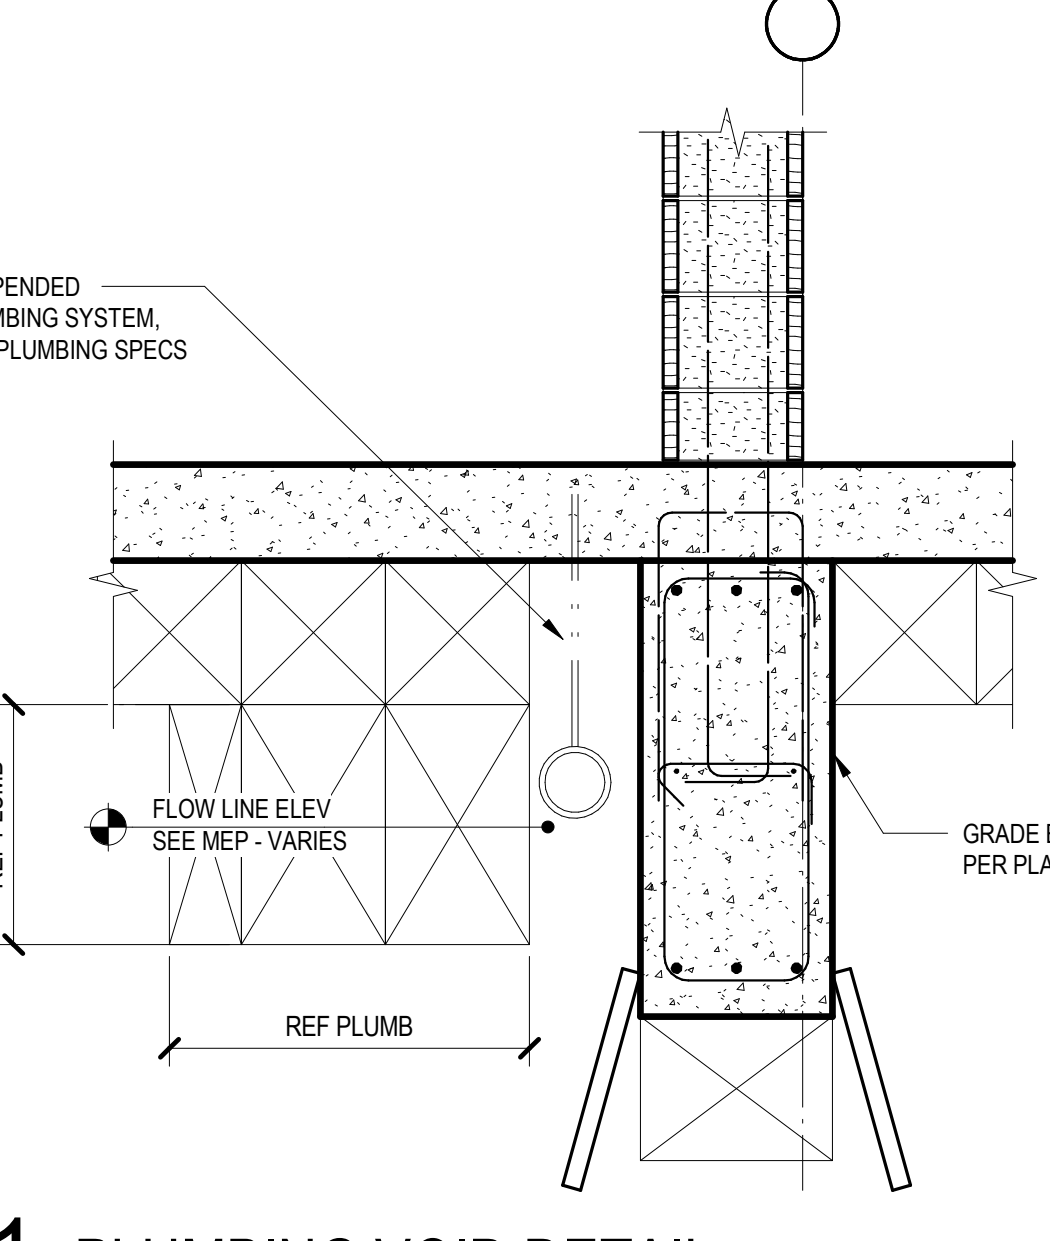


11 PLUMBING VOID DETAIL  
3/4\"/>

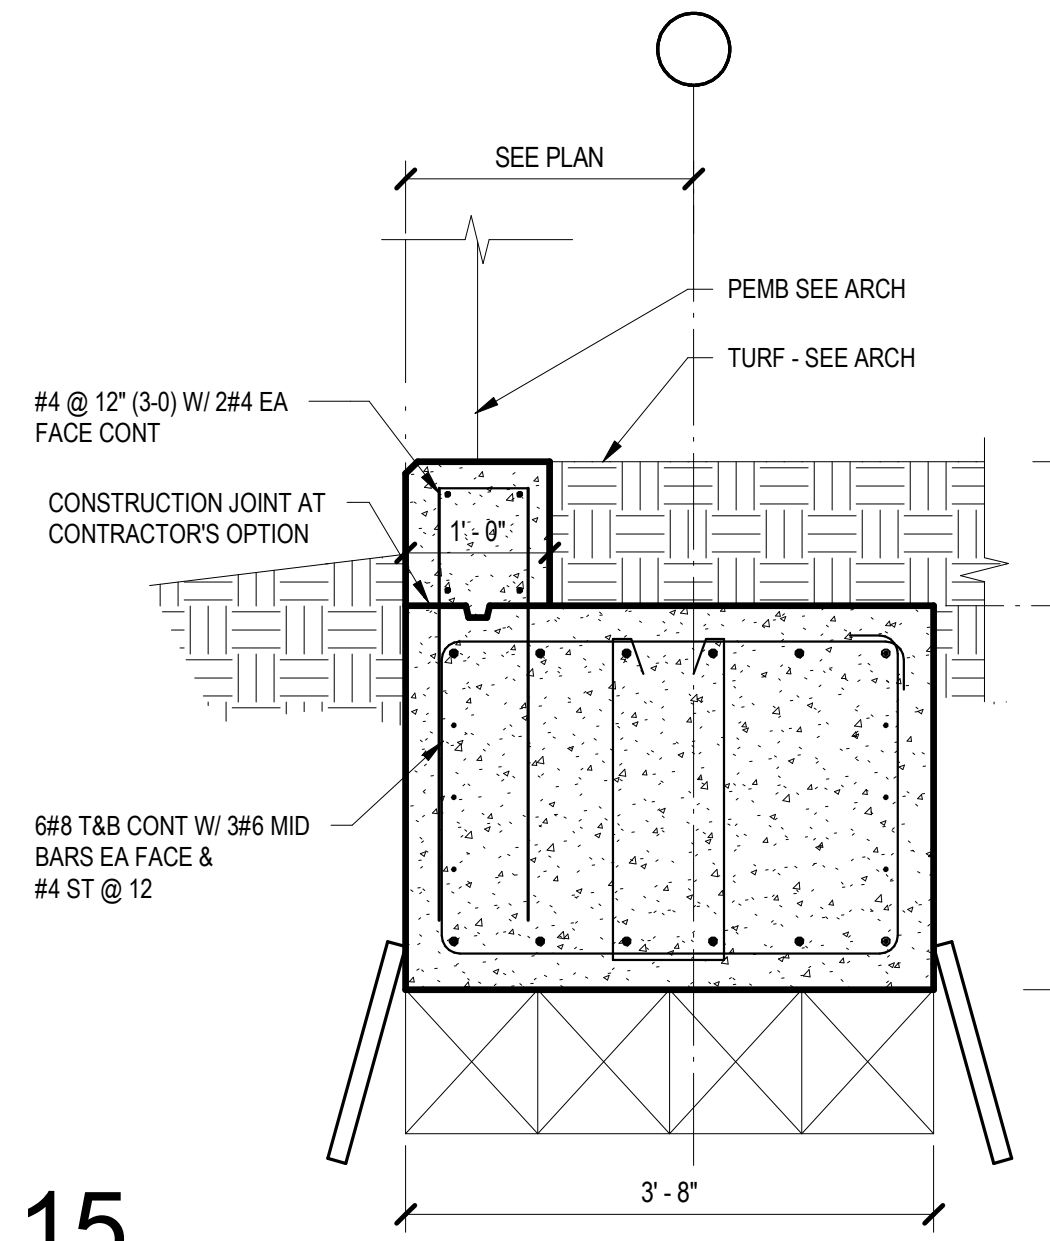


15  
3/4\"/>

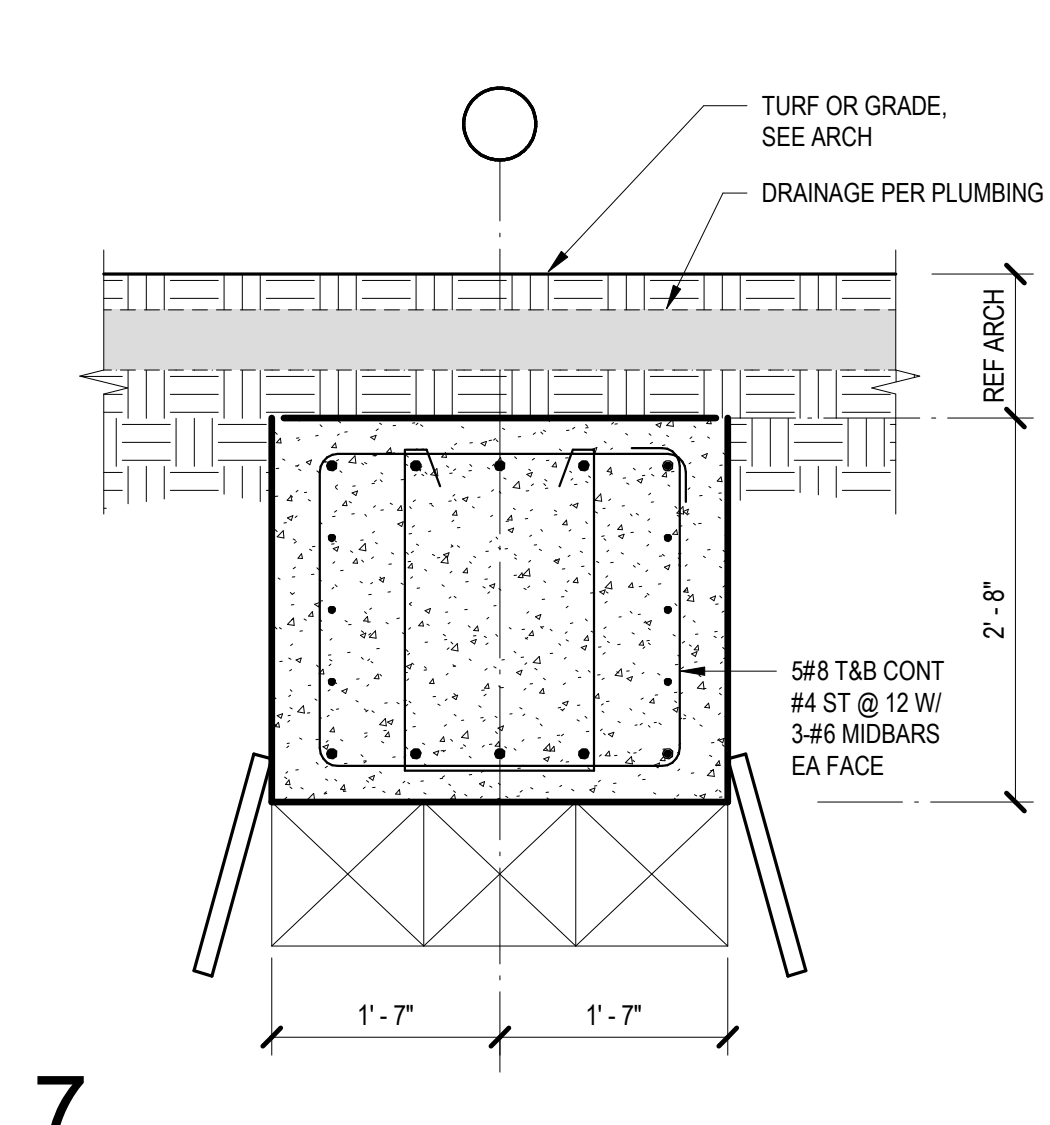


7  
3/4\"/>

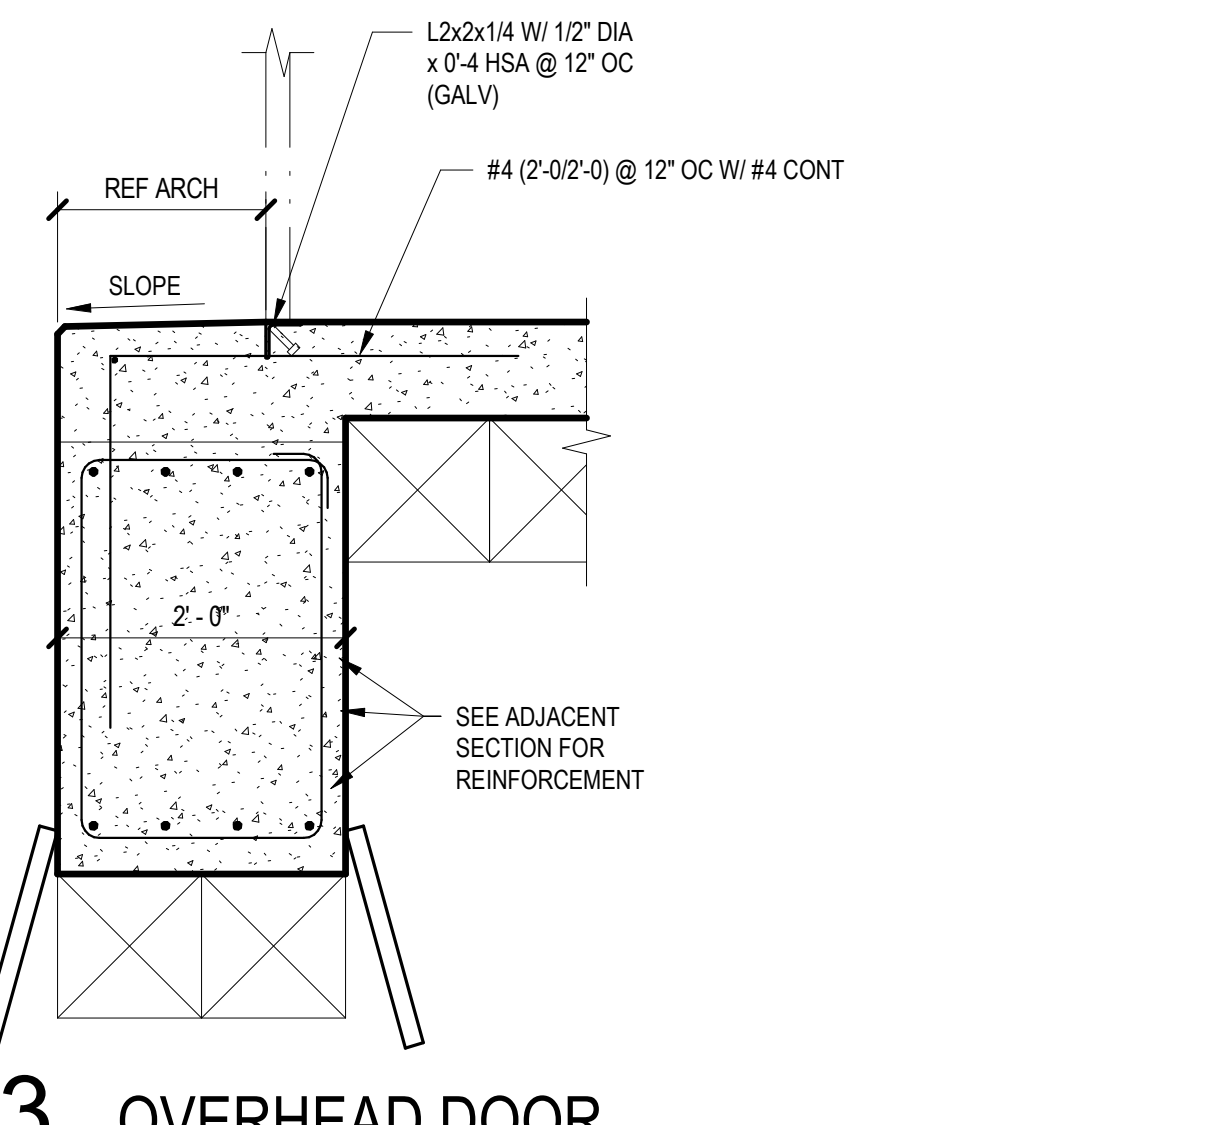


3 OVERHEAD DOOR  
3/4\"/>

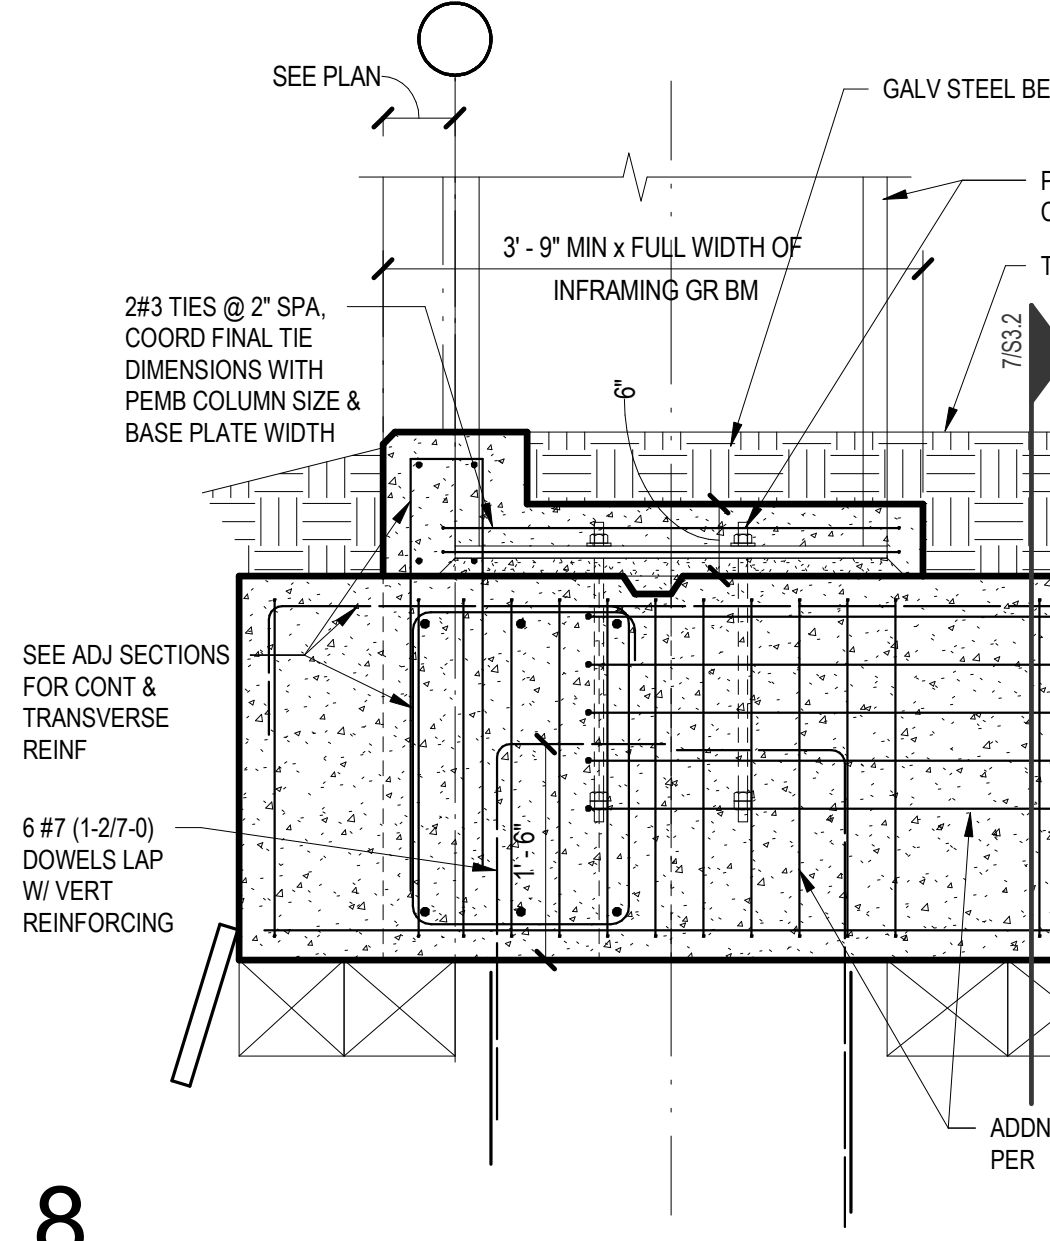


8  
3/4\"/>

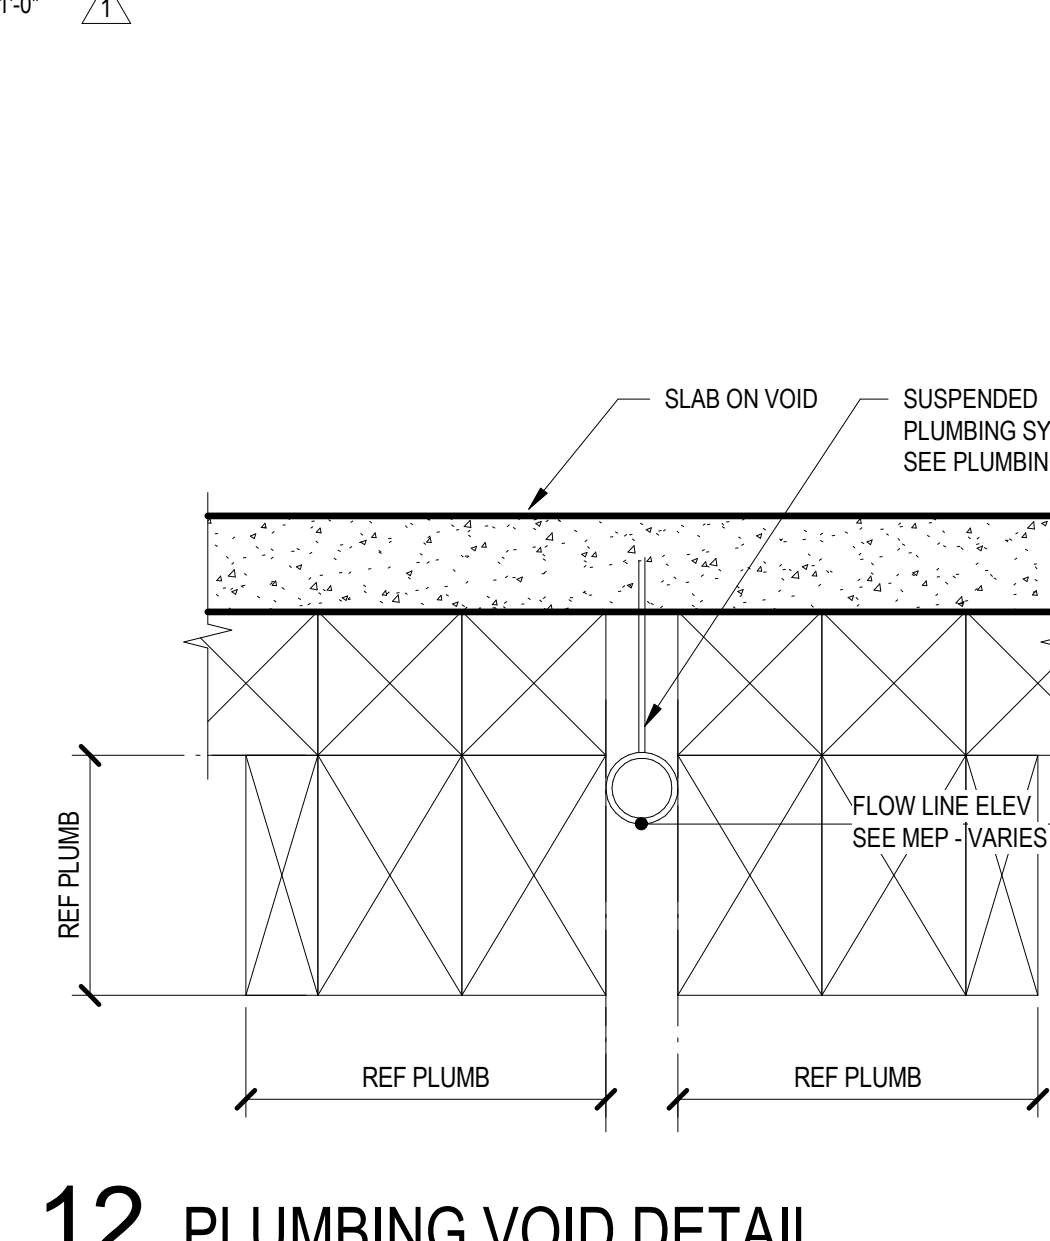


12 PLUMBING VOID DETAIL  
3/4\"/>

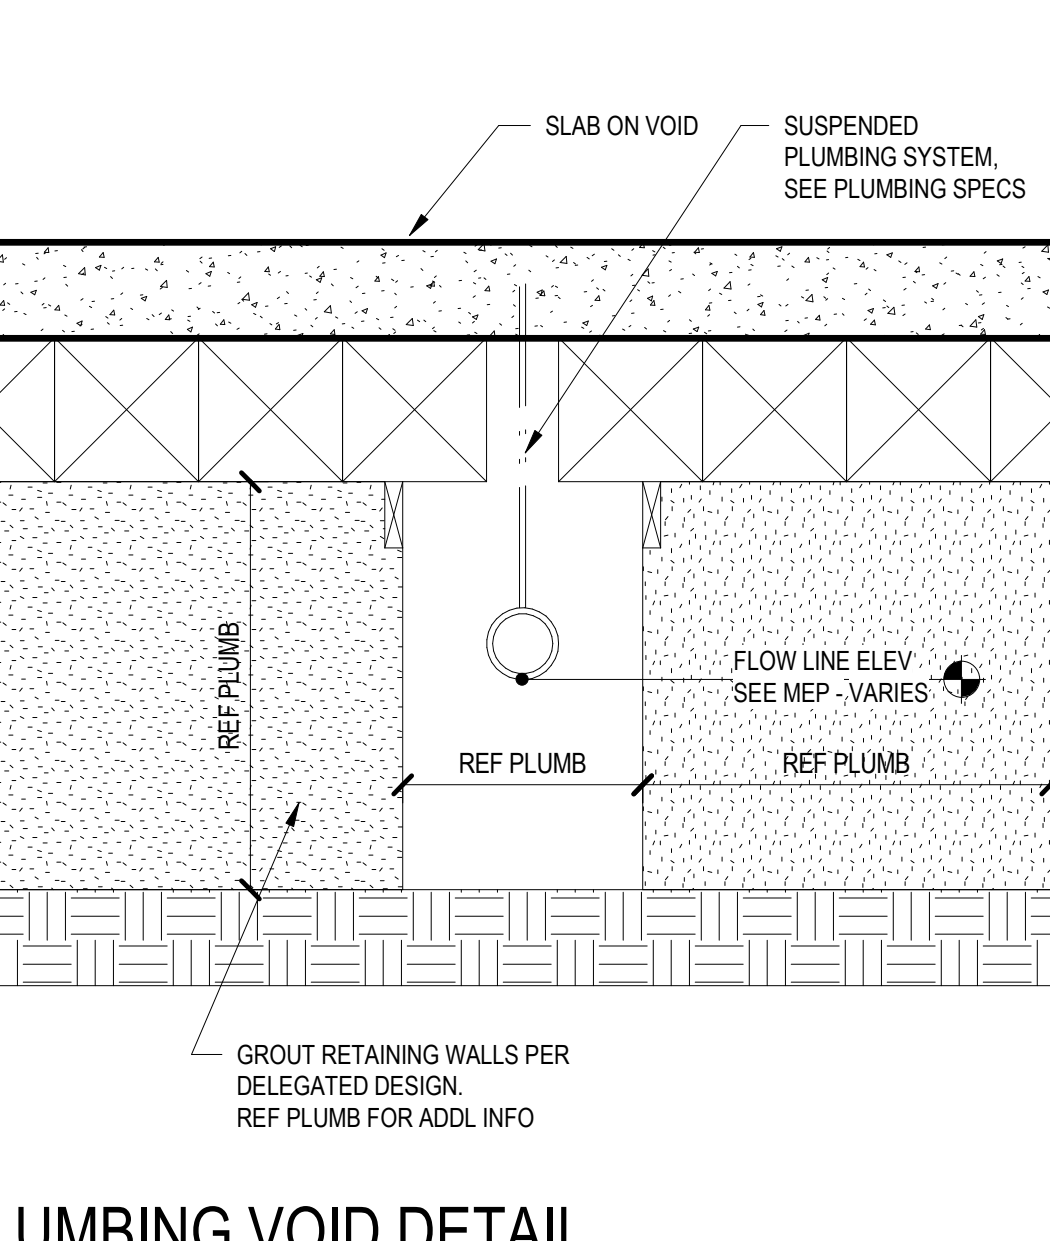


16 PLUMBING VOID DETAIL  
3/4\"/>

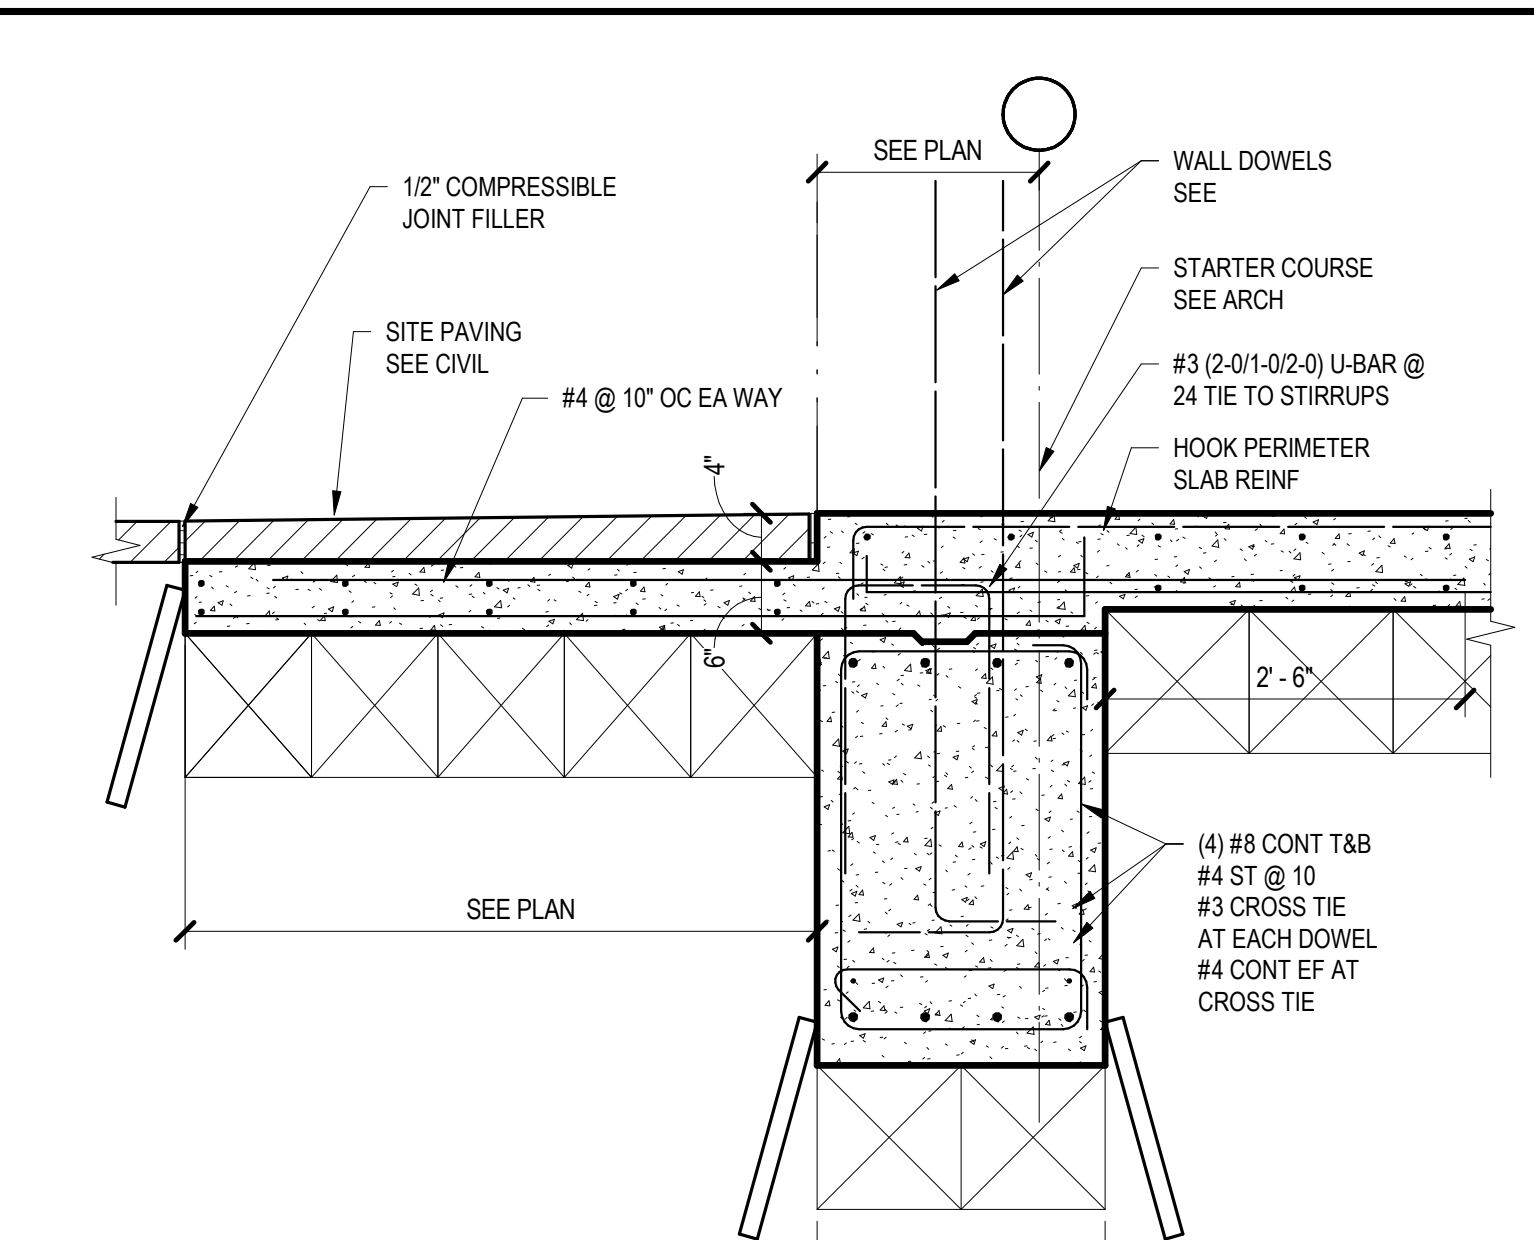

13 TYPICAL DETAIL  
3/4\"/>

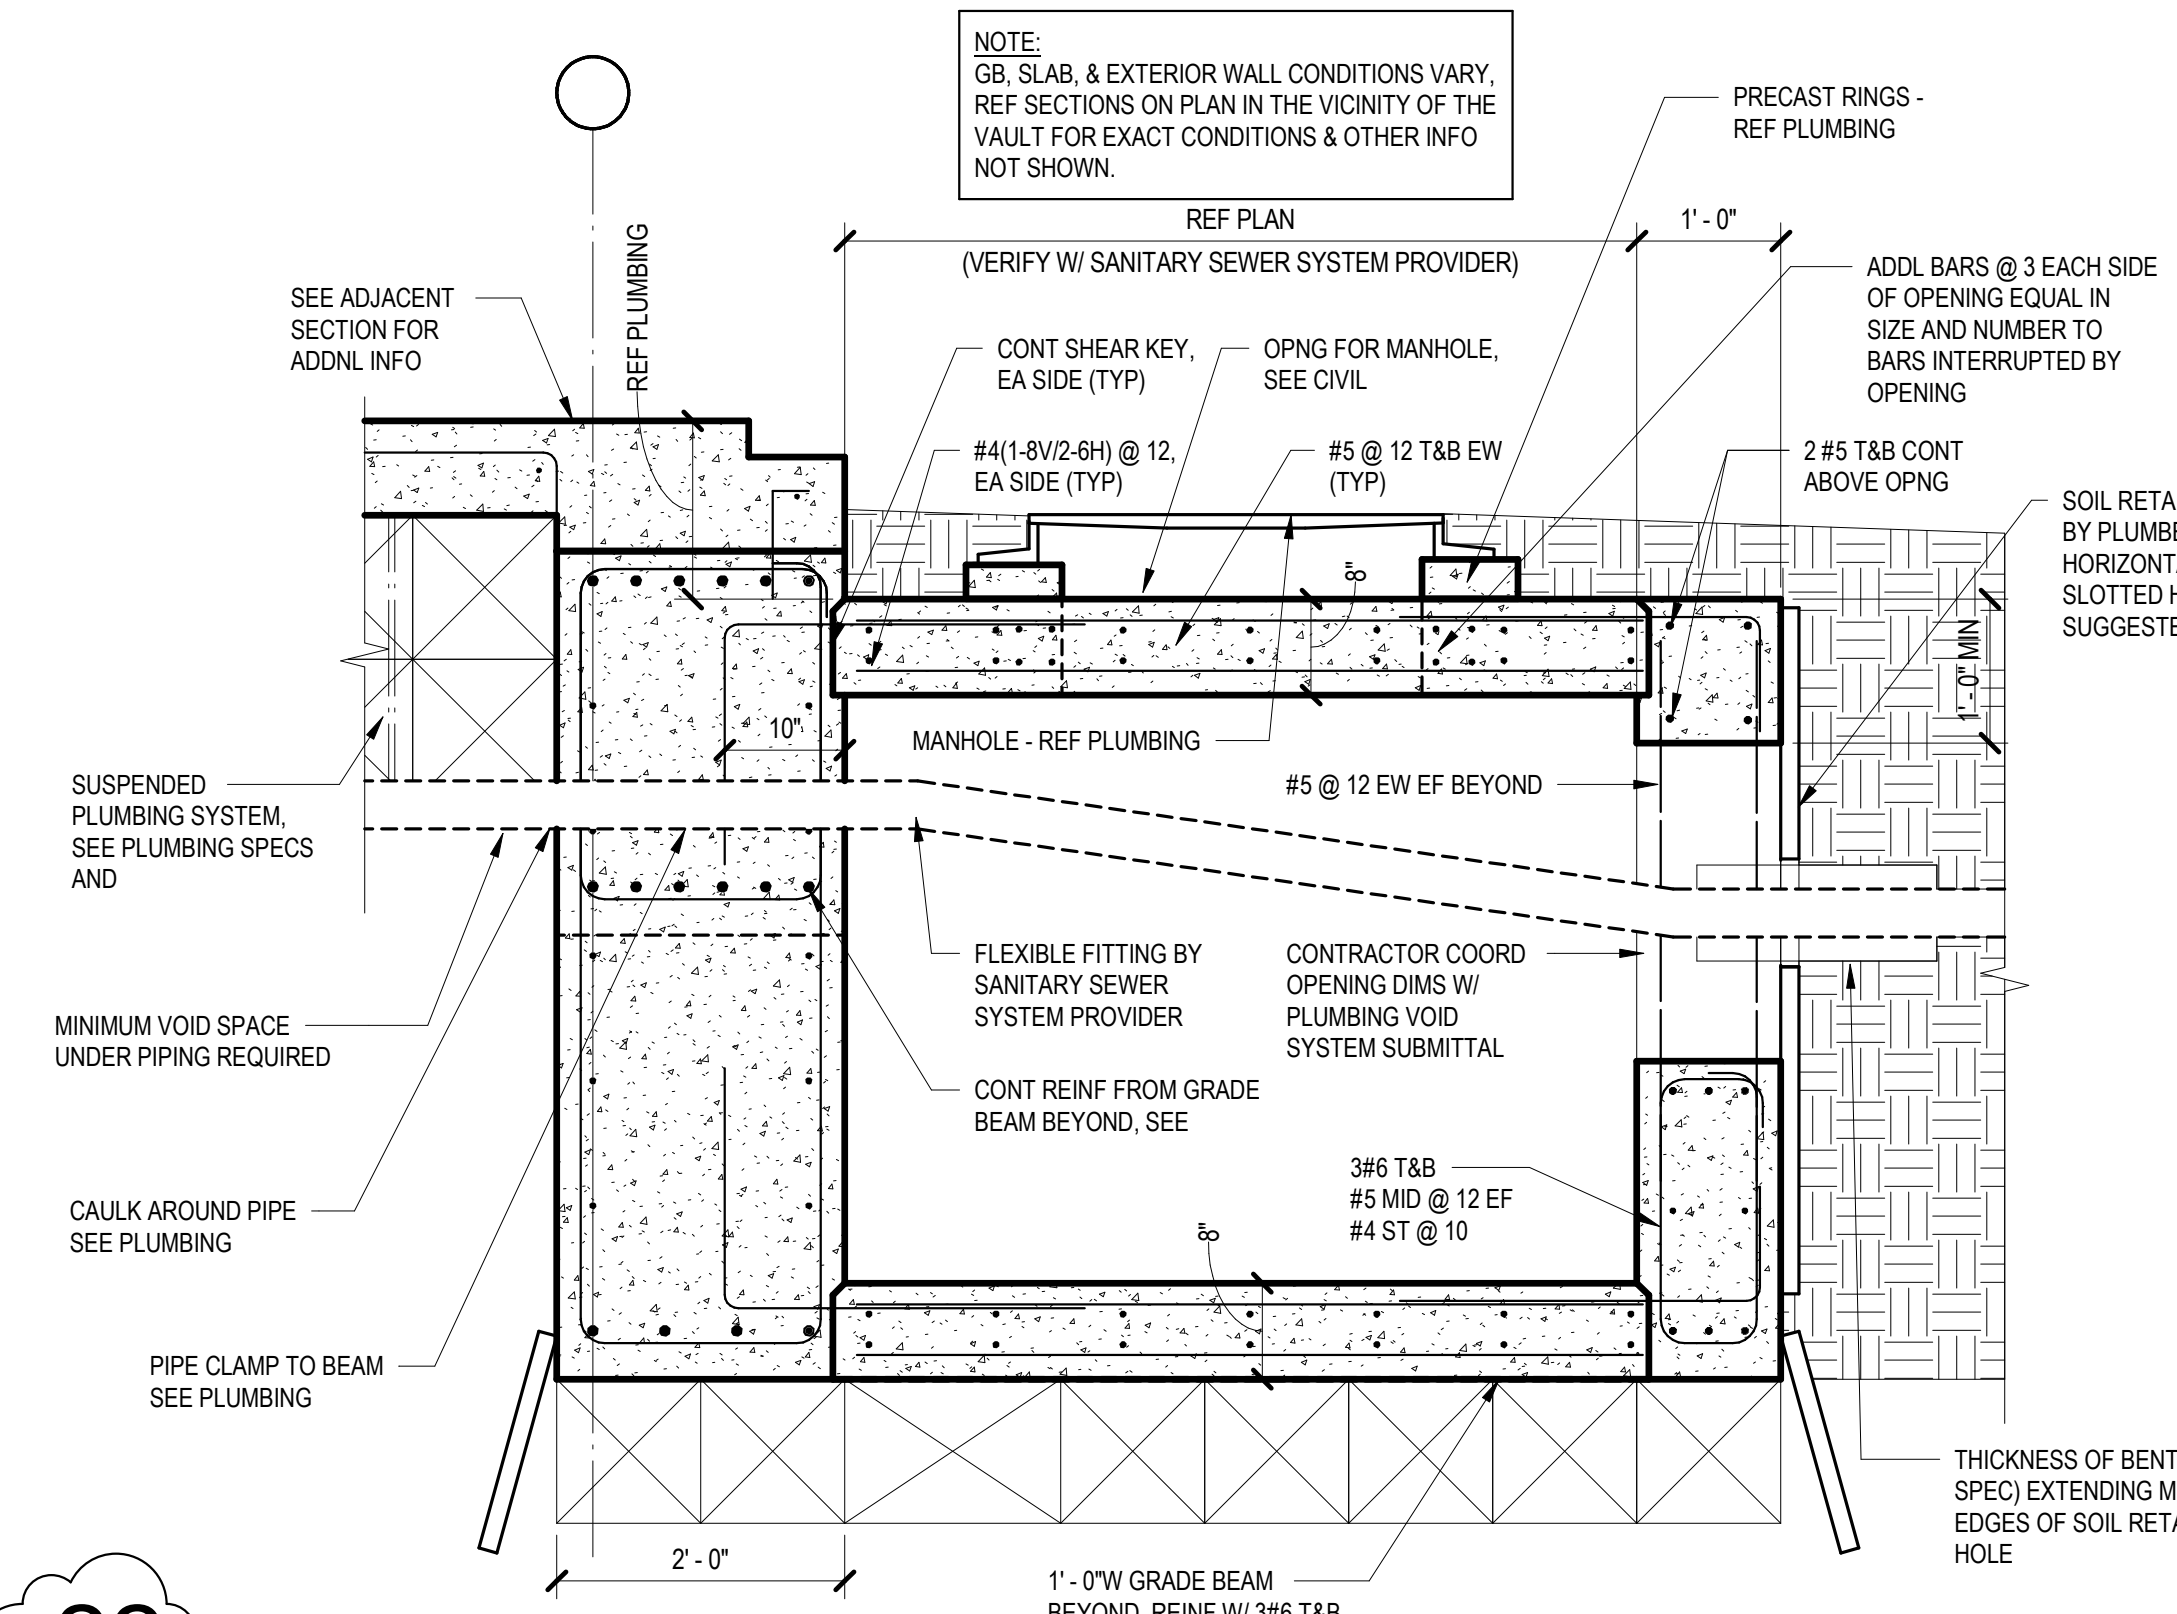


22 TYPICAL PLUMBING VAULT  
3/4\"/>

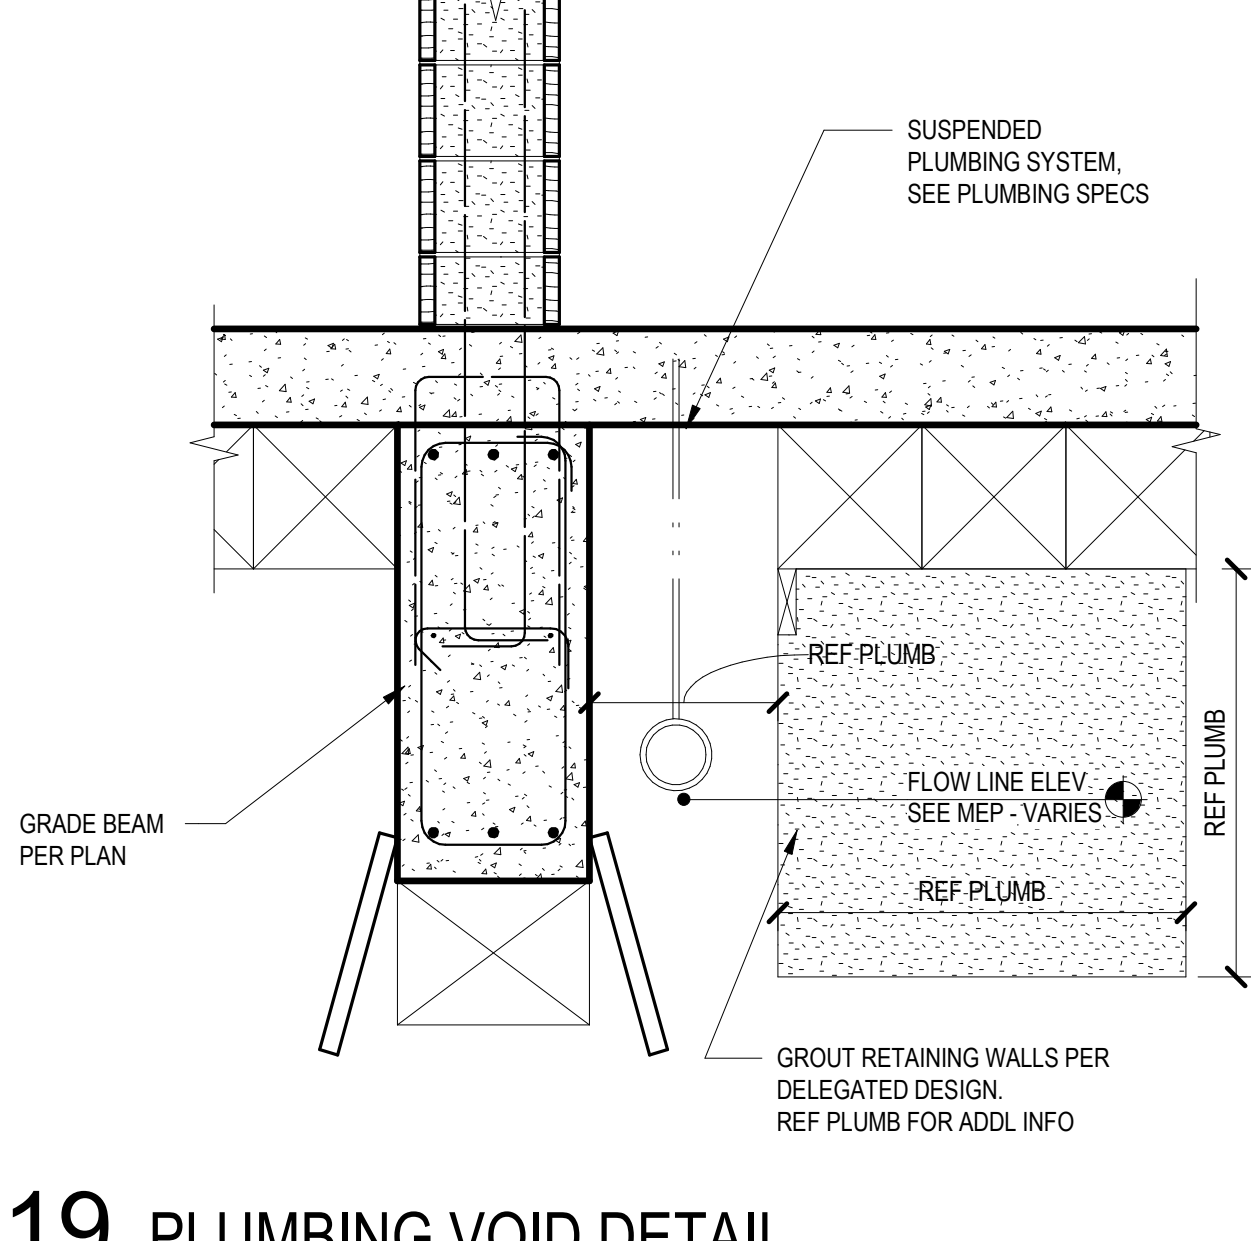


19 PLUMBING VOID DETAIL  
3/4\"/>



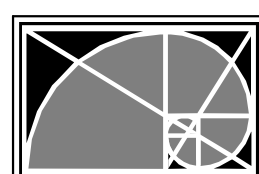


L.A. FUESS PARTNERS, INC.  
Structural Engineers  
3333 Lee Parkway, Suite 300 • Dallas, TX 75219  
LAFFP PROJ. NO. 24080 FIRM REG. NO. F-537

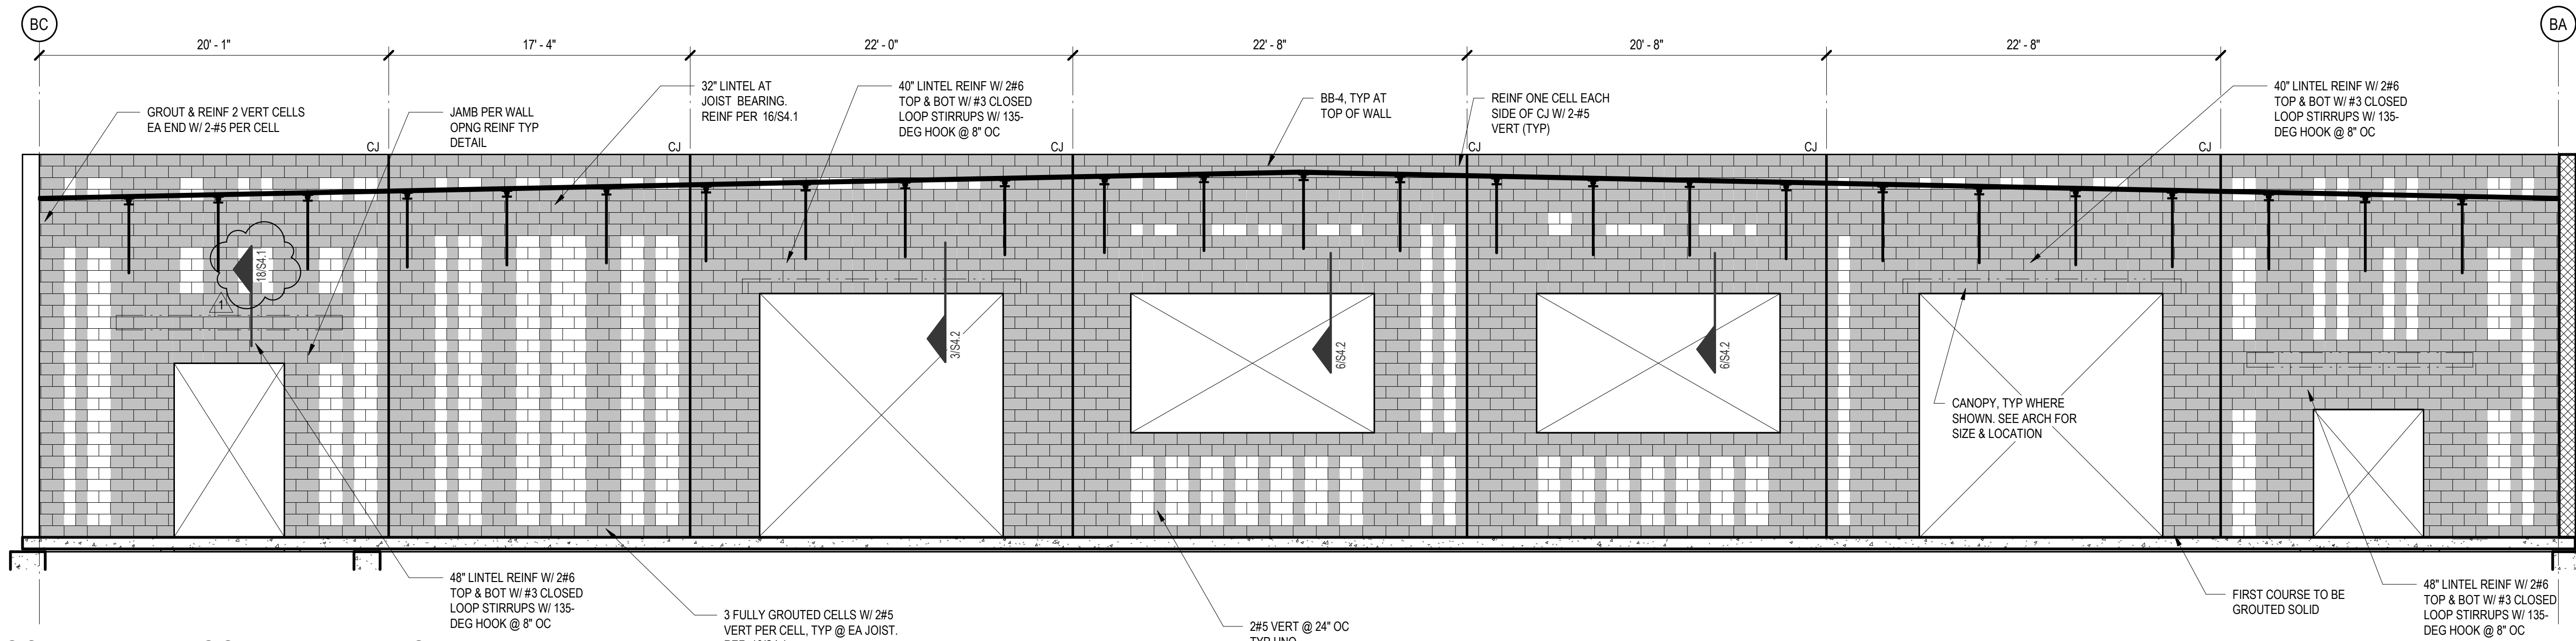


**22 MASONRY WALL - SOUTH ELEVATION**

3/16" = 1'-0"

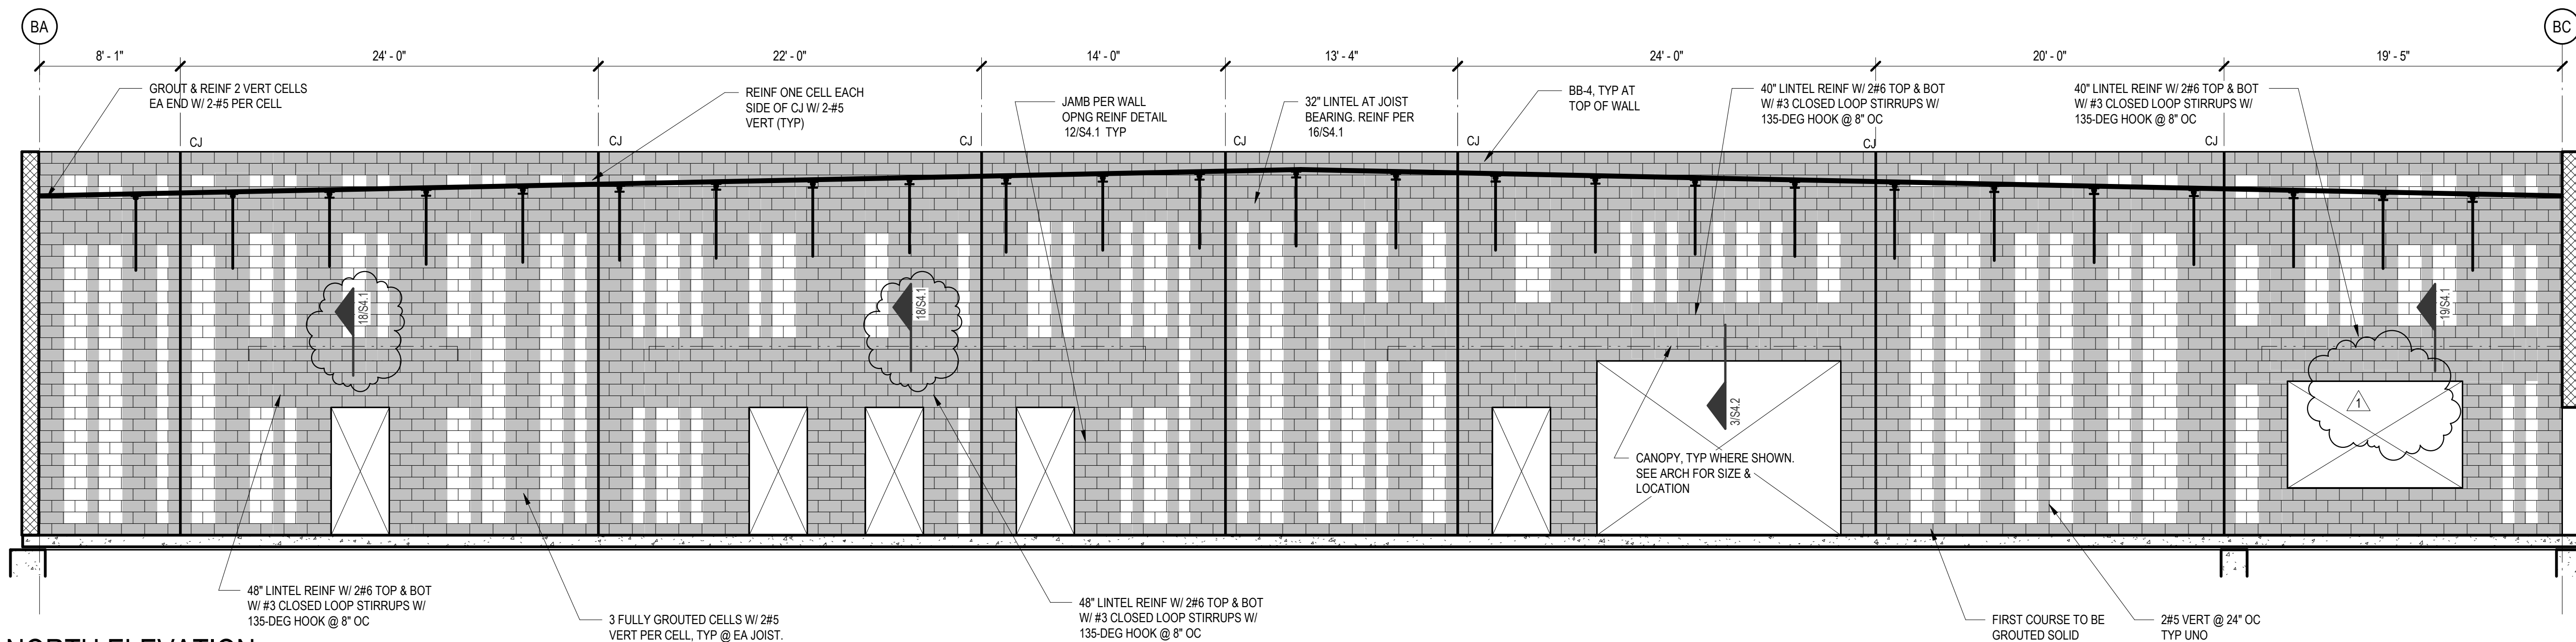

**23 MASONRY WALL - NORTH ELEVATION**


3/16" = 1'-0"

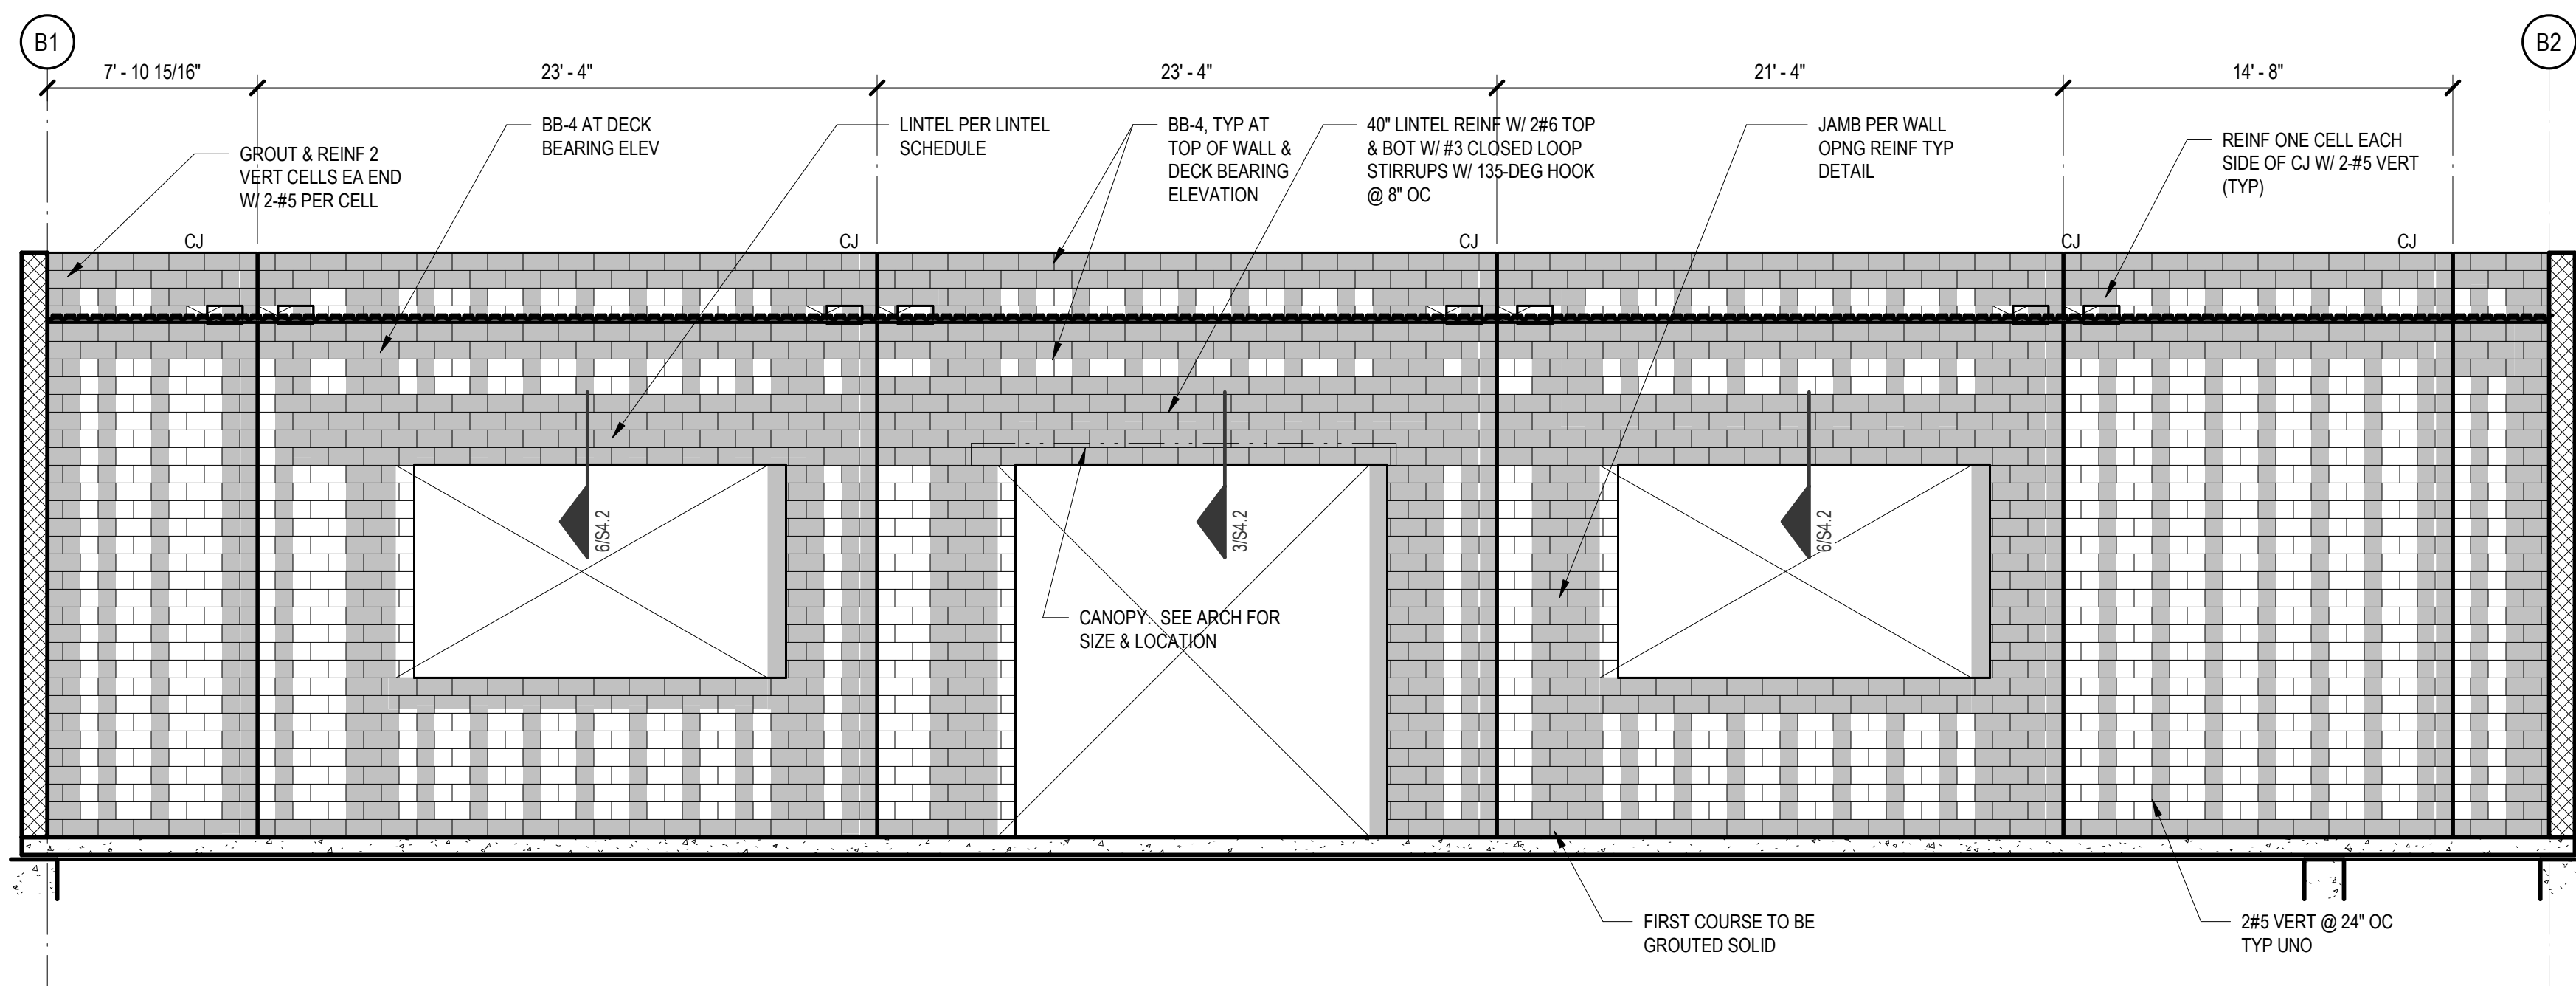

**24 MASONRY WALL - WEST ELEVATION**


3/16" = 1'-0"



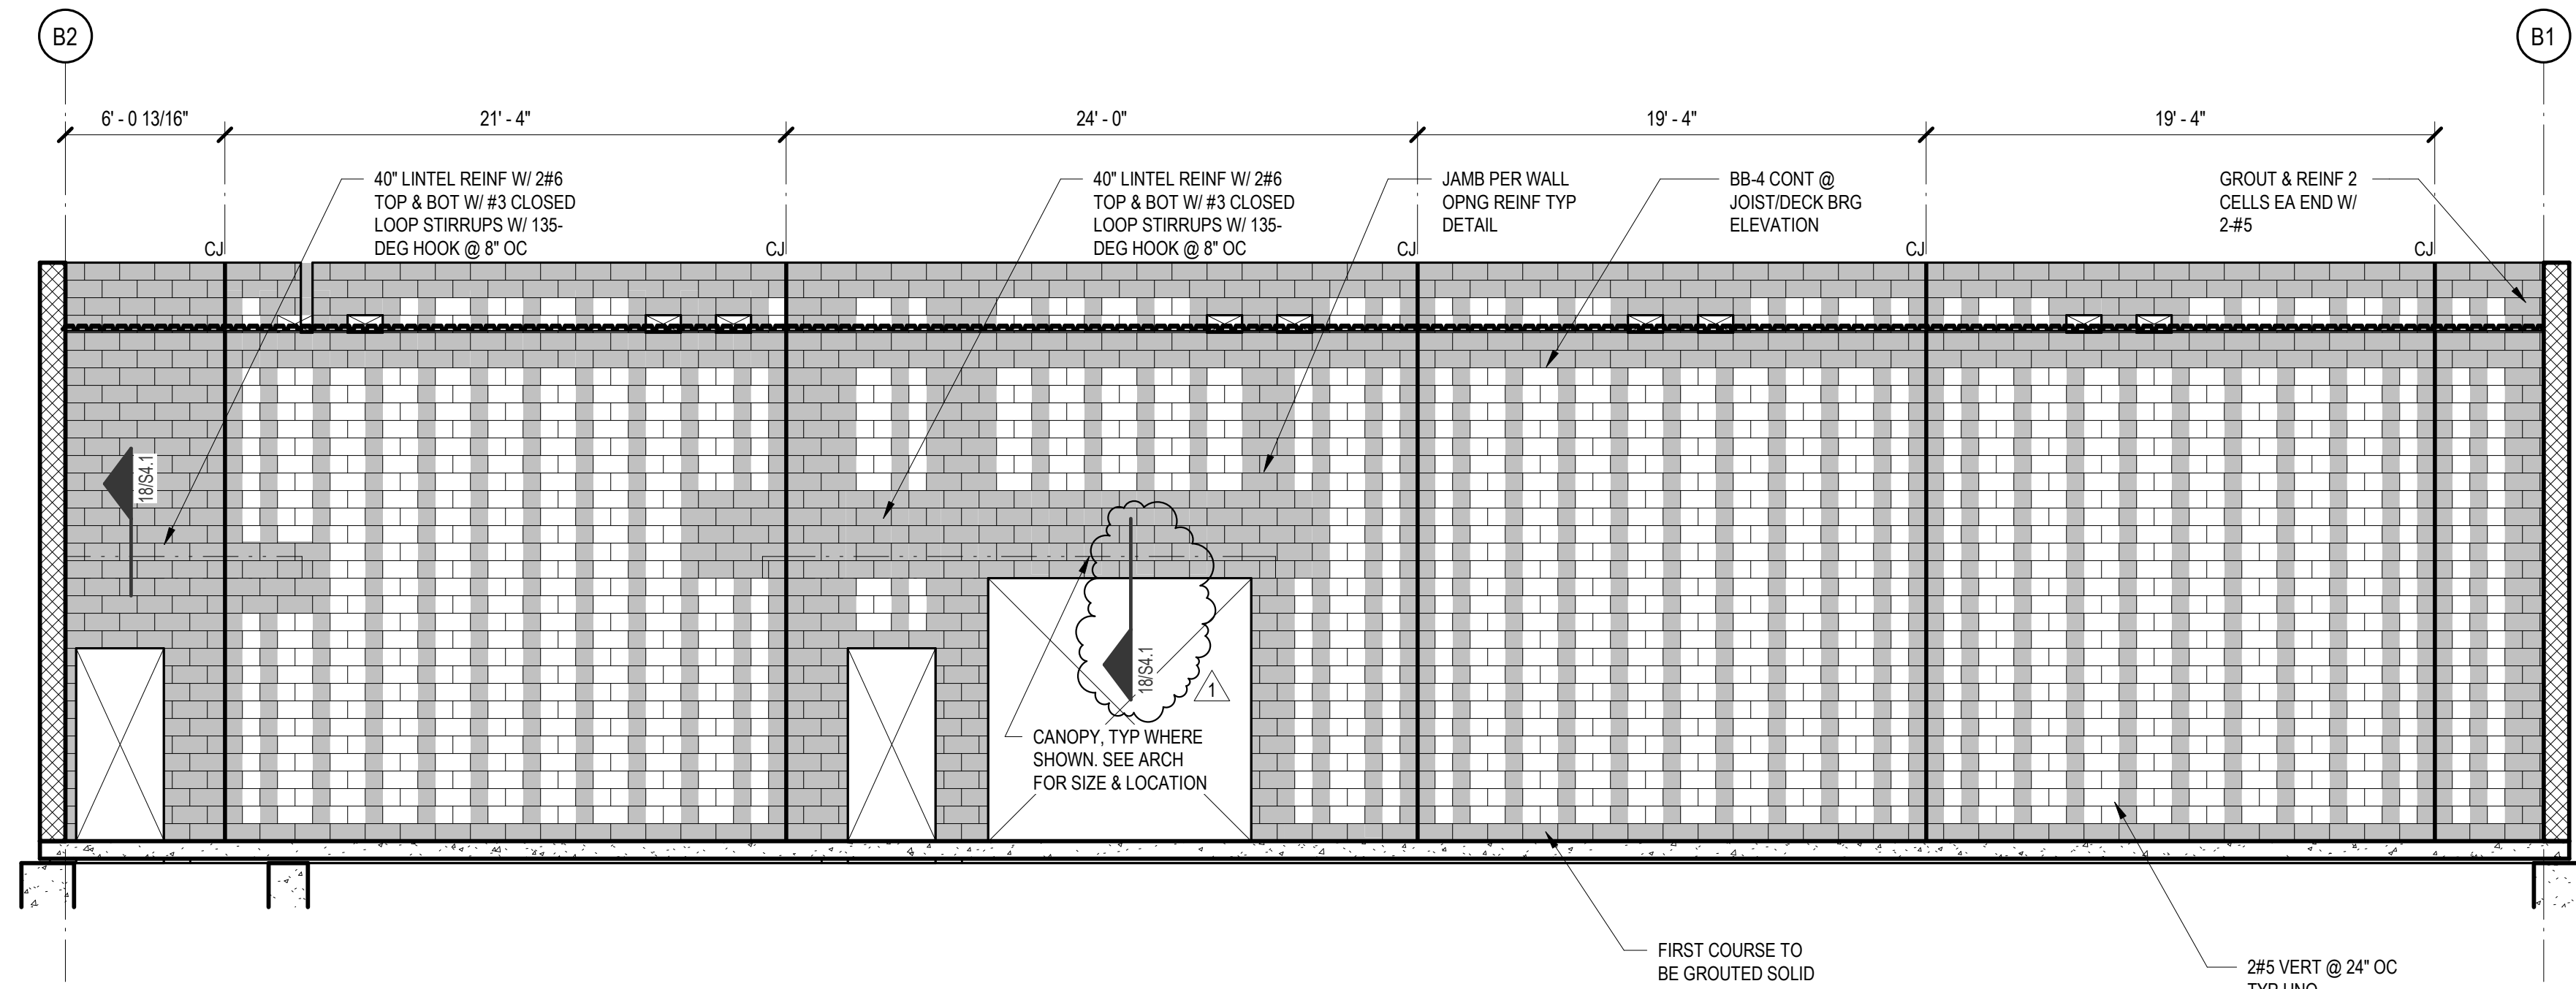


21 MASONRY WALL - EAST ELEVATION

3/16" = 1'-0"

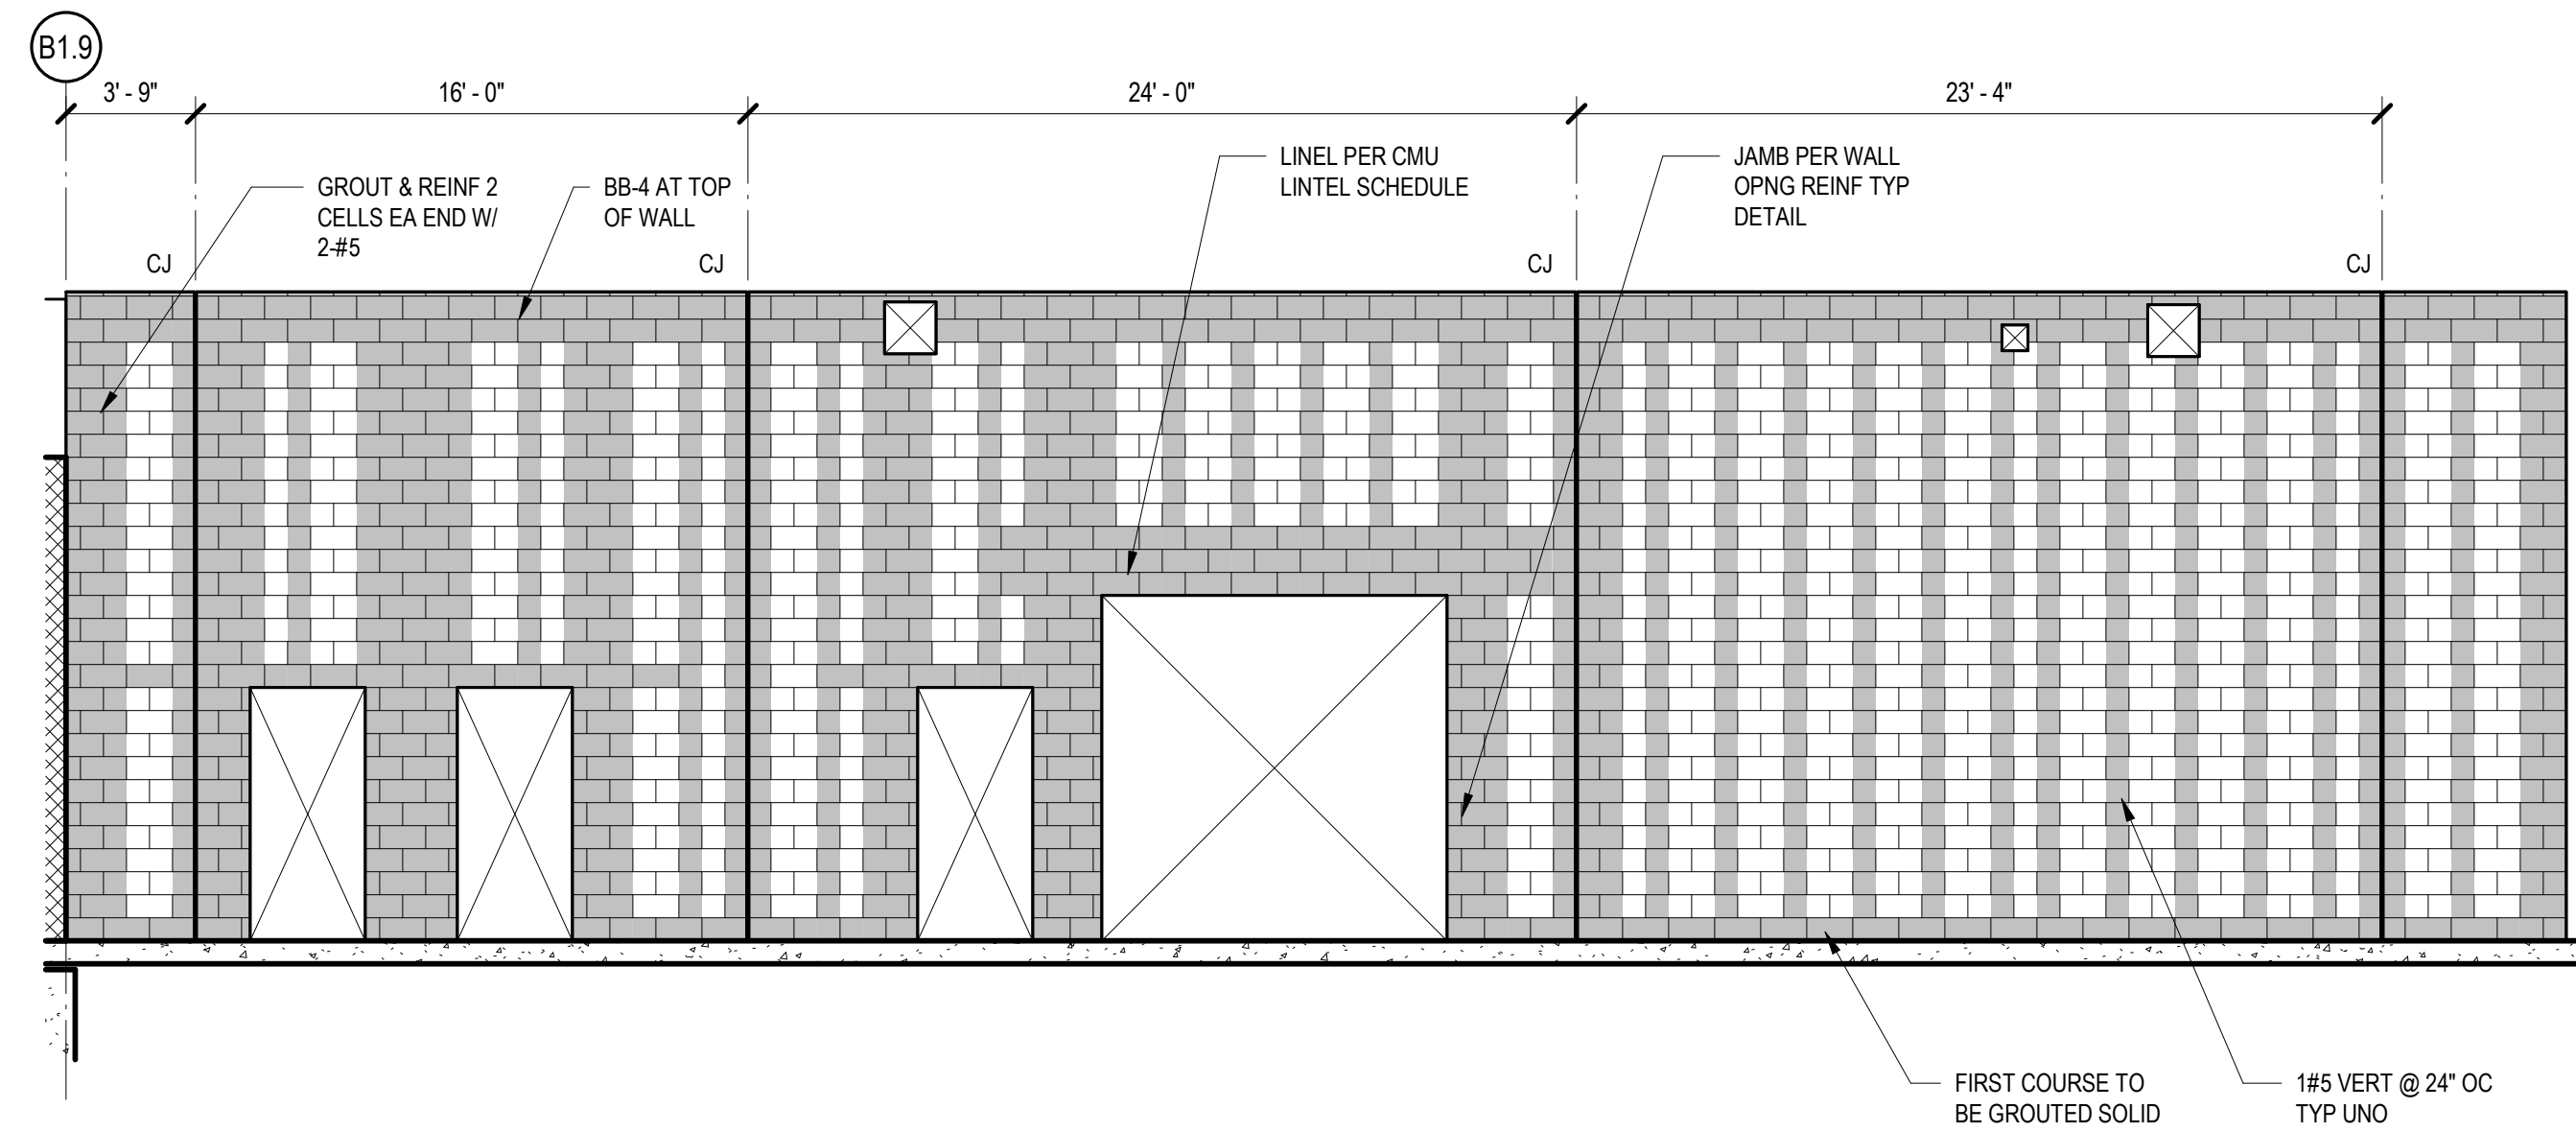

22 MASONRY WALL - GRID BB ELEVATION

3/16" = 1'-0"

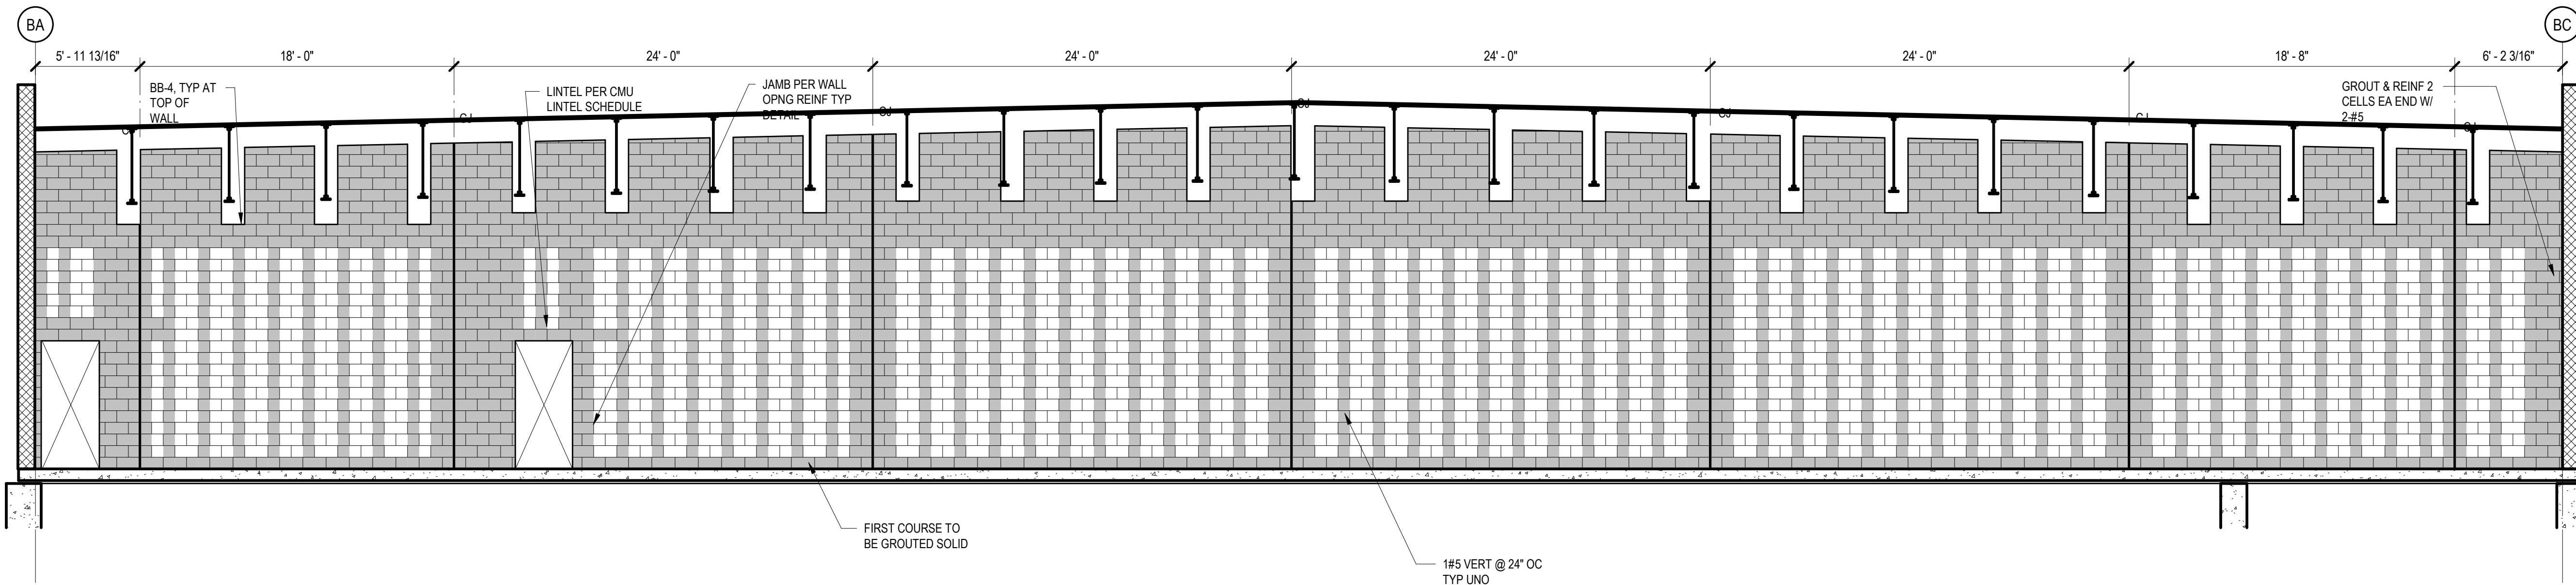

23 MASONRY WALL - B1.9 ELEVATION

3/16" = 1'-0"


Revision / 1

Date 05/15/25

ADDENDUM 03

JOHNSON HIGH SCHOOL  
2025 ADDITIONS  
FOR  
HAYS CISD  
BUDA, TX


Project:

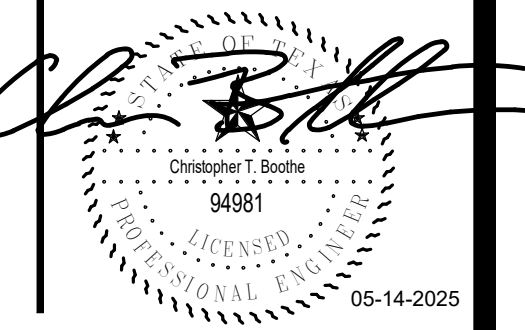

**Huckabee**  
www.huckabee-inc.com  
800.687.1229

MASONRY WALL ELEVATIONS


PACKAGE		VOLUME	
Job No. 1954-07-01	Drawn By: LAFF	Sheet No. ISSUE FOR BID	S4.11
Date: 04/22/2025			

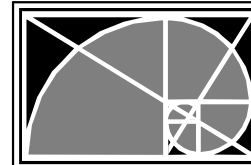

L.A. FUESS PARTNERS, INC.  
Structural Engineers  
3333 Lee Parkway, Suite 300 • Dallas, TX 75219  
LAFF PROJ. NO. 24080 FIRM REG. NO. F-537



PLUMBING FIXTURE SCHEDULE	
<b>NOTES:</b> <div><div><div>1. PROVIDE WASTE, COLD WATER, HOT WATER, AND VENT PIPING TO ALL PLUMBING FIXTURES AS DESCRIBED IN PLUMBING "FIXTURE CONNECTION SCHEDULE."</div><div>2. REFERENCE SPECIFICATIONS FOR ADDITIONAL REQUIREMENTS.</div><div>3. ALL WALL HUNG FIXTURES TO BE INSTALLED WITH WALL CARRIERS, VERIFY CONFIGURATION TYPE.</div><div>4. PROVIDE VANDAL RESISTANT SCREWS AT ALL FIXTURES.</div><div>5. INSTALL STAINLESS STEEL CAPS AT ALL UNUSED LAVATORY FAUCET HOLES.</div><div>6. NO OFFSET FLANGES WILL BE ALLOWED FOR WATER CLOSET INSTALLATIONS.</div><div>7. GROUT FOR LEVELING WATER CLOSETS SHALL NOT EXTEND UP ON SIDE OF WATER CLOSET BASES. TAKE GROUT BACK TO MINIMUM 1/8" UNDER BASE AND CAULK FOR FINAL FINISH. VERIFY CAULK COLOR AND TYPE WITH ARCHITECT.</div><div>8. REFERENCE ARCHITECTURAL CONTRACT DOCUMENTS FOR EXACT LOCATION AND MOUNTING HEIGHTS OF ALL PLUMBING FIXTURES. CONTACT ARCHITECT FOR ADDITIONAL INFORMATION AS REQUIRED.</div><div>9. PROVIDE INVERTED TEE CONNECTION FROM SINK TAILPIECE OR FLUSH VALVE TYPE TRAP PRIMER CONNECTION TO ALL FLOOR DRAINS, FLOOR SINKS AND HUB DRAINS. AS LAST RESORT PROVIDE ELECTRONIC TYPE TRAP PRIMER (SIOUX CHIEF MODEL 695-ES01 FOR UP TO 8 FLOOR DRAINS WITH CORRECT ACCESSORIES). PROVIDE FLUSH MOUNTING BOX WITH KEYED SS COVER. CONNECT TO NEAREST UNSWITCHED 120 VOLT POWER AND PROVIDE DISCONNECTING MEANS. CONNECT TO NEAREST WATER SERVING THAT AREA PER MANUFACTURERS INSTALLATION INSTRUCTIONS.</div><div>10. ALL PLUMBING FIXTURES TO BE LEAD FREE, 80/100 COMPLIANT (.05% OR LESS AVERAGE LEAD CONTENT). PROVIDE DOCUMENTATION IN SUBMITTALS THAT THIS REQUIREMENT IS MET FOR EACH APPLICABLE FIXTURE.</div><div>11. PROVIDE WATER HAMMER ARRESTORS AT ALL PLUMBING FIXTURES. PROVIDE SIZE RECOMMENDED BY MANUFACTURER AND INSTALL IN LOCATIONS AS DIRECTED BY MANUFACTURER.</div></div></div>	
<b>WCH</b> WATER CLOSET (ADULT ADA): AMERICAN STANDARD FLOWISE MODEL 3461.001 WITH EVERCLEAN, FLOOR MOUNTED, VITREOUS CHINA, 1-1/2" TOP SPUD, 16-1/2" HIGH ELONGATED BOWL. EXPOSED FLUSH VALVE: SLOAN ROYAL #111, 1.28 GALLON FLUSH. SEAT: BEMIS 1955C OR EQUIVALENT. STAINLESS STEEL HARDWARE ONLY (NO PLASTIC ALLOWED).	
<b>LH (WALL HUNG-ADULT)</b> LAVATORY (ADA): AMERICAN STANDARD 0356.015, 20" x 18" VITREOUS CHINA, WALL HUNG, 8" FAUCET CENTERS AND GRID STRAINER. PROVIDE WITH TEMPERATURE MIXING VALVE EQUAL TO POWERS HYDROGUARD LF480 SERIES, 0.25 GPM MINIMUM FLOW, ASSE 1070, INTEGRAL CHECKS, 1.2 GPM AT 10 psi DROP. SET AT 105° F MAXIMUM (VERIFY ACTUAL TEMPERATURE REQUIRED WITH OWNER). FAUCET: CHICAGO #404-V317E66BCP, TEMPERED AND COLD WATER, 4" WRIST BLADE HANDLES, AERATOR.	
<b>SKH</b> SINK (ADA): ELKAY #LRAD-2219-55 (OFF-CENTER DRAIN), 18 GAUGE STAINLESS STEEL, SELF-RIM, 18" x 14" x 5.5" DEEP BOWL, THREE (3) FAUCET HOLES WITH STAINLESS STEEL BASKET STRAINER. PROVIDE WITH TEMPERATURE MIXING VALVE EQUAL TO POWERS HYDROGUARD LF480 SERIES, 0.5 GPM MINIMUM FLOW, ASSE 1070, INTEGRAL CHECKS, 1.5 GPM AT 10 psi DROP. SET AT 105° F MAXIMUM (VERIFY ACTUAL TEMPERATURE REQUIRED WITH OWNER). FAUCET: ELKAY #LKD2422BHC, SWING GOOSENECK, WRIST BLADE HANDLES.	
<b>KSH</b> KITCHEN SINK (ADA): ELKAY #LRAD-3319 (OFF-CENTER DRAIN), 18 GAUGE STAINLESS STEEL, SELF-RIM, TWO (2) 14" x 14" x 5.5" DEEP BOWLS, FOUR (4) FAUCET HOLES WITH TWO (2) STAINLESS STEEL BASKET STRAINERS. FAUCET HOLE FOR SIDE SPRAY TO BE 6" FROM ADJACENT HOLE TO ACCOMMODATE 4" WRISTBLADE HANDLE. PROVIDE WITH TEMPERATURE MIXING VALVE EQUAL TO POWERS HYDROGUARD LF480 SERIES, 0.5 GPM MINIMUM FLOW, ASSE 1070, INTEGRAL CHECKS, 1.5 GPM AT 10 psi DROP. SET AT 110° F MAXIMUM (VERIFY ACTUAL TEMPERATURE REQUIRED WITH OWNER). FAUCET: CHICAGO #1102-QN8AE35-317AB, GOOSENECK, TEMPERED AND COLD WATER, 4" WRIST BLADE HANDLES, 1.5 GPM AERATOR, SIDE SPRAY.	
<b>EWCHBF (NON-FILTERED, NO SUBSTITUTIONS - OWNER PREFERENCE)</b> ELECTRIC WATER COOLER WITH BOTTLE FILLER (ADA): ELKAY #VRCGRNTL8WSCX, HIGH EFFICIENCY, NON-FILTERED, SENSOR ACTIVATED BOTTLE FILLING STATION, VANDAL RESISTANT, TWO (2) STATION, VANDAL RESISTANT PUSH BUTTON IN FRONT, VANDAL RESISTANT BUBBLERS, STAINLESS STEEL FINISH, and CANE APRON, 120V-1PH, MODIFIED WITH BOTTLE FILLER ON LOWER RIGHT UNIT. VERIFY EXACT LOCATION OF BOTTLE FILLER WITH ARCHITECT PRIOR TO ORDERING.	
<b>SS</b> SERVICE SINK: FIAT #TSSB-3001, 32" x 32" x 12H ONE-PIECE PRECAST TERRAZO WITH CONTINUOUS STAINLESS STEEL CAPS ON ALL CURBS AND 6" FRONT DROP THRESHOLD, 832-AA HOSE AND HOSE BRACKET, MSG-3232 STAINLESS STEEL WALL GUARD. FAUCET: MOEN R8230 SERVICE SINK FAUCET WITH VACUUM BREAKER, THREADED SPOUT, SERVICE STOPS AND WALL BRACKET. PROVIDE WITH ADDITIONAL HOSE BIBB EQUAL TO WOODFORD MODEL 26 ABOVE SERVICE SINK. THIS HOSE BIBB IS TO BE FED FROM WATTS 009 RPZ FOR CONTINUOUS PRESSURE APPLICATIONS.	
<b>HB</b> HOSE BIBB: WOODFORD MODEL B67 SERIES, IN FLUSH MOUNTING WALL BOX, ASSE 1052 OR 1011 BACKFLOW PROTECTED AUTOMATIC DRAINING, FREEZELESS, NO SPRAYBACK. PROVIDE SHUT-OFF VALVE INSIDE BUILDING IN ACCESSIBLE LOCATION. SLOPE LINE FROM SHUT-OFF VALVE TO WALL HYDRANT TO ALLOW DRAINING OF LINE FOR FREEZE PROTECTION.	
<b>HB2</b> HOSE BIBB (MILD CLIMATE): WOODFORD MODEL 26, METAL WHEEL HANDLE, ASSE 1052 OR 1011 BACKFLOW PROTECTED AUTOMATIC DRAINING, FREEZELESS, NO SPRAYBACK, 1/2" HOSE CONNECTION.	
<b>HBR</b> ROOF MOUNTED HOSE BIBB: WOODFORD MODEL SRH-MS, FREEZELESS, NO DRAIN LINE REQUIRED, ASSE 1057 LISTED, ASSE 1052 LISTED BACKFLOW PREVENTER, MOUNTING SYSTEM, UNDER DECK SUPPORT FLANGE. BALL VALVE FOR SHUT-OFF TO BE LOCATED SO THAT IT IS ACCESSIBLE FROM AN EIGHT FOOT (OR SHORTER) LADDER.	
<b>WB (REFRIGERATOR WALL BOX)</b> WALL BOX FOR CONNECTION TO REFRIGERATOR WATER AND/OR ICE MAKER EQUAL TO SOUX CHIEF 696 SERIES WITH ABS OUTLET BOX, 1/4 TURN VALVE AND ASSE 1010 WATER HAMMER ARRESTOR.	
<b>WH-B1</b> WATER HEATER: A.O.SMITH MODEL DEL-50, 50 GALLON STORAGE, 6KW-208V-1PH NON-SIMULTANEOUS ELEMENTS, 31 GPH RECOVERY AT 80 DEGREES RISE.	
<b>HWRP-B1</b> HOT WATER RECIRCULATION PUMP: GRUNDFOS UPS15-55, THREE SPEED, 4 GPM AT TEN FEET (10') OF HEAD. 1/12 HP-120V-1PH.	
<b>FD</b> FLOOR DRAIN (GENERAL PURPOSE): C-1 BODY, FLASHING COLLAR, WEEPHOLES, ADJUSTABLE HEAVY DUTY STAINLESS STEEL SQUARE TOP (6" X6") AND STAINLESS STEEL SEDIMENT BASKET. MIFAB F1000-C-S-5-6-7 SERIES.	
<b>FS</b> FLOOR SINK: 12" x 12" x 8" DEEP WITH ACID-RESISTING PORCELAIN ENAMEL INTERIOR, ALUMINUM INTERNAL DOME STRAINER, and STAINLESS STEEL GRATE (1/2 GRATE TYPE). MIFAB FS1730-3 SERIES.	
<b>FS1</b> FLOOR SINK: 12" x 12" x 8" DEEP WITH ACID-RESISTING PORCELAIN ENAMEL INTERIOR, ALUMINUM INTERNAL DOME STRAINER, and STAINLESS STEEL GRATE (3/4 GRATE TYPE). MIFAB FS1730-3 SERIES.	
<b>FS2</b> FLOOR SINK: 12" x 12" x 8" DEEP WITH ACID-RESISTING PORCELAIN ENAMEL INTERIOR, ALUMINUM INTERNAL DOME STRAINER, and STAINLESS STEEL GRATE (HINGED FULL GRATE TYPE). MIFAB FS1730-3 SERIES.	
<b>RD1 (PRIMARY)</b> PRIMARY ROOF DRAIN: CAST IRON BODY, FLASHING COLLAR, GRAVEL STOP, GALVANIZED METAL DOME, UNDER DECK CLAMP, EXTENSION AND SUMP RECEIVER. MIFAB R1200-12-B-E-U SERIES.	
<b>RD2 (OVERFLOW)</b> OVERFLOW ROOF DRAIN: SAME AS RD1, SET ADJUSTABLE INLET 2 INCHES HIGHER THAN INLET OF RD1. MIFAB R1200-12-B-E-U-WB. COORDINATE AND CONFIRM FINAL LOCATION WITH ROOFING CONSULTANT PRIOR TO ROUGH-IN.	
<b>DN</b> DISCHARGE NOZZLE: MIFAB R1960, STAINLESS STEEL WITH HINGED PERFORATED COVER. SAME SIZE AS RAINLEADER.	

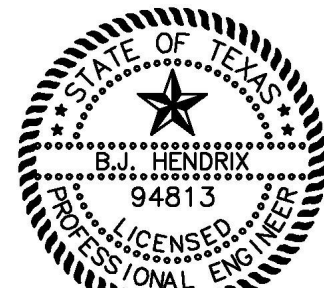

*B. Hendrix*

THE SEAL APPEARING ON THIS DOCUMENT HAS BEEN ISSUED BY THE BOARD OF REGISTRATION OF PROFESSIONAL ENGINEERS, STATE OF TENNESSEE.

REFERENCE GENERAL NOTES ON SHEETS MD.01, PD.01, AND EQ.01 FOR ADDITIONAL INFORMATION





COMMISSIONING & FIELD INVESTIGATIONS  
This document, the ideas and designs incorporated herein are and shall remain the property of Hendrix Consulting Engineers. These documents are not to be used or altered, in whole or in part, for other than the original intended use, nor are they to be assigned to any third party without written permission from Hendrix Consulting Engineers.

F - 4095  
HCE Job no.: 24-033

Addendum No. 3	
Date	05/14/25
Revision /	2

JOHNSON HIGH SCHOOL 2025 ADDITIONS + RENOVATIONS FOR HAYS CISD BUDA, TX	
Project:	

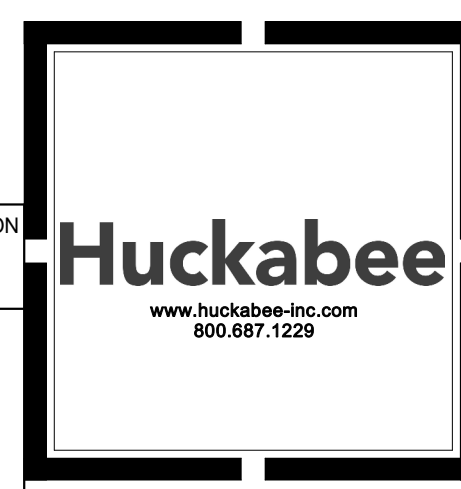 

SCHEDULES - PLUMBING	
PACKAGE	VOLUME
Job No. 1954-07-01	Sheet No. ISSUE FOR BID
Drawn By: KAM	P0.10
Date: 5/14/2025	



ROOFTOP UNIT SCHEDULE																												480/3
NATURAL GAS / ELECTRIC (UNIT TYPES)																												
DX COOLING										SUPPLY FAN					GAS HEATING					ELECTRICAL				MANUFACTURER / MODEL				
UNIT TYPE	NOMINAL TONNAGE	NO. OF COOLING STAGES	NO. OF COMP.	MIN TOTAL MBH	MIN SENSIBLE MBH	MIN SEER	MIN IEER	MIN EER	1ST STAGE CFM	2ND STAGE CFM	3RD STAGE CFM	4TH STAGE CFM	NAME PLATE HP	EXTERNAL STATIC PRESSUR...	DRIVE TYPE	MAX INPUT MBH	OUTPUT MBH	MIN STAGES	HEATING CFM	VOLTS	PHASE	MCA	MOCP	LENNOX	TRANE		MAX WT	
G2	2	1	1	23.1	17.9	14		12.5	800	800			0.33	0.5	Multi-Speed ECM Direct Drive	65	52	1	800	208	1	19	25	KGB024S4E			1100	
G2.5	2.5	2	1	32.8	24.6	17		13.5	700	1000			0.5	0.5	Multi-Speed ECM Direct Drive	60	48	2	1000	480	3	9	15	LGT036H4E			1100	
G3	3	2	1	34.1	27.3	17		13.5	800	1200			0.5	0.5	Multi-Speed ECM Direct Drive	65	52	2	1200	480	3	9	15	LGT036H4E			1100	
G4	4	2	1	51.5	40.2	17		12.8	1070	1600			1	0.5	Multi-Speed ECM Direct Drive	65	52	2	1600	480	3	13	15	LGT048H4E			1100	
G5	5	2	1	57.7	45.0	17		12.7	1350	1950			1	0.5	Multi-Speed ECM Direct Drive	65	52	2	1950	480	3	14	15	LGT060H4E			1100	
G6	6	2	1	70.1	55.4		17	12.1	1540	2300			1.5	0.5	Multi-Speed ECM Direct Drive	65	52	2	2300	480	3	15	20	LGT072H4E			1100	
G7	7.5	3	2	88.0	64.2		15.7	12.3	1750	2300	3000		3.75	0.6	Multi-Speed ECM Direct Drive	130	104	2	3000	480	3	23	25	LGT092H4E			1700	
G8	8.5	3	2	93.3	70.9		15.7	12.1	2000	2700	3400		3.75	0.75	Multi-Speed ECM Direct Drive	130	104	2	3400	480	3	23	25	LGT102H4E			1700	
G10	10	3	2	113.7	84.1		15.5	12	2400	3100	4000		3.75	0.75	Multi-Speed ECM Direct Drive	130	104	2	4000	480	3	25	30	LGT120H4E			1700	
G12	12.5	3	2	135.0	101.0		14.6	10.8	2800	3400	4800		3.75	0.75	Multi-Speed ECM Direct Drive	180	144	2	4800	480	3	30	40	LGT150H4E			1700	
G13	13	3	2	147.2	112.0		15.5	12	3000	3800	5000		3	0.75	Multi-Stage Air Volume Belt	260	208	2	5000	480	3	34	45	LGT156H4M			3000	
G15	15	3	3	172.1	132.5		15	12	3400	4500	6000		3	0.75	Multi-Stage Air Volume Belt	260	208	2	6000	480	3	33	35	LGT180H4M			3000	
G17	17.5	4	4	200.3	150.8		15.5	12	3800	4700	5400	6400	5	1	Multi-Stage Air Volume Belt	260	208	2	6400	480	3	42	45	LGT210H4M			3600	
G20	20	4	4	231.2	174.4		15.8	12	4800	5400	6300	7500	7.5	1	Multi-Stage Air Volume Belt	260	208	2	7500	480	3	49	50	LGT240H4M			3600	
G25	25	4	4	276.0	212.5		14.5	10.6	5700	6800	7900	9500	10	1	Multi-Stage Air Volume Belt	260	208	2	9500	480	3	65	70	LGT300S4M			3600	

ROOF TOP UNIT SCHEDULE NOTES AND ACCESSORIES	
THESE NOTES APPLY TO ALL RTU'S	
ONLY "UNIT TYPES" LISTED IN THE PROJECT SCHEDULE WILL BE USED ON THIS PROJECT.	
UNIT TYPE BREAKDOWN: G = GAS HEAT RTU      E = ELECTRIC HEAT RTU      P = HEAT PUMP RTU	
STANDARD FEATURES TO BE PROVIDED WITH ALL UNITS:	
<p><b>DESIGN CONDITIONS:</b></p> <p>All gross capacities listed are at standard ARI conditions (80/67/95) with standard airflow.</p> <p><b>UNIT CONSTRUCTION (STANDARD FEATURES):</b></p> <p>A. <b>Base pan</b> - Fully insulated under all sections of the unit. B. All units to operate in cooling down to 0 degrees Fahrenheit. C. <b>Service access doors</b> to be hinged with 1/4 turn cam lock handles. D. <b>Condensate drain pan</b> - Stainless Steel or non-corrosive sloped, galvanized pans are not acceptable. E. <b>Supply Fan</b> - High efficiency direct drive blowers with ECM or VFD when available. Belt drive models to have VFD for soft start. F. <b>Variable Frequency Drives (VFD's)</b> - provide with full bypass for use in case of VFD failure. G. <b>Air flow</b> - Units with multiple stages of cooling must have multiple speed supply air fans so that the leaving air temperature in all cooling stages is approximately the same (min 50 degrees F). H. <b>Electric Heaters</b> - provide kw indicated in schedule. I. <b>Propane gas fired units</b> - provide factory or field installed LP conversion kits when schedule or plumbing plans indicate Propane Gas is to be provided to the site. Natural gas parts to be placed inside unit control cabinet. Contractor to verify gas type with all documents. J. <b>Roof curb</b> - Full perimeter roof curb that extends a minimum of 14" above finished roof. curb height to be coordinated with roof insulation and cricket thickness to determine required curb height. Top of curb must be level, coordinate roof slopes with Structural Steel shop drawing. All curbs to have wood nailer. Reference details. K. <b>Pad mounted units</b> - Heavy gauge (min 16 Ga Galvanized) full perimeter curb for pad mounting, minimum 12" tall set on neoprene isolation pads. Ground mounted unit curbs must be installed on a 4" tall concrete house keeping pad. L. <b>Tie Down restraints</b> from RTU to curb as required by code. M. N. O. See specifications for standard accessories, features and controls required. Unit specified sets standards of construction and features.</p> <p><b>UNIT CONSTRUCTION (OPTIONS TO ALWAYS BE INCLUDED):</b></p> <p>A. <b>Hall guards</b> to be painted minimum 18 gauge expanded metal. These are required even with sloped condenser coils. B. <b>Condensate float switch</b> - factory installed and wired (code mandated). C. <b>Stainless Steel</b> heat exchangers. D. <b>Locking refrigerant access port caps</b> on all ports where required by code. Turn keys over to owner. E. <b>HOT-GAS REHEAT:</b> non-modulating hot gas reheat coil equal to Lennox "Humidifit" controlled by wall mounted Dehumidistat (or DDC sensor) to enable dehumidification mode if space humidity rises above 60%(adj) relative humidity (rh) and space is not calling for sensible heating or cooling. Dehumidistat to be located 18" above thermostat unless shown or noted otherwise. Dehumidification must be locked out when space temperature falls below 70 degrees F.</p> <p><b>SPARE PARTS:</b></p> <p>A. <b>Belts:</b> 2 spare sets of belts for each belt drive RTU. B. <b>Filters:</b> 3 sets - 1 set installed plus 2 spare sets of 2" thick pleated filters equal to Camfil Farr 30/30. Install clean set prior to air balance and turn final set over to owner.</p>	<p><b>OUTSIDE AIR:</b></p> <p>A. <b>Raw Outside Air - If scheduled in Project Schedule:</b> provide motorized outside air (O/A) damper with intake hood. Outside Air Damper to only open when Heating or Cooling is operating. 1. <b>Raw O/A - 2 Position Damper Control</b> - (1) Closed / (2) Open to scheduled OA cfm, install a <b>CO2 SENSOR</b> mounted 18" from unit thermostat/sensor to monitor space conditions. <b>Two Position Outside Air Damper</b> opens to scheduled O/A volume only when space is occupied, and CO2 level is above 800 PPM and Heating and Cooling is operating. Closed all other times. 2. <b>Do not provide an economizer for raw O/A intake.</b> B. <b>No Raw Outside Air</b> scheduled or if unit shows only neutral outside air, <b>do not</b> provide an outside air hood and damper. C. <b>Neutral Outside Air:</b> To be provided by a dedicated outside air unit ducted directly to the space or connected to the return duct system of an RTU. Outside air from dedicated outside air units may or may not be listed in the Rooftop Unit Schedule. Contractor to verify final quantities with plan notes and Outside Air Unit Schedules.</p> <p><b>ELECTRICAL:</b></p> <p>A. <b>Voltage and Phase</b> - provide voltage and phase listed in schedule. It is the contractors responsibility to verify electrical service provided with electrical plans and electrical contractor. For remodel and change-out projects the contractor is to field verify what type of electrical service is existing to be reused prior to releasing equipment order. Any discrepancies to be reported to Engineer. B. <b>Phase loss/reversal protection.</b> (3 phase only) C. <b>Mechanical/electrical coordination sheet</b> to be filled out by mechanical contractor and submitted to electrical contractor and engineer (reference specifications) D. <b>Fused disconnects</b> - to be provided by Electrical Contractor. E. <b>Service receptacles</b> - to be provided by the Electrical Contractor as required by code.</p> <p><b>CONTROLS, START-UP, TEST &amp; BALANCE, SUBMITTALS, REFERENCE BLOCK NOTES AND SPECIFICATIONS.</b></p> <p>A. <b>Air purification:</b> mechanical contractor to provide and install bi-polar ion generators for all units listed in schedule. Reference bi-polar ion generators schedule for types and quantities. B. <b>DUCT SMOKE DETECTOR</b> in supply and/or return air duct (as determined by authority having jurisdiction) of each unit provided and wired by fire alarm contractor and installed by mechanical contractor. Fire alarm contractor shall provide a shutdown relay located within unit control compartment and make connections from detector to relay. Controls contractor shall provide wire and connections from control relay to unit controls. If a fire alarm system is not provided the mechanical contractor is to provide and install duct detector(s), shut down relay, remote test switch and audible/visual indicator. C. When DDC controls are provided, all units are to be controlled using a Unit Controller (BACNET) integration not acceptable.</p>
ACCESSORIES AND NOTES: (ONLY PROVIDE ACCESSORIES LISTED IN ACCESSORIES AND NOTE COLUMN IN RTU PROJECT SCHEDULE)	
<div><div><div>1. <b>MULTIPLE THERMOSTATS:</b> units controlled by multiple thermostats, each having equal authority.</div><div>2. <b>CURB ADAPTER:</b> internally lined curb adapter with internal ductwork to adapt new RTU to existing RTU Curb. Field verify existing conditions. Reference sheet notes.</div><div>3. <b>Vibration isolation rails.</b></div><div>4. <b>Cooling only unit.</b> No heat.</div></div><div><div>5. <b>PLENUM CURB:</b> fully insulated (top, bottom and sides insulated with Armaflex sheet with minimum R value) solid bottom plenum curb with insulated divider plate between supply and return sides. Minimum height is 18". Bottom or side discharge as shown on plans</div><div>6. <b>Energy Code Mandated Economizer</b> (minimum 3 position) with barometric relief. Program per specifications, dry bulb control, economizer to be enabled to operate when ambient temperature is below 55 degrees.</div><div>7. <b>Powered exhaust</b> (added to economizer).</div><div>8. Unit serving space that has overhead door. Provide interlock that will shut down unit if the overhead door is open.</div></div></div>	

ROOFTOP UNIT SCHEDULE					
UNIT MARK	UNIT TYPE	O/A CFM		MAU SERVING	ACCESSORIES AND NOTES
RTU-B1	G17	500	NEUTRAL	0	8 3
RTU-B2	G17	500	0		

Copyright © 2025, Huckabee & Associates, Inc.

Date  
05/14/25

Revision /  
2

Addendum No. 3

JOHNSON HIGH SCHOOL  
2025 ADDITIONS + RENOVATIONS  
FOR  
HAYS CISD  
BUDA, TX

Project:



THE SEAL APPEARED ON THIS DOCUMENT WAS RECOVERED BY  
B. J. HENDRIX, P.E. NO. 94813  
ON 05/05/2025

REFERENCE GENERAL NOTES ON  
SHEETS MD.01, PD.01, AND EO.01  
FOR ADDITIONAL INFORMATION

MEPIENERGY CONSULTANTS



COMMISSIONING + FIELD INVESTIGATIONS  
This document, the ideas and designs incorporated herein are and shall remain the property of Hendrix Consulting Engineers. These documents are not to be used or altered, in whole or in part, for other than the original intended use, nor are they to be assigned to any third party without written permission from Hendrix Consulting Engineers.  
F - 4095  
HCE job no.: 24-033

Huckabee

www.huckabee-inc.com  
800.687.1229

SCHEDULES - MECHANICAL

PACKAGE      VOLUME

Job No.  
1954-07-01

Sheet No.  
ISSUE FOR BID

Drawn By:  
KAM

Date:  
04/22/2025


MO.10



## MECHANICAL KEY NOTES


THESE NOTES APPLY TO THIS SHEET ONLY

- M1 DO NOT ROUTE ANY DUCTWORK ABOVE THIS AREA.
- M4 DUCT FROM ROOF TO WALL PENETRATION OF JAN B110 TO BE DOUBLE WALL INSULATED AND PAINTED AS DIRECTED BY THE ARCHITECT.
- M8 DUCT FROM ROOF TO WALL PENETRATION OF STOR B103 TO BE DOUBLE WALL INSULATED AND PAINTED AS DIRECTED BY THE ARCHITECT.

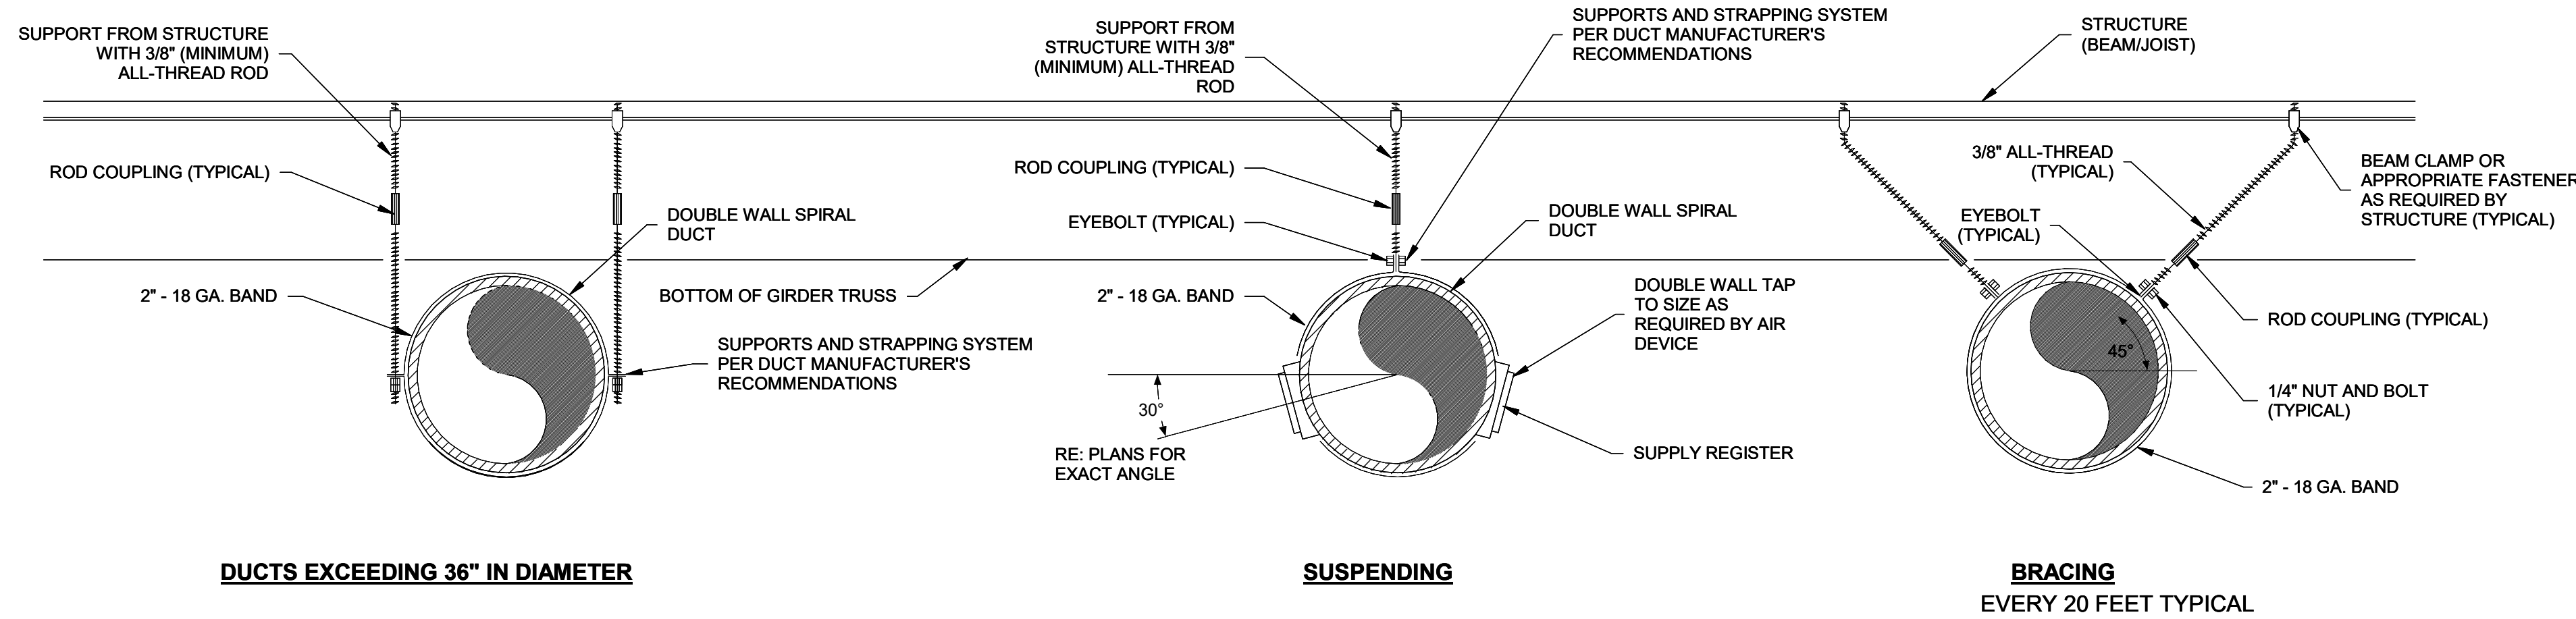


### SPIRAL DUCT DETAILS

NO SCALE MDE72

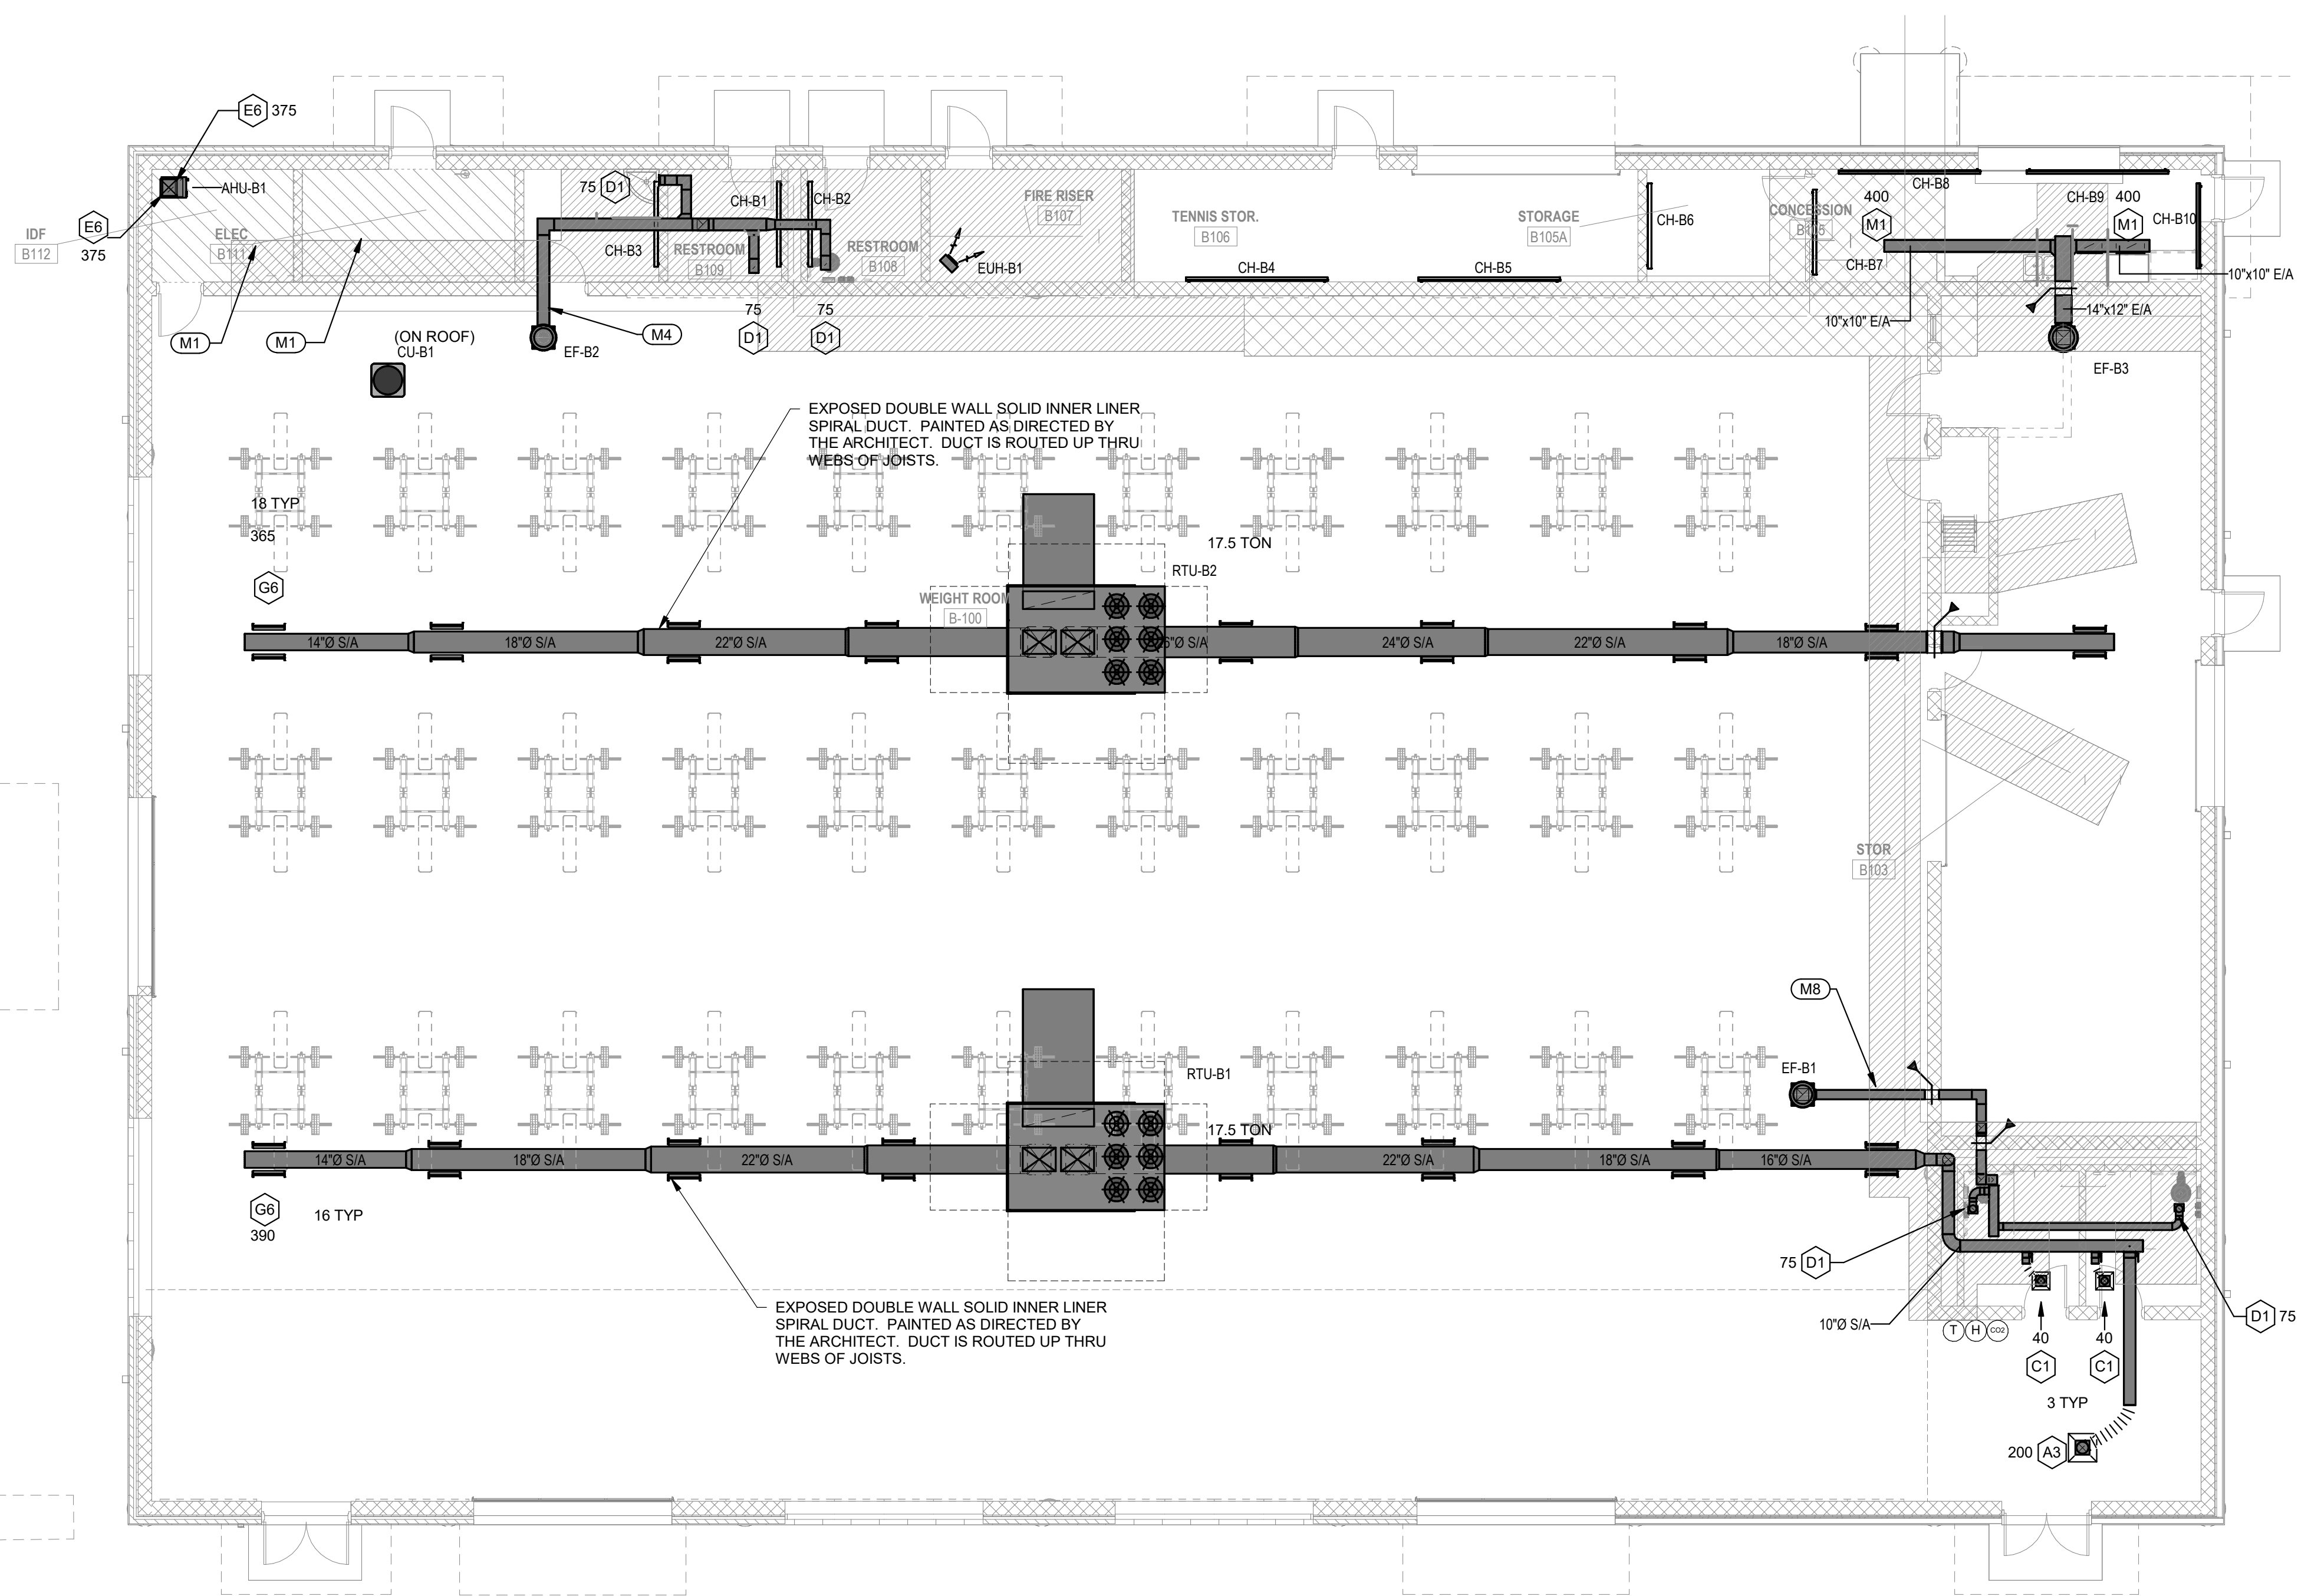

## 01 FIRST FLOOR PLAN - AREA B - MECHANICAL

SCALE: 1/8" = 1'-0"

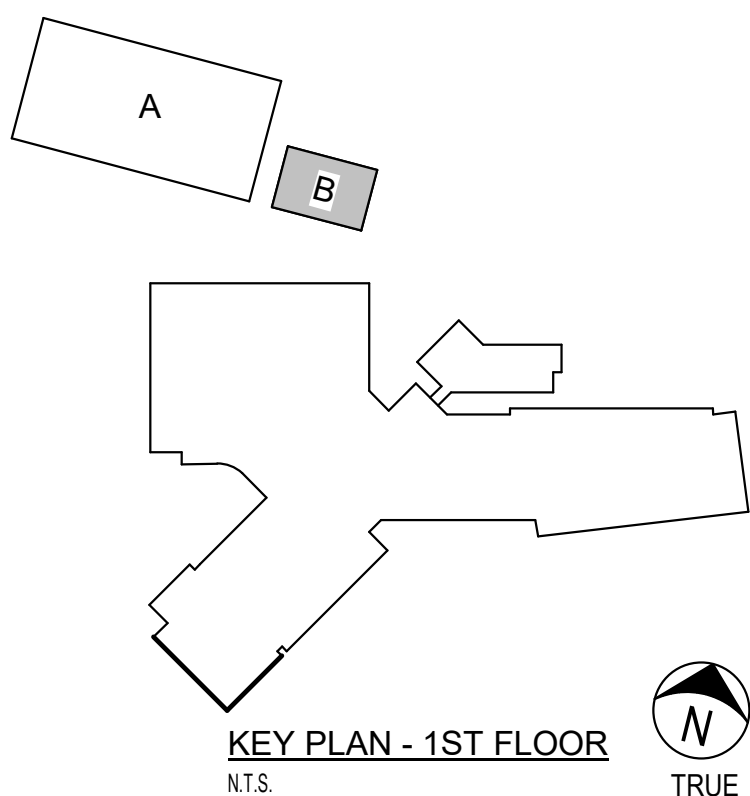

*B. Hendrix*

THE SEAL APPEARING ON THIS DOCUMENT HAS BEEN PREPARED BY A LICENSED PROFESSIONAL ENGINEER IN THE STATE OF TEXAS.

REFERENCE GENERAL NOTES ON SHEETS M0.01, P0.01, AND E0.01 FOR ADDITIONAL INFORMATION

MEPIENERGY CONSULTANTS



COMMISSIONING + FIELD INVESTIGATIONS

This document, the ideas and designs incorporated herein are and shall remain the property of Hendrix Consulting Engineers. These documents are not to be used or altered, in whole or in part, for other than the original intended use, nor are they to be assigned to any third party without written permission from Hendrix Consulting Engineers.

F - 4095

HCE job no.: 24-033

Date: 04/22/2025

JOHNSON HIGH SCHOOL  
2025 ADDITIONS + RENOVATIONS  
FOR  
HAYS CISD  
BUDA, TX

Project:

**Huckabee**

www.huckabee-inc.com  
800.687.1229

**FIRST FLOOR PLAN - AREA B - MECHANICAL**

PACKAGE VOLUME

Job No. 1954-07-01

Sheet No. ISSUE FOR BID

Drawn By: KAM

Date: 04/22/2025

M2.12



MISCELLANEOUS EQUIPMENT SCHEDULES

<b>GENERAL NOTES:</b> A. ELECTRICIAN TO PROVIDE 120V POWER TO ALL EQUIPMENT FROM NEAREST PANEL HAVING CAPACITY, UNLESS OTHERWISE NOTED.  B. ELECTRICAL CONTRACTOR IS TO PROVIDE ALL PARTS AND LABOR TO MAKE FINAL CONNECTIONS TO ALL EQUIPMENT SHOWN IN CONTRACT DOCUMENTS. POWER MAY BE SHOWN IN GENERAL LOCATION. IT IS EXPECTED THAT THE ELECTRICAL CONTRACTOR COORDINATE FINAL LOCATION FOR ROUGH-IN AND CONNECTION REQUIREMENTS WITH EXACT EQUIPMENT BEING INSTALLED. THESE ITEMS INCLUDE, BUT NOT LIMITED TO, BOOK SECURITY, EXHAUST FANS, KILNS, HAND DRYERS, SENSOR OPERATED PULPING DEVICES, ELECTRIC OVERHEAD DOORS, FIRE SMOKE DAMPERS, AIR PURIFICATION UNITS, ETC.	
<b>DAIKIN VRF AC SYSTEMS</b> REFERENCE FLOORPLANS. PROVIDE SNAP SWITCH AT ALL BRANCH SELECTORS AND FCU FOR DISCONNECTING MEANS. CIRCUIT SHOWN. PROVIDE DISCONNECTS AS SHOWN FOR ALL AHUS AND HRUS. REFER TO PIPING AND WIRING DIAGRAMS ON THE MECHANICAL SHEETS FOR ADDITIONAL INFORMATION.  <b>DAIKIN MINI-SPLIT AC SYSTEMS</b> POWER IS CONNECTED TO OUTDOOR UNIT. INDOOR UNIT IS FED FROM OUTDOOR UNIT AND POWER AND COMMUNICATION WIRES MUST BE RUN IN ITS OWN DEDICATED CONDUIT. REFERENCE PLANS AND MANUFACTURER'S INSTALLATION MANUAL.  <b>LIGHTING CONTROL</b> REFERENCE LIGHTING CONTROL DETAILS AND NOTES. 1. EXTERIOR LIGHTS BY BAS. 2. INTERIOR LIGHTS BY 'NIGHT'.  <b>POWER FOR SPECIAL SYSTEMS POWER SUPPLIES</b> 1. ELECTRICAL CONTRACTOR TO PROVIDE POWER TO ALL SECURITY, FIRE ALARM, ACCESS CONTROL, ETC. POWER SUPPLIES. COORDINATE EXACT LOCATION WITH SPECIAL SYSTEMS CONTRACTOR AND FLOOR PLANS. PROVIDE DEDICATED LOW VOLTAGE CIRCUIT TO NEAREST PANEL HAVING CAPACITY U.O.N. 2. LABEL ALL SPECIAL SYSTEMS POWER SUPPLIES WITH PANEL AND CIRCUIT NUMBERS.  <b>POWER ON FURNITURE ISLANDS</b> PROVIDE 170 MINIMUM IN SLAB OR UNDER FLOOR TO FEED PLUGS DEVICES SHOWN ON CABINETS OR MILLWORK NOT ATTACHED TO WALLS.  <b>RECEPTACLES AT MILLWORK</b> COORDINATE FINAL RECEPTACLE LOCATIONS AND ELEVATIONS WITH MILLWORK SHOP DRAWINGS PRIOR TO ROUGH-IN. REVIEW ARCHITECTURAL INTERIORS ELEVATIONS FOR FINAL LAYOUTS OF EQUIPMENT TO BE POWERED. REFERENCE DEVICE MOUNTING HEIGHT DETAIL FOR MOUNTING HEIGHTS.  <b>ELECTRIC WATER COOLER (EWC) POWER</b> RECEPTACLE FOR POWER TO BE LOCATED BEHIND EWC AND HAVE GFCI BREAKER AT PANEL. COORDINATE FINAL ROUGH-IN LOCATION WITH ACTUAL EQUIPMENT.  <b>MOTORIZED CURTAIN / BLINDS / SHADES</b> CIRCUIT IS SHOWN IN GENERAL AREA AND DOES NOT REPRESENT QUANTITY OF LINE VOLTAGE CONNECTIONS. COORDINATE WITH ARCHITECT SPECIFICATIONS, SCHEDULES AND EXACT CURTAIN BEING PROVIDED FOR ALL ROUGH-IN REQUIREMENTS. CONNECT POWER TO MASTER CONTROL UNIT AND EACH CURTAIN / BLINDS / SHADES PER MANUFACTURE RECOMMENDATIONS. THIS INFO FOR BIDDING PURPOSES ONLY PROVIDE ALL REQUIRED COMPONENTS FOR COMPLETE WORKABLE SYSTEM. PROVIDE ROUGH-IN AND CONNECTING CONDUIT FOR CONTROL OF BLINDS. WHEN NO LOCATION FOR CONTROL CAN BE COORDINATED, LOCATE NEXT TO ROOM LIGHT SWITCH AND LABEL. COORDINATE FINAL ROUGH-IN LOCATION AND FINAL REQUIREMENTS WITH OWNER/ARCHITECT.  <b>MOTORIZED DAMPERS</b> PROVIDE 120V POWER TO ALL MOTORIZED DAMPERS SHOWN ON MECHANICAL DRAWINGS. COORDINATE DAMPER CONTROL REQUIREMENTS WITH MECHANICAL DRAWINGS.  <b>EXHAUST FAN</b> ELECTRICAL CONTRACTOR SHALL WIRE ALL EXHAUST FANS TO BE CONTROLLED PER 'EXHAUST FAN SCHEDULE' ON MECHANICAL SHEET. ELECTRICAL CONTRACTOR TO PROVIDE ALL RELAYS, CONTACTORS, SPRING WOUND TIMERS, ETC., AS REQUIRED PER SCHEDULE TO OPERATE AND CONTROL EXHAUST FAN. IF NO CONTROL IS SPECIFIED, EXHAUST FAN SHALL ENERGIZE WHEN LIGHTS IN ANY ROOM IT SERVES ARE POWERED ON. REFERENCE DETAIL ON ELECTRICAL SHEET FOR ADDITIONAL INFORMATION.  <b>PROJECTION SCREEN</b> PROVIDE POWER FOR SCREEN. PROVIDE ROUGH-IN AND CONNECTING CONDUIT FOR CONTROL OF SCREEN. COORDINATE EXACT ROUGH-IN LOCATION AND FINAL REQUIREMENTS WITH OWNER/ARCHITECT.  <b>FIRE DOOR</b> POWER FOR FIRE DOOR. COORDINATE FINAL LOCATION AND POWER REQUIREMENTS WITH ACTUAL DOOR BEING SUPPLIED. INSTALL KEYED SWITCHES PROVIDED BY DOOR MANUFACTURER ON BOTH SIDES.  <b>MOTORIZED OVERHEAD DOORS</b> PROVIDE POWER FOR DOOR AS SHOWN ON PLANS. PROVIDE SNAP SWITCH AS DISCONNECTING MEANS ADJACENT TO DOOR ABOVE CEILING. PROVIDE ABOVE CEILING CONTROLS J-BOX WITH CONDUIT TO DOOR OPERATOR FOR CONTROLS CABLE ROUTING. PROVIDE J-BOX AT MID-OPENING HEIGHT WITH CONDUIT TO ABOVE CEILING CONTROLS J-BOX ON ONE SIDE OF DOOR FOR BOTTOM BAR SENSING EDGE CONNECTIONS. PROVIDE J-BOX AT 6" AFF ON EACH SIDE OF DOOR WITH CONDUIT TO ABOVE CEILING CONTROLS J-BOX FOR PHOTO EYES ON EACH SIDE OF DOOR. PROVIDE J-BOX FOR DOOR CONTROL STATION AT LOCATION DIRECTED BY ARCHITECT OR OWNER WITH CONDUIT TO ABOVE CEILING CONTROLS J-BOX. PROVIDE CONTROL WIRES AS SPECIFIED BY THE MANUFACTURER AND MAKE ALL CONNECTIONS REQUIRED IN INSTALLATION MANUAL. DO NOT MAKE ANY CONNECTIONS THAT ARE INDICATED TO BE COMPLETED BY THE DOOR CONTRACTOR IN THE INSTALLATION MANUAL.	

BRANCH CIRCUIT WIRE AND CONDUIT SCHEDULE

<b>NOTE:</b> A. PROVIDE INDIVIDUAL NEUTRALS FOR EACH CIRCUIT. NO SHARED NEUTRALS ALLOWED.	
C - CONDUIT	G - GROUND
L - LINE OR PHASE	N - NEUTRAL
MARK WIRE AND CONDUIT	SYSTEM MARK WIRE AND CONDUIT
① 2#12, 1/2".	LN ③2 3#4, 1".
② 2#12, 1/2".	LLG ③3 3#4, 1#8G, 1" C.
③ 2#12, 1/2".	LLG ③4 3#4, 1#8G, 1" C.
④ 3#12, 1/2".	LLG ③5 4#4, 1#8G, 1 1/4" C.
⑤ 3#12, 1/2".	LLNG ③6 2#3, 1" C.
⑥ 3#12, 1/2".	LLNG ③7 2#3, 1#8G, 1" C.
⑦ 4#12, 1/2".	LLNG ③8 2#3, 1#8G, 1" C.
⑧ 2#10, 1/2".	LN ③9 3#1, 1" C.
⑨ 2#10, 1/2".	LLG ④0 3#3, 1#8G, 1 1/4" C.
⑩ 2#10, 1/2".	LLG ④1 3#3, 1#8G, 1 1/4" C.
⑪ 2#10, 1/2".	LLG ④2 4#3, 1#8G, 1 1/4" C.
⑫ 3#10, 1/2".	LLNG ④3 2#2, 1" C.
⑬ 3#10, 1/2".	LLG ④4 2#2, 1#8G, 1" C.
⑭ 4#10, 1/2".	LLNG ④5 2#2, 1#8G, 1" C.
⑮ 2#8, 1/2" C.	LN ④6 3#2, 1 1/4" C.
⑯ 2#8, 1/2".	LLNG ④7 3#2, 1 1/4" C.
⑰ 2#8, 1/2".	LLG ④8 3#2, 1#8G, 1 1/4" C.
⑱ 3#8, 3/4" C.	LLG ④9 4#2, 1#8G, 1 1/4" C.
⑲ 3#8, 1/2".	LLNG ⑤0 2#1, 1 1/4" C.
⑳ 3#8, 1/2".	LLG ⑤1 2#1, 1#8G, 1 1/4" C.
㉑ 4#8, 1/2".	LLNG ⑤2 2#1, 1#8G, 1 1/4" C.
㉒ 2#6, 3/4" C.	LN ⑤3 3#1, 1 1/2" C.
㉓ 2#6, 1/2".	LLG ⑤4 3#1, 1#8G, 1 1/2" C.
㉔ 2#6, 1/2".	LLG ⑤5 3#1, 1#8G, 1 1/2" C.
㉕ 3#6, 3/4" C.	LLG ⑤6 4#1, 1#8G, 1 1/2" C.
㉖ 3#6, 1/2".	LLG ⑤7 2#10, 1 1/4" C.
㉗ 3#6, 1/2".	LLG ⑤8 2#10, 1#8G, 1 1/2" C.
㉘ 4#6, 1/2".	LLNG ⑤9 2#10, 1#8G, 1 1/2" C.
㉙ 2#4, 3/4" C.	LN ⑥0 3#10, 1 1/2" C.
㉚ 2#4, 1#8G, 1" C.	LLG ⑥1 3#10, 1#8G, 2" C.
㉛ 2#4, 1#8G, 1" C.	LLG ⑥2 3#10, 1#8G, 2" C.

ELECTRICAL ABBREVIATION SCHEDULE

A	AMPERES	MECH	MECHANICAL																																																																
AC	AIR CONDITIONING	MIN	MINIMUM																																																																
AF	ABOVE FINISHED FLOOR	MIS	MISCELLANEOUS																																																																
AL	AUXILIARY HAVING JURISDICTION	ML	MAIN LINE ONLY																																																																
AU	ALUMINUM	MSB	MAIN SWITCHBOARD																																																																
AUX	AUTOMATIC	NEC	NATIONAL ELECTRICAL CODE																																																																
BFF	BELOW FINISHED FLOOR	NEMA	NATIONAL ELECTRICAL MANUFACTURERS ASSOCIATION																																																																
BLDG	BUILDING	NE	NON-FUSED																																																																
C	CONDUIT	NIC	NOT IN CONTRACT																																																																
CB	CIRCUIT BREAKER	OC	ON CENTER(S)																																																																
CKT	CIRCUIT	OT	OVERHEAD																																																																
COL	COLUMN	PC	PLUMBING CONTRACTOR																																																																
CONC	CONCRETE	PH	PHASE																																																																
CONST	CONSTRUCTION	PNL	PANEL																																																																
CONTR	CONTRACTOR	PVC	POLYVINYL CHLORIDE																																																																
CITY	CABLE TELEVISION	REC	REFERENCE/REFER TO																																																																
DWG	DRAWING	RECP	RECEPTACLE																																																																
EW	ELECTRICAL CONTRACTOR	RGS	RIGID GALVANIZED STEEL CONDUIT																																																																
EF	EXHAUST FAN	RM	ROOM																																																																
DN	DOWN	SCH	SCHEDULE																																																																
EL	ELECTRIC/ELECTRICAL	SD	EXISTING																																																																
EMT	ELECTRICAL METALLIC TUBING	SPD	SURGE PROTECTIVE DEVICE																																																																
EQUIP	EQUIPMENT	TEL	TELEPHONE </tr <tr><td>EX</td><td>EXISTING</td><td>TTB</td><td>TELEPHONE TERMINAL BOARD</td></tr> <tr><td>FA</td><td>FIRE ALARM</td><td>TYP</td><td>TYPICAL</td></tr> <tr><td>FF</td><td>FIRE ALARM FINISHED FLOOR</td><td>UC</td><td>UNDERGROUND CONDUIT</td></tr> <tr><td>FLR</td><td>FLOOR/FLOORING</td><td>UE</td><td>UNDERGROUND ELECTRIC</td></tr> <tr><td>G</td><td>GROUND</td><td>UL</td><td>UNDERWRITERS LABORATORIES</td></tr> <tr><td>GFI</td><td>GROUND FAULT INTERRUPT</td><td>UON</td><td>UNLESS OTHERWISE NOTED</td></tr> <tr><td>HD</td><td>HEAVY DUTY</td><td>UT</td><td>UNDERGROUND TELEPHONE</td></tr> <tr><td>HP</td><td>HORSEPOWER</td><td>V</td><td>VOLTS/VOLTAGE</td></tr> <tr><td>IMC</td><td>INTERMEDIATE METAL CONDUIT</td><td>VA</td><td>VOLT-AMPERES</td></tr> <tr><td>KVA</td><td>KILOVOLT-AMPERES</td><td>W</td><td>WATTS</td></tr> <tr><td>KW</td><td>KILOWATTS</td><td>W/</td><td>WITH</td></tr> <tr><td>LGT</td><td>LIGHT/LIGHTING</td><td>W/O</td><td>WITHOUT</td></tr> <tr><td>MAX</td><td>MAXIMUM</td><td>WP</td><td>WEATHER PROOF</td></tr> <tr><td>MC</td><td>MECHANICAL CONTRACTOR</td><td>XFMR</td><td>TRANSFORMER</td></tr> <tr><td>MCB</td><td>MAIN CIRCUIT BREAKER</td><td></td><td></td></tr> <tr><td>MDP</td><td>MAIN DISTRIBUTION PANEL</td><td></td><td></td></tr>	EX	EXISTING	TTB	TELEPHONE TERMINAL BOARD	FA	FIRE ALARM	TYP	TYPICAL	FF	FIRE ALARM FINISHED FLOOR	UC	UNDERGROUND CONDUIT	FLR	FLOOR/FLOORING	UE	UNDERGROUND ELECTRIC	G	GROUND	UL	UNDERWRITERS LABORATORIES	GFI	GROUND FAULT INTERRUPT	UON	UNLESS OTHERWISE NOTED	HD	HEAVY DUTY	UT	UNDERGROUND TELEPHONE	HP	HORSEPOWER	V	VOLTS/VOLTAGE	IMC	INTERMEDIATE METAL CONDUIT	VA	VOLT-AMPERES	KVA	KILOVOLT-AMPERES	W	WATTS	KW	KILOWATTS	W/	WITH	LGT	LIGHT/LIGHTING	W/O	WITHOUT	MAX	MAXIMUM	WP	WEATHER PROOF	MC	MECHANICAL CONTRACTOR	XFMR	TRANSFORMER	MCB	MAIN CIRCUIT BREAKER			MDP	MAIN DISTRIBUTION PANEL		
EX	EXISTING	TTB	TELEPHONE TERMINAL BOARD																																																																
FA	FIRE ALARM	TYP	TYPICAL																																																																
FF	FIRE ALARM FINISHED FLOOR	UC	UNDERGROUND CONDUIT																																																																
FLR	FLOOR/FLOORING	UE	UNDERGROUND ELECTRIC																																																																
G	GROUND	UL	UNDERWRITERS LABORATORIES																																																																
GFI	GROUND FAULT INTERRUPT	UON	UNLESS OTHERWISE NOTED																																																																
HD	HEAVY DUTY	UT	UNDERGROUND TELEPHONE																																																																
HP	HORSEPOWER	V	VOLTS/VOLTAGE																																																																
IMC	INTERMEDIATE METAL CONDUIT	VA	VOLT-AMPERES																																																																
KVA	KILOVOLT-AMPERES	W	WATTS																																																																
KW	KILOWATTS	W/	WITH																																																																
LGT	LIGHT/LIGHTING	W/O	WITHOUT																																																																
MAX	MAXIMUM	WP	WEATHER PROOF																																																																
MC	MECHANICAL CONTRACTOR	XFMR	TRANSFORMER																																																																
MCB	MAIN CIRCUIT BREAKER																																																																		
MDP	MAIN DISTRIBUTION PANEL																																																																		

SPECIAL SYSTEM SYMBOL SCHEDULE

<b>NOTE:</b> A. REFERENCE OWNER SPECIFICATIONS FOR ADDITIONAL INFORMATION. B. THIS IS FOR GENERAL LOCATION ONLY. ALL DEVICES AND CABLING PER OWNER SPECIFICATIONS. C. ALL DEVICE HEIGHTS ARE REFERENCED TO CENTER OF DEVICE.	
SYMBOL	DESCRIPTION
	FIRE ALARM CONTROL PANEL
	FIRE ALARM ANNUNCIATOR PANEL
	REMOTE VOICE EVACUATION PANEL
	SPEAKER, WALL MOUNTED WEATHER RESISTANT, 120" AFF U.O.N.
	TELEVISION POWER, 72" AFF U.O.N. OR SPECIFIED BY TECHNOLOGY CONSULTANT/OWNER
	UTILITY CONTROLLER (REFERENCE UTILITY CONTROLLER BLOCK NOTE)
	CLOCK, SINGLE FACED WALL MOUNTED, 96" AFF UON
	CLOCK, DOUBLE FACED WALL MOUNTED, 96" AFF UON
	CENTRAL DISPLAY UNIT
	WEATHER PROOF EXTERIOR FIRE ALARM HORN
	SECURITY KEY PAD, 48" AFF UON
	BADGE READER FOR SECURITY SYSTEM, 48" AFF UON
	LIGHTING RELAY ZONE OVERRIDE CONTROL BUTTON
	MICROPHONE JACK
	ROUGH-IN FOR CAMERA (WEATHERPROOF BOX FLUSH WITH EXTERIOR WALL)
	CEILING MOUNTED CAMERA LOCATION (DATA DROP, CAMERA BY OTHERS)
	INTERCOM PROGRAM PHONE LOCATION
	MAC DOOR HOLD OPEN, POWERED BY SPECIAL SYSTEMS
	LOCK DOWN DEVICE
	120V POWER FOR DOOR SECURITY POWER SUPPLY (COORDINATE WITH DOOR MFR)
	120V POWER FOR HANDICAP DOOR POWER SUPPLY (REF MISC EQUIPMENT SCHEDULE)
	DOOR BUZZER, CONFIRM LOCATION WITH OWNER
	INTERCOM VOLUME CONTROL
	OVERHEAD DOOR POWER
	OVERHEAD DOOR CONTROL LOCATION
	INTERCOM SPEAKER
	HAND DRYER POWER (PROVIDE SNAP SWITCH DISCONNECT ABOVE CEILING)
	DISHWASHER POWER
	CIRCULATING FAN POWER
	WALL MOUNTED MOTION SENSOR
	FIRE SPRINKLER POWER
	MOTORIZED BLINDS

DEVICE SYMBOL SCHEDULE

<b>NOTES:</b> A. ALL SYMBOLS DO NOT NECESSARILY APPEAR ON THESE DRAWINGS. B. ALL DEVICE PART NUMBERS ARE HUBBELL, UNLESS NOTED OTHERWISE. C. ALL DEVICE HEIGHTS ARE REFERENCED TO CENTER OF DEVICE.	
	SINGLE RECEPTACLE 20A/120V 18" AFF UON
	DUPLEX RECEPTACLE 20A/120V 18" AFF UON-TAMPER RESISTANT, UON
	DUPLEX RECEPTACLE WITH DUAL USB 20A/120V 18" AFF UON
	DUPLEX RECEPTACLE 20A/120V 18" AFF UON WITH GROUND FAULT INTERRUPTER
	SWITCHED DUPLEX RECEPTACLE 20A/120V 18" AFF UON - TOP CONTROLLED
	FOURPLEX RECEPTACLE 20A/120V 18" AFF UON
	FOURPLEX RECEPTACLE 20A/120V (1V) WITH DUAL USB 18" AFF UON
	SWITCHED FOURPLEX RECEPTACLE 20A/120V 18" AFF UON - TOP CONTROLLED
	CLOCK RECEPTACLE 120V 96" AFF UON
	SPECIAL PURPOSE RECEPTACLE 18" AFF SEE PLANS FOR DETAILS
	CEILING MOUNTED DUPLEX RECEPTACLE 20A/120V (FLUSH)
	DUPLEX RECEPTACLE 20A/120V MOUNTED ABOVE COUNTER, HEIGHT SPECIFIED BY ARCHITECT
	DUPLEX RECEPTACLE FOR PROJECTOR
	WEATHER/TAMPER RESISTANT DUPLEX RECEPTACLE WITH "IN-USE" COVER 20A/120V 18" AFF UON
	DUPLEX GFI RECEPTACLE 20A/120V MOUNTED ABOVE COUNTER, HEIGHT SPECIFIED BY ARCHITECT
	SAFETY TYPE DUPLEX RECEPTACLE 20A/120V 18" AFF UON
	DUPLEX RECEPTACLE, FLOOR MOUNTED FLUSH (PROVIDE 1" CONDUIT IN SLAB OR BELOW FLOOR FROM NEAREST WALL TO LOCATION CONFIRMED WITH ARCHITECT.)
	FOURPLEX RECEPTACLE, FLOOR MOUNTED FLUSH (PROVIDE 1" CONDUIT IN SLAB OR BELOW FLOOR FROM NEAREST WALL TO LOCATION CONFIRMED WITH ARCHITECT.)
	EXISTING DUPLEX RECEPTACLE
	EXISTING FOURPLEX RECEPTACLE
	EXISTING 208V RECEPTACLE
	SINGLE POLE SWITCH 20A, 48" AFF UON
	DIMMER SWITCH, 48" AFF UON, SEE PLAN FOR DETAIL
	SWITCH WITH PILOT LIGHT, 48" AFF UON
	TWO POLE SWITCH 20A, 48" AFF UON
	TIMER SWITCH, 48" AFF UON
	FAN SWITCH, 48" AFF UON

DISTRIBUTION SYMBOL SCHEDULE

<b>NOTES:</b> A. ALL SYMBOLS DO NOT NECESSARILY APPEAR ON THESE DRAWINGS.	
SYMBOL	DESCRIPTION
	HOMERUN (REFER TO PANEL SCHEDULES FOR CONDUIT/WIRING)
	CIRCUIT ROUTED THRU CONTRACTOR OR RELAY
	UNDERGROUND ELECTRIC
	UNDERGROUND COMMUNICATION
	OVERHEAD ELECTRIC
	OVERHEAD COMMUNICATION
	CIRCUIT INDICATORS (HOT, NEUTRAL, GROUND, SWITCH/LEG)
	PHOTOCELL
	JUNCTION BOX
	JUNCTION BOX, FLOOR MOUNTED FLUSH
	JUNCTION BOX, WALL MOUNTED - 3/4" TO ABOVE CEILING
	MANUAL STARTER WITH THERMAL TRIP
	DISCONNECT SWITCH, REFER TO DISCONNECT SCHEDULE
	STARTER
	COMBINATION STARTER/DISCONNECT SWITCH, REFER TO SCHEDULE
	POWER AND/OR LIGHTING PANELBOARD, REFER TO PANELBOARD SCHEDULE
	SWITCHBOARD, REFER TO SWITCHBOARD SCHEDULE
	TRANSFORMER, REFER TO TRANSFORMER SCHEDULE

SPECIAL SYSTEMS SCOPE

<b>ACCESS CONTROL SYSTEM</b> 1. REFERENCE TECHNOLOGY PLANS AND SPECIFICATIONS.	
<b>SECURITY SYSTEM</b> 1. REFERENCE TECHNOLOGY PLANS AND SPECIFICATIONS.	
<b>TECHNOLOGY SYSTEM</b> 1. REFERENCE TECHNOLOGY PLANS AND SPECIFICATIONS.	
<b>INTERCOM SYSTEM</b> 1. REFERENCE TECHNOLOGY PLANS AND SPECIFICATIONS.	
<b>FIRE ALARM SYSTEM</b> 1. EXTEND EXISTING SYSTEM IN MAIN BUILDING TO THE WEIGHT ROOM BUILDING AND MPAC STRUCTURE. INTERCONNECT TO EXISTING SYSTEM WITH FIBER PER DISTRICT REQUIREMENTS. REFERENCE SPECIFICATIONS. 2. DUCT DETECTORS FOR ROOFTOP UNITS ARE TO BE INSTALLED IN THE UNIT. COORDINATE WITH MECHANICAL CONTRACTOR.	
<b>CLASSROOM AUDIO-VIDEO SYSTEM</b> 1. REFERENCE TECHNOLOGY PLANS AND SPECIFICATIONS.	

MECHANICAL SYSTEMS COMMISSIONING

THIS PROJECT HAS A TOTAL MECHANICAL EQUIPMENT CAPACITY OF 480,000 BTU/H OR MORE THEREFORE COMMISSIONING MUST BE PROVIDED PER THE LATEST STATE ADOPTED ENERGY CODE, 2015 IECC. COORDINATE THE COMMISSIONING SCOPE WITH THE OWNER SELECTED COMMISSIONING AGENT.

LIGHTING CONTROLS SYSTEM COMMISSIONING

LIGHTING CONTROL SYSTEM COMMISSIONING MUST BE PROVIDED PER THE LATEST ADOPTED ENERGY CODE, 2018 IECC, SECTION C408.3. COORDINATE THE COMMISSIONING SCOPE WITH THE OWNER SELECTED COMMISSIONING AGENT.

GENERAL NOTES

A.	THE CONTRACTOR IS TO VISIT THE SITE PRIOR TO BID TO FAMILIARIZE HIMSELF WITH ALL CONDITIONS AS THEY EXIST. SUBMISSION OF BID INDICATES THE CONTRACTOR'S UNDERSTANDING OF EXISTING CONDITIONS AND HIS WILLINGNESS TO WORK WITH THESE CONDITIONS. NO ADDITIONAL TIME OR MONEY WILL BE ALLOTTED DUE TO LACK OF COORDINATION WITH EXISTING CONDITIONS OR OTHER TRADES.
B.	CONTRACTOR IS TO REVIEW AND COMPARE ALL DRAWINGS SO ALL WORK IN THEIR RESPECTIVE TRADE IS INCLUDED IN BID. EACH CONTRACTOR SHALL INCLUDE ALL MATERIALS AND INSTALLATION REQUIRED FOR HIS PARTICULAR TRADE AFTER COMPLETE REVIEW OF ALL CONTRACT DRAWINGS AND SPECIFICATIONS.
C.	ALL WORK SHALL COMPLY WITH THE CURRENT APPLICABLE LOCAL, STATE AND FEDERAL CODES AND ORDINANCES. FOLLOW RECOMMENDED PRACTICES AS SET DOWN BY NEPA, BUILDING CODE, MECHANICAL CODE, PLUMBING CODE, NATIONAL ELECTRICAL CODE, ADA, TAS, AND OSHA, AS THEY APPLY TO THIS PROJECT, EXCEPT IN CASES WHERE LOCAL STATUTES GOVERN. THE CONTRACTOR SHALL VERIFY WITH AUTHORITY HAVING JURISDICTION THE LATEST ADOPTED LOCAL CODES, ORDINANCES AND AMENDMENTS THAT APPLY TO THIS PROJECT.
D.	THE ELECTRICAL CONTRACTOR SHALL VERIFY VOLTAGE, SIZES OF BREAKERS, FUSES, WIRING, ETC., FOR ALL EQUIPMENT TO BE PROVIDED, INCLUDING BUT NOT LIMITED TO HVAC, LIGHTING, PUMPS, HEATERS, ETC., AND REPORT DISCREPANCIES TO THE ENGINEER/ARCHITECT PRIOR TO INSTALLATION OF CONDUIT. COORDINATE WITH MECHANICAL/ELECTRICAL COORDINATION SHEET PROVIDED BY MECHANICAL CONTRACTOR FOR ACTUAL EQUIPMENT BEING USED.
E.	HOMERUNS SHALL BE COORDINATED WITH PANELBOARDS. ALL WIRING AND CONDUIT SHALL BE CONCEALED, EXCEPT IN ELECTRICAL ROOMS AND EXPOSED STRUCTURE AREAS.
F.	ALL WIRING SHALL BE FREE OF SHORTS AND GROUNDS. NO WIRING SHALL BE LOADED BEYOND THE PERMITTED AMPACITIES ALLOWED BY CURRENT N.E.C.
G.	MINIMUM WIRE/CONDUIT SIZES, EXCEPT FOR CLASS 2 LOW VOLTAGE CIRCUITS, ARE #12 AWG COPPER IN 1/2" CONDUIT. WHERE THE DISTANCE BETWEEN THE SUPPLYING PANEL AND THE FIRST BRANCH CIRCUIT RECEPTACLE OR LIGHT FIXTURE IS MORE THAN 100 FEET, CONTRACTOR REQUIRED TO UP SIZE CONDUCTOR TO ALLOW FOR MAXIMUM OF 3% VOLTAGE DROP FOR ACTUAL ROUTING OF CONDUITS TO DEVICE.
H.	THE ELECTRICAL CONTRACTOR SHALL PROVIDE ALL EQUIPMENT, LABOR AND MATERIALS NECESSARY TO MAKE A COMPLETE AND WORKABLE SYSTEM.
I.	CONFIRM THE EXACT LOCATION AND MOUNTING HEIGHTS OF LIGHTING FIXTURES WITH ARCHITECT BEFORE ROUGH-IN. COORDINATE REQUIRED CLEARANCES ABOVE FIXTURES WITH OTHER TRADES.
J.	PROVIDE A TYPED PANEL DIRECTORY FOR ALL PANELBOARDS INDICATING FINAL INSTALLED CONDITION. CIRCUIT LABELING SHALL AGREE WITH EQUIPMENT DESIGNATIONS AND OWNERS FINAL ROOM NUMBERS.
K.	LABEL ALL RECEPTACLES AND LIGHT SWITCHES WITH CIRCUIT NUMBER USING AN ELECTRONIC LABELER (BLACK ON CLEAR).
L.	THE CONTRACTOR IS TO LAY OUT SERVICE ENTRANCE AND ELECTRIC ROOMS TO SCALE WITH ACTUAL GEAR TO BE INSTALLED TO PROVIDE PROPER FIT AND CLEARANCES BEFORE INSTALLATION. COORDINATE ALL SERVICE CLEARANCE REQUIREMENTS WITH LOCAL UTILITY COMPANY. PROVIDE A 1/4" SCALE (MINIMUM) SHOP DRAWING. NOTIFY ARCHITECT/ENGINEERS OF ANY DIMENSIONAL PROBLEMS.
M.	COORDINATE AND WIRE ALL DOOR HOLD OPEN DEVICES, AS REQUIRED. REFER TO ARCHITECTURAL DRAWINGS FOR LOCATIONS. ROUTE 120 VOLT POWER FROM NEAREST AVAILABLE CIRCUIT AS REQUIRED. PROVIDE ALL WIRING NECESSARY FOR A COMPLETE AND OPERATIONAL SYSTEM.
N.	CONDUITS ROUTED TO ROOF SHALL BE INSTALLED IN SAME ROOF JACK AS MECHANICAL ELEMENTS. THE ELECTRICAL CONTRACTOR SHALL COORDINATE WITH THE MECHANICAL CONTRACTOR. ELECTRICAL CONTRACTOR SHALL PROVIDE ROOF JACK WHERE NO MECHANICAL ELEMENTS EXIST.
O.	PROVIDE SLEEVES FOR SPECIAL SYSTEMS ABOVE EACH DOOR INTO A RATED EGRESS CORRIDOR, (1" - 2" AND 3" - 3/4"). FIRE SEAL ENDS AND UNUSED SLEEVES SHALL HAVE A SCREW CAP INSTALLED ON BOTH SIDES. USE THREADED CONDUIT.
P.	ALL RECEPTACLES SERVING ELECTRIC WATER COOLERS SHALL BE LOCATED AT A HEIGHT SO AS NOT TO BE VISIBLE AFTER INSTALLATION OF EWC. COORDINATE MOUNTING HEIGHT WITH EQUIPMENT BEING PROVIDED. PROTECT WITH GFCI BREAKER.
Q.	ALL CONDUITS ROUTED BELOW FINISHED FLOOR SHALL BE RUN BELOW THE GRADE BEAMS. CONDUITS AND MULTIPLE CONDUITS SHALL NOT PENETRATE GRADE BEAMS UNLESS COORDINATED WITH STRUCTURAL ENGINEER. OBTAIN WRITTEN APPROVAL FROM STRUCTURAL ENGINEER PRIOR TO BEGINNING WORK.
R.	ALL EXPOSED CONDUIT SHALL BE RUN PARALLEL AND PERPENDICULAR TO STRUCTURE AND BUILDING LINES. COORDINATE FINAL CONDUIT ROUTING PATH WITH ARCHITECT AND ENGINEER PRIOR TO INSTALLATION.
S.	THE ELECTRICAL CONTRACTOR SHALL PROVIDE ALL 120 VOLT WIRING AND CONNECTIONS REQUIRED TO FIRE/SMOKE DAMPERS. COORDINATE EXACT LOCATIONS OF DAMPERS WITH MECHANICAL CONTRACTOR AND RELAY REQUIREMENTS WITH FIRE ALARM CONTRACTOR. CONNECT TO NEAREST AVAILABLE UNSWITCHED CIRCUIT UNLESS OTHERWISE INDICATED ON DRAWINGS.
T.	ELECTRICAL CONTRACTOR SHALL CONNECT MOTORIZED BACK DRAFT DAMPERS FOR EXHAUST FANS FROM CIRCUIT FEEDING FAN. PROVIDE ALL MATERIAL AND LABOR TO MAKE CONNECTIONS.
U.	ELECTRICAL CONTRACTOR TO SEAL ALL PENETRATIONS OF ELECTRICAL WORK IN FIRE AND SMOKE RATED PARTITIONS, CEILINGS, ETC.
V.	ELECTRICAL CONTRACTOR TO PROVIDE DISCONNECTING MEANS AND PROPER FUSING PROTECTION FOR ALL EQUIPMENT PER N.E.C. UNLESS OTHERWISE NOTED.
W.	COORDINATE ALL DEVICES IN MILLWORK WITH ARCHITECTURAL MILLWORK SHOP DRAWINGS PRIOR TO ROUGH-IN.
X.	SENSOR OPERATED PLUMBING DEVICES: PLUMBING CONTRACTOR TO PROVIDE LOW VOLTAGE TRANSFORMERS FROM MANUFACTURER. ELECTRICAL CONTRACTOR IS TO PROVIDE ALL OTHER MATERIALS AND LABOR FOR COMPLETE INSTALLATION.
Y.	SPRAY PAINT JUNCTION BOXES RED FOR FIRE ALARM SYSTEM. ALL OTHER SPECIAL SYSTEM JUNCTION BOXES TO BE PAINTED WHITE.
Z.	DO NOT HANG ANY FIXTURES, EQUIPMENT OR CONDUIT FROM ROOF DECK.
AA.	LABEL ALL JUNCTION BOXES WITH CIRCUIT NUMBERS.
BB.	IDENTIFY RECEPTACLE CIRCUITS IN PANELBOARDS TO INDICATE FINAL ROOM NUMBERS. VERIFY FINAL ROOM NUMBERS PRIOR TO TYPING PANELBOARD SCHEDULES.
CC.	MECHANICALLY FASTEN ALL LABELS TO EQUIPMENT.
DD.	ELECTRICAL CONTRACTOR TO OBTAIN "MECH/ELEC COORDINATION SHEET" FILLED OUT FROM MECHANICAL CONTRACTOR. THIS SHEET IS TO BE INCLUDED WITH ELECTRICAL GEAR/PANELBOARD SUBMITTAL. SUBMITTAL WILL NOT BE CHECKED WITHOUT THIS FORM INCLUDED.
EE.	ELECTRICAL CONTRACTOR IS TO PROVIDE ROUGH-IN FOR ALL MECHANICAL CONTROL DEVICES IN WALLS AND PENETRATIONS FOR CONTROL WIRES TO EXTERIOR UNITS. COORDINATE ALL LOCATIONS WITH MECHANICAL CONTRACTOR AND MECHANICAL SHEETS.
FF.	DISCONNECTS MOUNTED ABOVE CEILING MUST BE MOUNTED TO BE READILY ACCESSIBLE NEAR UNIT. HANDLE TO BE NO MORE THAN 36" ABOVE CEILING GRID.
GG.	ALL EXTERIOR DISCONNECTS ARE TO BE MOUNTED BELOW LINE OF SIGHT OF A SCREEN WALL OR IF SINGLE DISCONNECT, LEVEL WITH TOP OF CONDENSER. VERIFY LOCATION WITH ARCHITECT/ENGINEER PRIOR TO ROUGH-IN.
HH.	THE ELECTRICAL CONTRACTOR SHALL PROVIDE ONE 120 VOLT, WEATHERPROOF GFCI DUPLEX RECEPTACLE WITHIN 25 FEET OF ALL PIECES OF NEW OR REPLACEMENT MECHANICAL EQUIPMENT LOCATED ON ROOF, MEZZANINE OR ON THE GROUND. CONNECT TO NEAREST AVAILABLE UNSWITCHED 120 VOLT 20 AMP CIRCUIT WITH LESS THAN 6 RECEPTACLES OR RUN TO NEAREST PANELBOARD AND PROVIDE 10 MINIMUM WITH NEW 20 AMP CIRCUIT BREAKER.
II. ALL JUNCTION BOXES MOUNTED ABOVE CEILING MUST BE NO MORE THAN 36" ABOVE CEILING GRID.	



REFERENCE GENERAL NOTES ON SHEETS ME-01, PE-01, AND E0-01 FOR ADDITIONAL INFORMATION



COMMISSIONING - FIELD INVESTIGATION  
This document, the ideas and designs incorporated herein are and shall remain the property of Hendrix Consulting Engineers. These documents are not to be used or altered, in whole or in part, for other than the original intended use, nor are they to be assigned to any third party without written permission from Hendrix Consulting Engineers.

F - 4095  
HCE Job no.: 24-033

www.huckabee-inc.com  
800.887.1229

SCHEDULES, NOTES, AND LEGENDS - ELECTRICAL

PACKAGE VOLUME  
Job No. 1954-07-01  
Sheet No. ISSUE FOR BID  
Drawn By: PP, LMM  
Date: 04/22/2025  
E0.01



RTU ELECTRICAL CONNECTION SCHEDULE							
UNIT TYPE	VOLTAGE / PHASE	NATURAL [PROPANE] GAS (UNIT TYPES)				MINIMUM WIRE / CONDUIT SIZES	
		KVA	MCA	FUSED DISCONNECT SIZE (NEMA 3R)	MOCP	LENGTH UP TO (FT)	LENGTH UP TO (FT)
						125	250
G2 - 208/1	208/1	3.2	19	30	25	10	17
G2.5 - 480/3	480/3	6.1	9	30	15	6	6
G3 - 480/3	480/3	6.1	9	30	15	6	6
G4 - 480/3	480/3	8.9	13	30	15	6	6
G5 - 480/3	480/3	9.5	14	30	15	6	13
G6 - 480/3	480/3	10.2	15	30	20	6	13
G7 - 480/3	480/3	15.7	23	30	25	13	13
G8 - 480/3	480/3	15.7	23	30	25	13	13
G10 - 480/3	480/3	17.0	25	30	30	13	20
G12 - 480/3	480/3	20.4	30	60	40	20	20
G13 - 480/3	480/3	23.2	34	60	45	20	20
G15 - 480/3	480/3	22.5	33	60	45	20	20
G17 - 480/3	480/3	28.6	42	60	50	20	27
G20 - 480/3	480/3	33.4	49	60	50	20	27
G25 - 480/3	480/3	44.3	65	100	70	34	34

UNIT MARK	UNIT TYPE
RTU-B1	G17
RTU-B2	G17

UNIT TYPE BREAKDOWN:  
G = GAS HEAT RTU, E = ELECTRIC HEAT RTU

STANDARD NOTES:  
A. VERIFY FINAL FUSE SIZE WITH ACTUAL EQUIPMENT PROVIDED. COORDINATE WITH MECHANICAL CONTRACTOR PRIOR TO ORDERING SWITCHGEAR.  
B. IN THE EVENT THAT THERE IS A DIFFERENCE BETWEEN MINIMUM WIRE/CONDUIT SIZE ON THIS SCHEDULE AND THE MORE STRINGENT OF THE TWO.  
C. SOME UNITS SHOWN ON THE MASTER SCHEDULE(S) MAY NOT BE USED ON THIS JOB.  
D. REFERENCE BRANCH CIRCUIT WIRE AND CONDUIT SCHEDULE FOR WIRE/CONDUIT DEFINITION.

ESC-17

## DISCONNECT SWITCH SCHEDULE

- REMARKS:
- A. THIS SCHEDULE IS NOT A COMPREHENSIVE DISCONNECT SCHEDULE. REFERENCE OTHER ELECTRICAL CONNECTION SCHEDULES FOR ADDITIONAL DISCONNECT REQUIREMENTS.
- B. COORDINATE FINAL FUSE SIZES WITH EQUIPMENT BEING PROVIDED PRIOR TO ROUGH-IN.
- C. WHEN THE LENGTH OF THE SECONDARY CONDUCTORS OF ANY TRANSFORMER EXCEEDS TEN FEET, PROVIDE AN ENCLOSED CIRCUIT BREAKER OR FUSED DISCONNECT WITHIN TEN FEET OF THE TRANSFORMER SECONDARY TERMINALS IN ACCORDANCE WITH NEC ARTICLE 240.21(C)(2). THIS OVERCURRENT DEVICE SHALL HAVE AN AMP RATING EQUAL TO THE AMP RATING OF THE PANEL BEING SERVED. THE PANEL BEING FED MAY BE CHANGED TO MAIN LUG ONLY.
- D. PROVIDE LUG KITS AND/OR WIRING GUTTERS FOR PANELS WITH OVERSIZED CONDUCTORS DUE TO VOLTAGE DROP AND/OR DISTANCE. MAKE CONNECTIONS IN ACCORDANCE WITH THE N.E.C.
- E. PROVIDE SHOP DRAWINGS OF ALL ELECTRIC ROOMS INDICATING ALL PANEL, TRANSFORMER AND DISCONNECT LOCATIONS. ELECTRICAL EQUIPMENT MAY SHIFT IN LOCATION TO INSURE PROPER CLEARANCES.
- F. PROVIDE DISCONNECTING MEANS FOR ALL EQUIPMENT PER N.E.C.
- G. DISCONNECTS MOUNTED ABOVE CEILING MUST BE MOUNTED TO BE READILY ACCESSIBLE NEAR UNIT. HANDLE TO BE NO MORE THAN 36" ABOVE CEILING GRID.
- H. ALL EXTERIOR DISCONNECTS ARE TO BE MOUNTED BELOW LINE OF SIGHT OF A SCREEN WALL OR IF SINGLE DISCONNECT, LEVEL WITH TOP OF CONDENSER. VERIFY LOCATION WITH ARCHITECT/ENGINEER PRIOR TO ROUGH-IN.
- \*\* U.O.N. FOR ALL PANELS SUPPLIED FROM TRANSFORMERS THAT REQUIRE DISCONNECT, REFERENCE TRANSFORMER SCHEDULE SECONDARY BREAKER SIZE FOR ALL ENCLOSURE TYPE AND DISCONNECT/FUSE SIZING INFORMATION.

VOLTAGE RATING	POLES	AMP RATING	ENCLOSURE	FUSE SIZE	SN	MOTOR STARTER REQ	Load Name
240 V 2	2	20.0 A	N1	20.0 A			AHU-B1
240 V 2	2	60.0 A	N1	40.0 A			WH-B1
600 V 1	3	30.0 A	N1	20.0 A			EUH-B1
600 V 3	3	30.0 A	N3R	20.0 A			CU-B1

## NLIGHT - DEVICE SYMBOL SCHEDULE

- NOTES:
- A. ALL SYMBOLS DO NOT NECESSARILY APPEAR ON THESE DRAWINGS.
- B. ALL DEVICE PART NUMBERS ARE **NLIGHT** UNLESS OTHERWISE NOTED.
- C. THESE DEVICES SHOULD BE USED IN ALL AREAS TO BE CONTROLLED BY NLIGHT.
- D. MOTION SENSOR: WHERE MOTION SENSORS ARE SHOWN ON THE PLANS, THAT INDICATES AREA SHOULD BE COVERED IN FULL BY MOTION SENSORS. IT IS UP TO MOTION SENSOR PROVIDER TO PROVIDE APPROPRIATE QUANTITY, LAYOUT, AND TYPE OF MOTION SENSORS FOR COMPLETE COVERAGE. PROVIDE SHOP DRAWING AT SUBMITTAL PHASE.
- E. PHOTOCELL: WHERE PHOTOCELLS ARE SHOWN ON PLANS OR IN TYPICAL DETAILS, IE: CLASSROOMS, PHOTOCELL LOCATION AND QUANTITY SHOULD BE DETERMINED BY PHOTOCELL PROVIDER. PHOTOCELLS ARE INTENDED TO DIM LIGHTS IN DAYLIGHT ZONES AS INDICATED BY IECC 2018. IF MULTIPLE ZONE CONTROL IS INDICATED FOR A SPACE AND THOSE ZONES ARE NOT CLEAR TO CONTRACTOR, THE CONTRACTOR IS TO MAKE BEST ASSUMPTION IN SHOP DRAWING PHASE AND NOTE AREAS IN QUESTION. ENGINEER WILL REVIEW AND MAKE ANY ADJUSTMENTS TO ZONES AT THAT TIME.
- G. MANUFACTURER TO PROVIDE A COMPLETE SET OF SHOP DRAWINGS INDICATING ALL ASPECTS OF LIGHTING CONTROL AT A MINIMUM OF 1/8" = 1' SCALE WITH CLEAR DESCRIPTIONS AND LEGENDS FOR SYMBOLS.
- H. BASIC COMPONENTS ARE CALLED FOR HERE, IT IS EXPECTED THAT MANUFACTURER PROVIDES ALL COMPONENTS FOR A COMPLETE WORKABLE SYSTEM.
- I. FACTORY START-UP IS REQUIRED FOR ALL NLIGHT SPACES.
- J. CONTRACTOR SHOULD SEND COMPLETE SET OF ELECTRICAL PLANS TO NLIGHT FACTORY REP TO ENSURE A COMPLETE BID.
- K. CONTRACTOR TO ASSUME ALL DEVICES INTER-CONNECTED WITH CAT-5 CABLE. PROVIDE ALL REQUIRED CABLING BETWEEN DEVICES. CABLE COLOR IS TO BE COORDINATED WITH THE TECHNOLOGY CABLING TO BE A DIFFERENT COLOR. NO ZIP TIES MAY BE USED FOR SECURING CABLE. ONLY VECRO TIES MAY BE USED.

SYMBOL	DESCRIPTION	REMARKS
	DUAL TECHNOLOGY WALL MOUNT MOTION AND DIMMING	nWSXA-PDT-LV-DX
	ONE ZONE CONTROLLER, ON/OFF AND DIMMING	nPODMA-DX
	TWO ZONE CONTROLLER, ON/OFF AND DIMMING	nPODMA-2P-DX
	FOUR ZONE CONTROLLER, 4 PRESET TOGGLE BUTTONS	nPODMA-4S-DX
	ONE ZONE KEYED CONTROLLER, ON/OFF AND DIMMING	nPOD-KEY
	COLOR SCENE CONTROLLER	nPODMA-4S-EDUTW
	MOTION SENSOR, DT (DUAL TECHNOLOGY)	nCM-PDT-9
	MOTION SENSOR, DT (DUAL TECHNOLOGY)	nCM-PDT-10
	MOTION SENSOR, DT (DUAL TECHNOLOGY)	nWV-PDT-16
	PHOTOCELL	nCM-ADCX

## NLIGHT INTERIOR LIGHTING SCHEDULE

- GENERAL NOTES:
- PROVIDE LIGHTING CONTROL AS REQUIRED PER THE CURRENT ADOPTED EDITION OF IECC - 2018/2019.
- POWER PACKS**  
FOR FIXTURES THAT ARE NOT NLIGHT COMPATIBLE, PROVIDE POWER PACKS TO ACHIEVE ZONING INDICATED ON PLANS AND SHALL BE INSTALLED ABOVE THE TOP OF THE ROOM CEILING SURFACE.
- AREAS WITH HIGH CEILINGS (15FT OR HIGHER): PROVIDE POWER PACKS TO ACHIEVE ZONING INDICATED ON PLANS. LOCATE POWER PACKS IN ACCESSIBLE LOCATION FROM LIGHTING PANEL SERVING CIRCUITS.

WHEN POWER PACKS ARE PROVIDED, CONTRACTOR MUST PROVIDE 0-10V DIMMING WIRES FROM POWER PACK TO FIXTURE FOR CONTROL IN LIEU OF CAT5 CABLE.

NLIGHT MANUFACTURER TO PROVIDE NLIGHT ENABLED FIXTURES OR POWER PACKS TO ACHIEVE ZONING SHOWN ON PLANS FOR SWITCHING AND DAYLIGHT ZONES TO PROVIDE BEST VALUE TO THE PROJECT.

## MOTION SENSORS

PROVIDE COMPLETE MOTION SENSOR COVERAGE FOR ENTIRE BUILDING, EXCEPT ELECTRIC ROOMS, AND AS WHEN NOTED EXCEPTION SHOWN ON PLANS. PROVIDE DUAL TECHNOLOGY MOTION SENSORS IN EVERY ROOM AS REQUIRED BY IECC. ASSUME CEILING MOUNT UNLESS WALL MOUNT SHOWN.

## VACANCY SENSORS

PROVIDE COMPLETE DUAL TECHNOLOGY VACANCY SENSOR COVERAGE PER IECC IN ALL AREAS EXCEPT EMERGENCY EGRESS CORRIDORS AND PATHWAYS. SHOP DRAWING REQUIRED.

## OCCUPANCY SENSORS

PROVIDE COMPLETE DUAL TECHNOLOGY OCCUPANCY SENSOR COVERAGE PER IECC IN ALL EMERGENCY EGRESS CORRIDORS AND PATHWAYS. SHOP DRAWING REQUIRED.

## CONTROL STATION

ALL ROOMS SHALL HAVE A CONTROL STATION FOR CONTROL OF LIGHTS IN ROOM. IF NO CONTROL STATION IS SHOWN, ASSUME A TWO ZONE CONTROLLER FOR ROOMS LARGER THAN 9' X 9' AND A WALL MOUNT DUAL TECHNOLOGY CONTROLLER FOR ROOMS SMALLER THAN 9' X 9'.

## PROGRAMMING MODULE

PROVIDE (2) NO BT BLUETOOTH PROGRAMMING MODULES WITH PROJECT AND PROVIDE TO OWNER FOR OWNER'S FUTURE USE. STARTUP TECHNICIAN SHALL PROVIDE OWNER TRAINING ON USE OF MODULE.

## SPACE TYPE DESCRIPTION:

## WEIGHT ROOM


- A. PROVIDE CONTROL STATIONS AS SHOWN ON PLANS.
- B. TWO ZONE CONTROL, ZONE 'A', ZONE 'B' AS SHOWN IN PLANS AND AS DESCRIBED BELOW:  
1. ROOMS WITH UPLIGHTS AND DOWNLIGHTS, ZONE 'A' - DOWNLIGHTS, ZONE 'B' - UPLIGHTS.
- C. PROVIDE COMPLETE MOTION SENSOR COVERAGE FOR MINOR MOVEMENTS, MANUAL ON / AUTO OFF AFTER 20 MINUTES. SHOP DRAWING REQUIRED.
- D. PROVIDE PHOTOCELL AND CONTROL LIGHTS IN DAYLIGHT ZONE PER IECC AS SHOWN ON PLANS.

## MULTIPURPOSE ATHLETIC COMPLEX (MPAC)

- A. PROVIDE (3) SENSORSWITCH PTSA-720-WHLT PROGRAMMABLE TIMER SWITCHES FOR LIGHTING CONTROL OF (3) LIGHTING ZONES. PROVIDE WEATHERPROOF COVER FOR EACH SWITCH. TIMER CONTROL TO BE ONLY PUBLICLY AVAILABLE CONTROL.
- B. PROVIDE (3) 12-POLE LIGHTING CONTACTORS FOR LIGHTING CIRCUIT ON/OFF CONTROL THROUGH EACH PTSA TIME SWITCH. LOCATE LIGHTING CONTACTOR ENCLOSURE ON SERVICE RACK.
- C. PROGRAM PTSA SWITCHES FOR BEEP WARNING, 4 HOUR MAX ALLOWABLE TIME AND 60 MINUTE DEFAULT ON TIME. BEEP WARNING NOT TO BE USED.
- D. PROVIDE NPS-80-EZ-LT DIMMING ONLY POWER PACKS (NO RELAY, EACH CONTROLLING DIMMING FOR MAX 20 FIXTURES) IN SUFFICIENT QUANTITY FOR THE SPECIFIED LIGHT QUANTITY. PROVIDE FOUR BUTTON SCENE CONTROLLER nPODMA-4S-LT PROGRAMMED FOR 70%, 80%, 90%, 100% DIMMING LEVEL PRESETS FOR OVERALL FACILITY. ON/OFF ZONES NOT TO BE DIMMED INDEPENDENTLY AND LOCATED ADJACENT TO PTSA TIMER SWITCH IN A LOCKABLE NEMA 3R ENCLOSURE. CONNECTED TO 0-10V DIMMING WIRES FOR FIXTURES TO ALLOW OWNER TO SET DESIRED PRESET LIGHTING LEVEL. DIMMING CONTROL IS INTENDED TO BE ONLY SET BY DISTRICT PERSONNEL UPON STARTUP OF FACILITY AND ONLY ADJUSTED AS NEEDED BY OWNER. NPS-80-EZ-LT SHALL BE WIRED TO CONSTANT HOT POWER SOURCE, 120V OR 277V.

## SINGLE ZONE ROOMS

- A. PROVIDE CONTROL STATIONS AS SHOWN ON PLANS.
- B. ONE OVERALL ZONE TO CONTROL ALL LIGHTS IN ROOM.
- C. PROVIDE COMPLETE MOTION SENSOR COVERAGE FOR MINOR MOVEMENTS, MANUAL ON / AUTO OFF AFTER 20 MINUTES. SHOP DRAWING REQUIRED.
- D. PROVIDE PLUG LOAD POWER PACK IN ACCESSIBLE LOCATION FOR EXHAUST FAN CONTROL IN SINGLE RESTROOMS.

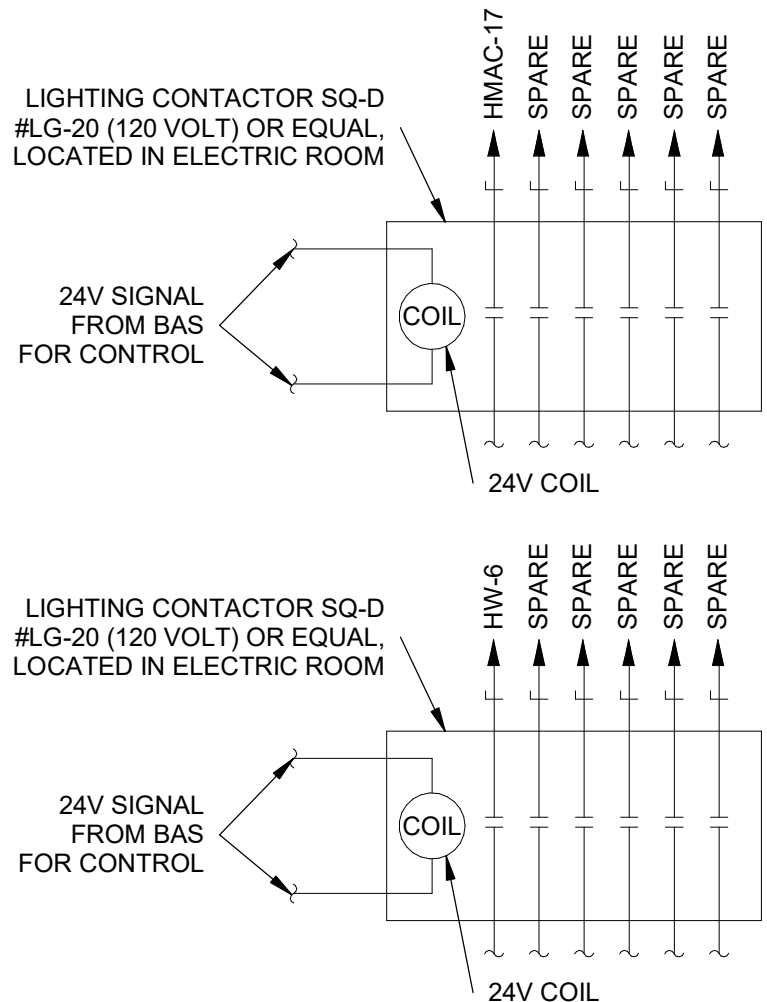

## LIGHTING CONTACTOR DETAIL

SCALE: NONE

EDE-11-BAS

## LIGHT FIXTURE SCHEDULE

## GENERAL NOTES:

- A. CONFIRM CEILING TYPE AND CONSTRUCTION PRIOR TO ORDERING LIGHT FIXTURE. PROVIDE FLANGE KIT FOR PROPER INSTALLATION OF LAY-IN FIXTURE IN GYPSUM CEILING. PROVIDE FIXTURE TYPE 'H2' IN LIEU OF FIXTURE TYP 'A2' IN ROOMS WITH NO CEILING. CHAIN HANG AT 10' A.F.F.
- B. COORDINATE EXACT LOCATION AND MOUNTING HEIGHT OF WALL MOUNTED LIGHT FIXTURES WITH ARCHITECT PRIOR TO ROUGH-IN.
- C. REFER TO ARCHITECTURAL REFLECTIVE CEILING PLAN FOR EXACT LOCATION OF LIGHT FIXTURE.
- D. CONFIRM FINISH WITH ARCHITECT PRIOR TO ORDERING LIGHT FIXTURES.
- E. 'E' DESIGNATION ADJACENT TO LIGHTING FIXTURE TYPE INDICATES FIXTURE SHALL BE PROVIDED WITH EMERGENCY BATTERY PACK UNIT. LIGHT FIXTURE SHALL BE SWITCHED, BATTERY PACK SHALL BE UNSWITCHED. BATTERY PACKS FOR EXTERIOR FIXTURES SHALL BE COLD WEATHER RATED.
- F. 'N' DESIGNATION ADJACENT TO LIGHTING FIXTURE TYPE INDICATES FIXTURE SHALL BE PROVIDED WITH EMERGENCY BATTERY PACK UNIT. LIGHT FIXTURE AND BATTERY PACK SHALL BE UNSWITCHED.
- G. FIXTURES SHALL BE PROVIDED WITH A DIMMING DRIVER.
- H. CONNECT ALL EXIT LIGHTING TO THE NEAREST UNSWITCHED CIRCUIT OR THE NEAREST EMERGENCY CIRCUIT.
- I. REFERENCE 'NLIGHT DEVICE SYMBOL SCHEDULE' AND 'NLIGHT INTERIOR LIGHTING SCHEDULE'.
- J. ELECTRICAL CONTRACTOR SHALL CONFIRM ALL FIXTURE DRIVER VOLTAGE RATINGS MATCH THE PROJECT ELECTRICAL POWER SYSTEM VOLTAGE AND LIGHTING CIRCUIT VOLTAGE PRIOR TO SUBMITTAL.
- (\*) PROVIDE UNIT PRICE FOR THIS FIXTURE. INCLUDE MATERIAL AND LABOR TO BE ADDED AT ANY TIME DURING THE PROJECT.

MARK	MANUFACTURER	MANUFACTURER'S CATALOG NUMBER	LUMENS	VOLTS	WATTS	DESCRIPTION
A3	LITHONIA	CPX 2x4 5000LM 80CRI 35K SWL MINI 2T MVOLT	5069	277 V	40 W	LED PANEL 2 x 4 LAY IN FIXTURE, WHITE FINISH, 1% DIMMING, GRID CLG
A4	LITHONIA	CPX 2x4 6000LM 80CRI 35K SWL MINI 2T MVOLT	5963	277 V	42 W	LED PANEL 2 x 4 LAY IN FIXTURE, WHITE FINISH, 1% DIMMING, GRID CLG
F2	FINELITE	HPX-R-D-XX-H-835-F-277-DC-FC-1%-XX	802/FT	277 V	26 W	2.5" RECESSED LINEAR, HIGH OUTPUT LED, VERIFY TRIM/LOCATION/LENGTH WITH ARCHITECTS RCP, 1% DIMMING
F5	FINELITE	HPX-P-ID-XX-S-H-835-TG-F-277-DC-FC-1%-FASD-XX-FE-SW	1213/FT	277 V	40 W	(OPEN/HARD CEILING) 2.5" INDIRECT/DIRECT LINEAR PENDANT, STANDARD UP/HIGH DOWN, PROVIDE 150" MOUNTING AIRCRAFT CABLE, COORDINATE LONGER IF REQUIRED, TOP GLOW LENS, VERIFY TRIM/LOCATION/LENGTH WITH ARCHITECTS RCP, 1% DIMMING, CONTROL UPLIGHT SEPARATE FROM DOWNLIGHT.
G1	LITHONIA	WL2 18L MVOLT G21 LP835	1796	277 V	18 W	2" SURFACE MOUNT WRAP AROUND LED, MOUNT 6" ABOVE MIRROR, OR 8" ABOVE STAIRS DEPENDING ON APPLICATION, 1% DIM, NLIGHT
H2	LITHONIA	CLX-L48-5000LM-SEF-FDL-MVOLT-EZ1-35K-80CR-IWH	4601	277 V	32 W	LED STRIP FIXTURE, CHAIN HANG, AIRCRAFT CABLE OR SURFACE MOUNT DEPENDING ON APPLICATION, PROVIDE THCLX BRACKET WHEN SURFACE MOUNTED, TYPICAL MOUNTING HEIGHT APPROX 8'-12", 1% DIMMING, NLIGHT
S1	LITHONIA	RSX2-LED-P4-30K-R3-XVOLT-SPA-NLTAIR2-PIRH N-FINISH (pole) WILL BRANDS VS-SSSA-25-50-50-11-AB-PP-C-D1	25002	480 V	187 W	POLE MOUNTED LED FIXTURE WITH DIE CAST ALUMINUM HOUSING, WITH NLIGHTAIR2 FOR MOTION DIMMING TO 50% AND PHOTOCELL CONTROL, FINISH TO BE SELECTED BY ARCHITECT, POLE IS STRAIGHT STEEL, DRILLED FOR FIXTURE MOUNTING AND BASE COVER, FINISH TO MATCH FIXTURE.
S2	LITHONIA	RSX2-LED-P4-30K-R5-XVOLT-SPA-NLTAIR2-PIRH N-FINISH (pole) WILL BRANDS VS-SSSA-25-50-50-11-AB-PP-C-D2	2x25669	480 V	374 W	POLE MOUNTED LED FIXTURE WITH DIE CAST ALUMINUM HOUSING, WITH NLIGHTAIR2 FOR MOTION DIMMING TO 50% AND PHOTOCELL CONTROL, FINISH TO BE SELECTED BY ARCHITECT, POLE IS STRAIGHT STEEL, DRILLED FOR FIXTURE MOUNTING AND BASE COVER, FINISH TO MATCH FIXTURE.
S3	LITHONIA	RSX4-LED-P4-30K-R3-XVOLT-SPA-NLTAIR2-PIRH N-FINISH (pole) EXISTING	2x55,426	480 V	862 W	POLE MOUNTED LED FIXTURE WITH DIE CAST ALUMINUM HOUSING, WITH NLIGHTAIR2 FOR MOTION DIMMING TO 50% AND PHOTOCELL CONTROL, FINISH TO BE SELECTED BY ARCHITECT, POLE IS STRAIGHT STEEL, DRILLED FOR FIXTURE MOUNTING AND BASE COVER, FINISH TO MATCH FIXTURE.
T1	LITHONIA	WDG3 LED P1 40K 70CRI R3 MVOLT NLTAIR2 PIR DBDX	7524	277 V	52 W	ARCHITECTURAL WALL MOUNTED LED FIXTURE WITH DIE CAST ALUMINUM HOUSING, WITH FULL CUT-OFF, HIGH EFFICIENCY DRIVER WITH NLIGHTAIR2 SENSORS FOR MOTION DIMMING TO 50% AND PHOTOCELL CONTROL, DARK BRONZE FINISH, APPROX. 12'-14" AFF, COORDINATE FINAL HEIGHT WITH ARCHITECTURAL FIXTURE TO BE SECURELY MOUNTED TO A STRUCTURAL SURFACE.
T3	LITHONIA	WDG3-LED-P4-3K-70CRI-R3-MVOLT-NLTAIR 2-PIR-DBDX	11194	277 V	88 W	ARCHITECTURAL WALL MOUNTED LED FIXTURE WITH DIE CAST ALUMINUM HOUSING, WITH FULL CUT-OFF, HIGH EFFICIENCY DRIVER WITH NLIGHTAIR2 SENSORS FOR MOTION DIMMING TO 50% AND PHOTOCELL CONTROL, DARK BRONZE FINISH, APPROX. 12'-14" AFF, COORDINATE FINAL HEIGHT WITH ARCHITECTURAL FIXTURE TO BE SECURELY MOUNTED TO A STRUCTURAL SURFACE.
T5	LITHONIA	WDG2-LED-P3SW-40K-80CRI-VV-MVOLT-NLIGH TAIR2-PIR-DBDX	3,000L	277 V	23 W	ARCHITECTURAL WALL MOUNTED LED FIXTURE WITH DIE CAST ALUMINUM HOUSING, WITH FULL CUT-OFF VISUAL COMFORT LENS, HIGH EFFICIENCY DRIVER WITH NLIGHTAIR2 SENSORS FOR MOTION DIMMING TO 50% AND PHOTOCELL CONTROL, DARK BRONZE FINISH, APPROX. 8'-10" AFF, COORDINATE FINAL HEIGHT WITH ARCHITECTURAL FIXTURE TO BE SECURELY MOUNTED TO A STRUCTURAL SURFACE.
U8	LUX DYNAMICS	L-6-D-A-840-2-U10-CP-B-3/10-AFH-UM4	65668	277 V	465 W	30" X 25" HIGH BAY LED, WITH 10% DIMMING, WHITE ACRYLIC DIFFUSE LENS AND STANDARD ALUMINUM FINISH, USE UNISTRUT TO SPAN JOIST OR MOUNT TO BOTTOM OF JOIST DEPENDING ON LOCATION, PROVIDE NLIGHT POWER PACK AS REQUIRED TO SUIT ZONING ON PLANS.
X1	BEGHELLI	LC1-E-SA-LR-1-B-AL	NA	277 V	1 W	LED SINGLE FACE EXIT SIGN WITH DIE CAST ALUMINUM HOUSING, EMERGENCY BATTERY PACK.
X6	LITHONIA	LV-S-AB-1-R-120/277-UM-ELN-CW	INCLUDED	277 V	5 W	LED SINGLE FACE EXTREME EXIT SIGN WITH DIE CAST ALUMINUM CONSTRUCTION FOR HIGH ABUSE AREAS, NEMA 4X WET LOCATION RATED.
Y1	BEGHELLI	EPE	154	277 V	3 W	EMERGENCY EGRESS FIXTURE WITH POLYCARBONATE HOUSING, EMERGENCY BATTERY PACK AND AMMETER, WHITE FINISH, WALL MT APPROX 9' AFF, CONNECT TO NEAREST UNSWITCHED LIGHT CIRCUIT.

## CEILING FANS (CF)

## CEILING FAN (CF-5):

PROVIDE BAFCON FAN CONTROLLER FOR SINGLE LOCATION CONTROL OF ALL FANS IN SPACE. PROVIDE CAT5 CABLE DAISY CHAINED FROM CONTROLLER TO ALL FANS.

MARK NO.	STOCK/ MODEL NUMBER	MAX RPM	HP	VOLT/PHAMPS	BLADE DIAMETER	WEIGHT
CF-5	BAF BASIC 6	110	1.5	208/3/15	14'-0"	192



THE SEAL REPRESENTS ONLY THE PROFESSIONAL ENGINEER'S SEAL. IT DOES NOT REPRESENT THE QUALITY OF THE WORK OR THE RESULTS OF THE WORK.

REFERENCE GENERAL NOTES ON SHEETS MD-01, PD-01, AND ED-01 FOR ADDITIONAL INFORMATION

MEPFENERGY CONSULTANTS



COMMERCIAL - CIVIL INVESTIGATION

This document, the ideas and designs incorporated herein are and shall remain the property of Hendrix Consulting Engineers. These documents are not to be used or altered, in whole or in part, for other than the original intended use, nor are they to be assigned to any third party without written permission from Hendrix Consulting Engineers.

F - 4095  
HCE Job no.: 24-033

Addendum No.3

Date

05/14/25

Revision /

2

JOHNSON HIGH SCHOOL  
2025 ADDITIONS + RENOVATIONS  
FOR  
HAYS CISD  
BUDA, TX

Project:



THE SEAL REPRESENTS ONLY THE PROFESSIONAL ENGINEER'S SEAL. IT DOES NOT REPRESENT THE QUALITY OF THE WORK OR THE RESULTS OF THE WORK.

REFERENCE GENERAL NOTES ON SHEETS MD-01, PD-01, AND ED-01 FOR ADDITIONAL INFORMATION

MEPFENERGY CONSULTANTS



COMMERCIAL - CIVIL INVESTIGATION

This document, the ideas and designs incorporated herein are and shall remain the property of Hendrix Consulting Engineers. These documents are not to be used or altered, in whole or in part, for other than the original intended use, nor are they to be assigned to any third party without written permission from Hendrix Consulting Engineers.

F - 4095  
HCE Job no.: 24-033

Huckabee

www.huckabee-inc.com  
800.887.1229

SCHEDULES - ELECTRICAL

PACKAGE VOLUME

Job No. 1954-07-01

Sheet No. ISSUE FOR BID

Drawn By: PP, LMM

Date: 04/22/2025

E0.10



## CIRCUIT BREAKER PANELBOARD: HMAC

## JOHNSON HIGH SCHOOL

LOCATION: SURFACE NEMA 3R

MAIN DEVICE: 225.0 A MAIN CB

BUS AMPS: 225 AMPS

VOLTAGE: 480Y/277 V, 3 ø 4 W.

A.I.C. RATING: REF. FAULT CURRENT STUDY NOTES ON RISER DIAGRAM SHEET

SPECIAL:

NOTES: (THESE ITEMS APPLY ONLY WHERE SPECIFIED BELOW)

(a) REFERENCE SPLIT SYSTEM / ROOFTOP ELECTRICAL CONNECTION SCHEDULE.

(b) REFERENCE TRANSFORMER SCHEDULE.

(c) REFERENCE FAN POWERED BOX / VAV CONNECTION SCHEDULE.

(d) PROVIDE WITH SHUNT TRIP BREAKER.

(e) PROVIDE WITH PERMANENTLY INSTALLED LOCKING DEVICE.

(f) PROVIDE WITH GFCCI BREAKER.

(g) REFERENCE ASSOCIATED PANEL SCHEDULE.

(h) PROVIDE 6" PANEL EXTENSION AND CTS.

CKT	Load Name	WireConduit	BKR	P	A kVA	B kVA	C kVA	P	BKR	WireConduit	Load Name	CKT
1	LIGHTING	9	20 A	1	2.3	2.3			1	20 A	9	LIGHTING
3	LIGHTING	9	20 A	1		2.3	2.3		1	20 A	9	LIGHTING
5	LIGHTING	9	20 A	1			2.3	2.3	1	20 A	9	LIGHTING
7	LIGHTING	9	20 A	1	2.3	2.3			1	20 A	9	LIGHTING
9	LIGHTING	9	20 A	1		2.3	2.3		1	20 A	9	LIGHTING
11	LIGHTING	9	20 A	1			2.3	2.3	1	20 A	9	LIGHTING
13	LIGHTING	9	20 A	1	2.3	2.3			1	20 A	9	LIGHTING
15	LIGHTING	9	20 A	1		2.3	2.3		1	20 A	9	LIGHTING
17	LIGHTING	9	20 A	1			1.8	2.8	1	20 A	9	LIGHTING
19	LIGHTING	9	20 A	1	2.8	2.8			1	20 A	9	LIGHTING
21	LIGHTING	9	20 A	1		2.8	0.0		1	20 A	--	SPARE
23	SPARE	--	20 A	1			0.0	0.0	1	20 A	--	SPARE
25	SPARE	--	20 A	1	0.0	0.0			1	20 A	--	SPARE
27	SPARE	--	20 A	1		0.0	0.0		1	20 A	--	SPARE
29	SPARE	--	20 A	1			0.0	0.0	1	20 A	--	SPARE
31	SPARE	--	70 A	3	0.0	--			1	--	--	SPACE
33	SPARE	--	70 A	3		0.0	--		1	--	--	SPACE
35									1	--	--	SPACE
37					17.7	0.0			1	--	--	SPACE
39	TILMAC	(b)	125 A	3		16.1	0.0		3	60 A	---	SPD
41						16.1	0.0					
		TOTAL LOAD:		37 kVA	33 kVA	30 kVA						
LOAD CLASSIFICATION		CONNECTED		DEMAND		ESTIMATED		PANEL TOTALS				
RCPT		41.6 kVA		62.01%		25.8 kVA		CONNECTED LOAD: 99.3 kVA ESTIMATED DEMAND: 96.3 kVA				
LITES		50.5 kVA		125.00%		63.2 kVA						
SPEC		8.3 kVA		100.00%		8.3 kVA						
								EST. DEMAND CURRENT: 115.8 A				
NOTES:												

## CIRCUIT BREAKER PANELBOARD: LMAC

## JOHNSON HIGH SCHOOL

LOCATION: SURFACE NEMA 1

MAIN DEVICE: 225.0 A MAIN CB

BUS AMPS: 225 AMPS

VOLTAGE: 208Y/120 V, 3 ø 4 W.

A.I.C. RATING: REF. FAULT CURRENT STUDY NOTES ON RISER DIAGRAM SHEET

SPECIAL:

NOTES: (THESE ITEMS APPLY ONLY WHERE SPECIFIED BELOW)

(a) REFERENCE SPLIT SYSTEM / ROOFTOP ELECTRICAL CONNECTION SCHEDULE.

(b) REFERENCE TRANSFORMER SCHEDULE.

(c) REFERENCE FAN POWERED BOX / VAV CONNECTION SCHEDULE.

(d) PROVIDE WITH SHUNT TRIP BREAKER.

(e) PROVIDE WITH PERMANENTLY INSTALLED LOCKING DEVICE.

(f) PROVIDE WITH GFCCI BREAKER.

(g) REFERENCE ASSOCIATED PANEL SCHEDULE.

(h) PROVIDE 6" PANEL EXTENSION AND CTS.

CKT	Load Name	WireConduit	BKR	P	A kVA	B kVA	C kVA	P	BKR	WireConduit	Load Name	CKT					
1	RECEPTACLES	2	20 A	1	1.9	1.9			1	20 A	2	RECEPTACLES	2				
3	RECEPTACLES	2	20 A	1		0.5	1.9		1	20 A	2	RECEPTACLES	4				
5	RECEPTACLES	2	20 A	1			0.7	1.9	1	20 A	2	RECEPTACLES	6				
7	RECEPTACLES	2	20 A	1	1.9	1.9			1	20 A	2	RECEPTACLES	8				
9	RECEPTACLES	2	20 A	1		1.9	1.9		1	20 A	2	RECEPTACLES	10				
11	RECEPTACLES	2	20 A	1			1.9	1.9	1	20 A	2	RECEPTACLES	12				
13	RECEPTACLES	2	20 A	1	1.9	1.9			1	20 A	2	RECEPTACLES	14				
15	RECEPTACLES	2	20 A	1		1.9	0.7		1	20 A	2	RECEPTACLES	16				
17	RECEPTACLES	2	20 A	1			1.9	0.5	1	20 A	2	RECEPTACLES	18				
19	RECEPTACLES	2	20 A	1	1.9	1.9			1	20 A	2	RECEPTACLES	20				
21	RECEPTACLES	2	20 A	1		1.9	1.9		1	20 A	2	RECEPTACLES	22				
23	RECEPTACLES	2	20 A	1			1.9	1.9	1	20 A	2	RECEPTACLES	24				
25	RECEPTACLES	2	20 A	1	1.9	1.9			1	20 A	2	RECEPTACLES	26				
27	SPORTS NETTING	2	20 A	1		1.7	1.7		1	20 A	2	SPORTS NETTING	28				
29	SPORTS NETTING	2	20 A	1		1.7	1.7	1.7	1	20 A	2	SPORTS NETTING	30				
31	SPORTS NETTING	2	20 A	1	1.7	0.0			1	20 A	---	SPACE	32				
33	SPARE	---	20 A	1		0.0	0.0		1	20 A	---	SPACE	34				
35	SPARE	---	20 A	1		0.0	0.0		1	20 A	---	SPACE	36				
37	SPARE	---	20 A	1	0.0	0.0							38				
39	SPARE	---	20 A	1		0.0	0.0		3	60 A	---	SPD	40				
41	SPARE	---	20 A	1									42				
		TOTAL LOAD:		18 kVA	18 kVA	18 kVA			PANEL TOTALS								
LOAD CLASSIFICATION		CONNECTED		DEMAND		ESTIMATED		CONNECTED LOAD: 49.9 kVA ESTIMATED DEMAND: 34.1 kVA  EST. DEMAND CURRENT: 94.7 A									
RCPT		41.6 kVA		62.01%		25.8 kVA											
SPEC		8.3 kVA		100.00%		8.3 kVA											
NOTES:																	

## CIRCUIT BREAKER PANELBOARD: LW

## JOHNSON HIGH SCHOOL


LOCATION: ELEC B111				VOLTAGE: 208Y/120 V, 3 ø 4 W.								
MOUNTING: SURFACE NEMA 3R				A.I.C. RATING: REF. FAULT CURRENT STUDY NOTES ON RISER DIAGRAM SHEET								
MAIN DEVICE: 225.0 A MAIN CB				SPECIAL:								
BUS AMPS: 225 AMPS												
NOTES: (THESE ITEMS APPLY ONLY WHERE SPECIFIED BELOW)												
(a) REFERENCE SPLIT SYSTEM / ROOFTOP ELECTRICAL CONNECTION SCHEDULE.								(e) PROVIDE WITH PERMANENTLY INSTALLED LOCKING DEVICE.				
(b) REFERENCE TRANSFORMER SCHEDULE.								(f) PROVIDE WITH GFCI BREAKER.				
(c) REFERENCE FAN POWERED BOX / VAV CONNECTION SCHEDULE.								(g) REFERENCE ASSOCIATED PANEL SCHEDULE.				
(d) PROVIDE WITH SHUNT TRIP BREAKER.								(h) PROVIDE 6" PANEL EXTENSION AND CTS.				
CKT	Load Name	Wire/Conduit	BKRR	P	A	B	C	P	BKRR	Wire/Conduit	Load Name	CKT
1	RECEPTACLES	2	20 A	1	0.9	0.9			1	20 A	2	RECEPTACLES
3	FACP	2	20 A	1		1.0	1.0		1	20 A	2	VENDING
5	VENDING	2	20 A	1			1.0	1.0	1	20 A	2	VENDING
7	RECEPTACLES	2	20 A	1	1.1	1.5			1	20 A	2	OVERHEAD DOOR POWER
9	RECEPTACLES	2	20 A	1		0.9	1.5		1	20 A	2	OVERHEAD DOOR POWER
11	RECEPTACLES	2	20 A	1			0.9	0.9	1	20 A	2	RECEPTACLES
13	RECEPTACLES	2	20 A	1	0.9	1.1			1	20 A	2	RECEPTACLES
15	RECEPTACLES	2	20 A	1		0.4	0.4		1	20 A	2	RECEPTACLES
17	RECEPTACLES	2	20 A	1			0.4	1.5	1	20 A	2 (f)	EWC
19	EWC	2, (f)	20 A	1	1.5	1.5			1	20 A	2	FIRE PUMP
21	RECEPTACLES	2	20 A	1		0.7	1.5		1	20 A	2	OVERHEAD DOOR POWER
23	OVERHEAD DOOR POWER	2	20 A	1			1.5	0.9	1	20 A	2	RECEPTACLES
25	RECEPTACLES	2	20 A	1	0.5	0.9			1	20 A	2	RECEPTACLES
27	AV POWER	2	20 A	1		1.0	1.0		1	20 A	2	AV POWER
29	ICE MAKER	2	20 A	1		1.5	1.0		1	20 A	2	REFRIGERATOR
31	RECEPTACLES	2	20 A	1	0.2	0.2			1	20 A	2	RECEPTACLES
33	RECEPTACLES	2	20 A	1		0.2	1.0		1	20 A	2	MERCHANDISER
35							1.8	1.8				
37	CF-5	7	20 A	3	1.8	1.8			3	20 A	7	CF-5
39						1.8	1.8					
41	RECEPTACLES	2	20 A	1			0.5	0.5	1	20 A	2	RECEPTACLES
43					1.8	1.1			1	20 A	2	ROOF RECEPTACLES
45	CF-5	7	20 A	3		1.8	0.4		1	20 A	2	EF-B1, B2
47							1.8	0.6	1	20 A	2	EF-B3
49	IDF RECEPTACLES	2	20 A	1	1.0	1.0			1	20 A	2	IDF RECEPTACLES
51	IDF RECEPTACLES	2	20 A	1		0.4	1.0		1	20 A	2	IDF RECEPTACLES
53	IDF RECEPTACLES	2	20 A	1		1.0	1.0		1	20 A	2	IDF RECEPTACLES
55	FUTURE IDF POWER	2	20 A	1	0.5	0.5			1	20 A	2	FUTURE IDF POWER
57	WH-B1	17	40 A	2		3.0	0.3		1	20 A	2	HWRP-B1
59						3.0	0.7		1	20 A	2	RECEPTACLES
61	RECEPTACLES	2	20 A	1	0.7	0.5			2	20 A	5	AHU-B1
63	RECEPTACLES	2	20 A	1		1.0	0.5					
65	RECEPTACLES	2	20 A	1			1.0	1.5	1	20 A	2	OVERHEAD DOOR POWER
67	OVERHEAD DOOR POWER	2	20 A	1	1.5	1.5			1	20 A	2	OVERHEAD DOOR POWER
69	FUTURE RACK LIGHTING	2	20 A	1		1.5	1.5		1	20 A	2	FUTURE RACK LIGHTING
71	FUTURE RACK LIGHTING	2	20 A	1		1.5	1.5		1	20 A	2	FUTURE RACK LIGHTING
73	FUTURE RACK LIGHTING	2	20 A	1	1.5	1.5			1	20 A	2	FUTURE RACK LIGHTING
75	SPARE	--	20 A	1		0.0	0.0		1	20 A	--	SPARE
77	SPARE	--	20 A	1			0.0	0.0	1	20 A	--	SPARE
79	SPARE	--	20 A	1	0.0	0.0			1	20 A	--	SPARE
81	SPARE	--	20 A	1		0.0	0.0		1	20 A	--	SPARE
83	SPARE	--	20 A	1		0.0	0.0	1	20 A	--	SPARE	
85	SPARE	--	20 A	1	0.0	0.0			1	20 A	--	SPARE
87	SPARE	--	20 A	1		0.0	0.0		1	20 A	--	SPARE
89	SPARE	--	20 A	1			0.0	0.0	1	20 A	--	SPARE
91	SPARE	--	20 A	1	0.0	0.0			1	20 A	--	SPARE
93	SPARE	--	20 A	1		0.0	0.0		1	20 A	--	SPARE
95	SPARE	--	20 A	1			0.0	0.0	1	20 A	--	SPARE
97	SPARE	--	20 A	1	0.0	0.0			1	20 A	--	SPARE
99	SPARE	--	20 A	1		0.0	0.0		1	20 A	--	SPARE
101	SPARE	--	20 A	2		0.0	0.0	2	20 A	--	SPARE	
103					0.0	0.0	--	--	1	--		
105									1	--		
107	SPARE	--	20 A	3			0.0	--	1	--		
109					0.0	--			1	--		
111	SPARE	--	--	1		--	--	--	1	--		
113	SPACE	--	--	1		--	--	--	1	--		
115	SPACE	--	--	1	--	--	--	--	1	--		
117	SPACE	--	--	1		--	--	--	1	--		
119	SPACE	--	--	1		--	--	--	1	--		
121	SPACE	--	--	1	--	0.0	--	--				
123	SPACE	--	--	1		--	0.0	--	3	60 A	SPD	
125	SPACE	--	--	1		--	--	0.0				
TOTAL LOAD:					27 kVA	25 kVA	28 kVA					
LOAD CLASSIFICATION		CONNECTED	DEMAND	ESTIMATED		PANEL TOTALS						
HVAC		2.0 kVA	100.00%	2.0 kVA								
RCPT		33.3 kVA	65.08%	21.6 kVA		CONNECTED LOAD: 80.7 kVA						
VENDING		9.0 kVA	125.00%	11.3 kVA		ESTIMATED DEMAND: 72.3 kVA						
SPEC		36.8 kVA	102.54%	37.7 kVA								
EST. DEMAND CURRENT: 200.6 A												
NOTES:												



## POWER KEY NOTES

THESE NOTES APPLY TO THIS SHEET ONLY

E14	SURFACE MOUNT RECEPTACLES TO FENCE POSTS. COORDINATE FINAL LOCATIONS WITH FENCING.
E16	PROVIDE A UNISTRUT RACK FOR MOUNTING OF PANELS AND SPD'S. VERTICAL SECTION TO BE 3" RIGID PIPE BURIED A MINIMUM OF 3 FEET DEEP AND POURED IN CONCRETE. COORDINATE WITH ARCHITECT FOR EXACT PLACEMENT. SPRAY PAINT ALL CUT ENDS OR EXPOSED THREAD WITH GOLD GALVANIZED SPRAY PAINT.
E23	MOUNT RECEPTACLES AT CROWS NEST VIEWING PLATFORM AT STANDARD HEIGHT ABOVE PLATFORM.
E24	POWER FOR SPORTS NETTING MOTORS. COORDINATE INSTALLATION LOCATION AND ELECTRICAL CONNECTION REQUIREMENTS WITH ACTUAL EQUIPMENT PROVIDED.

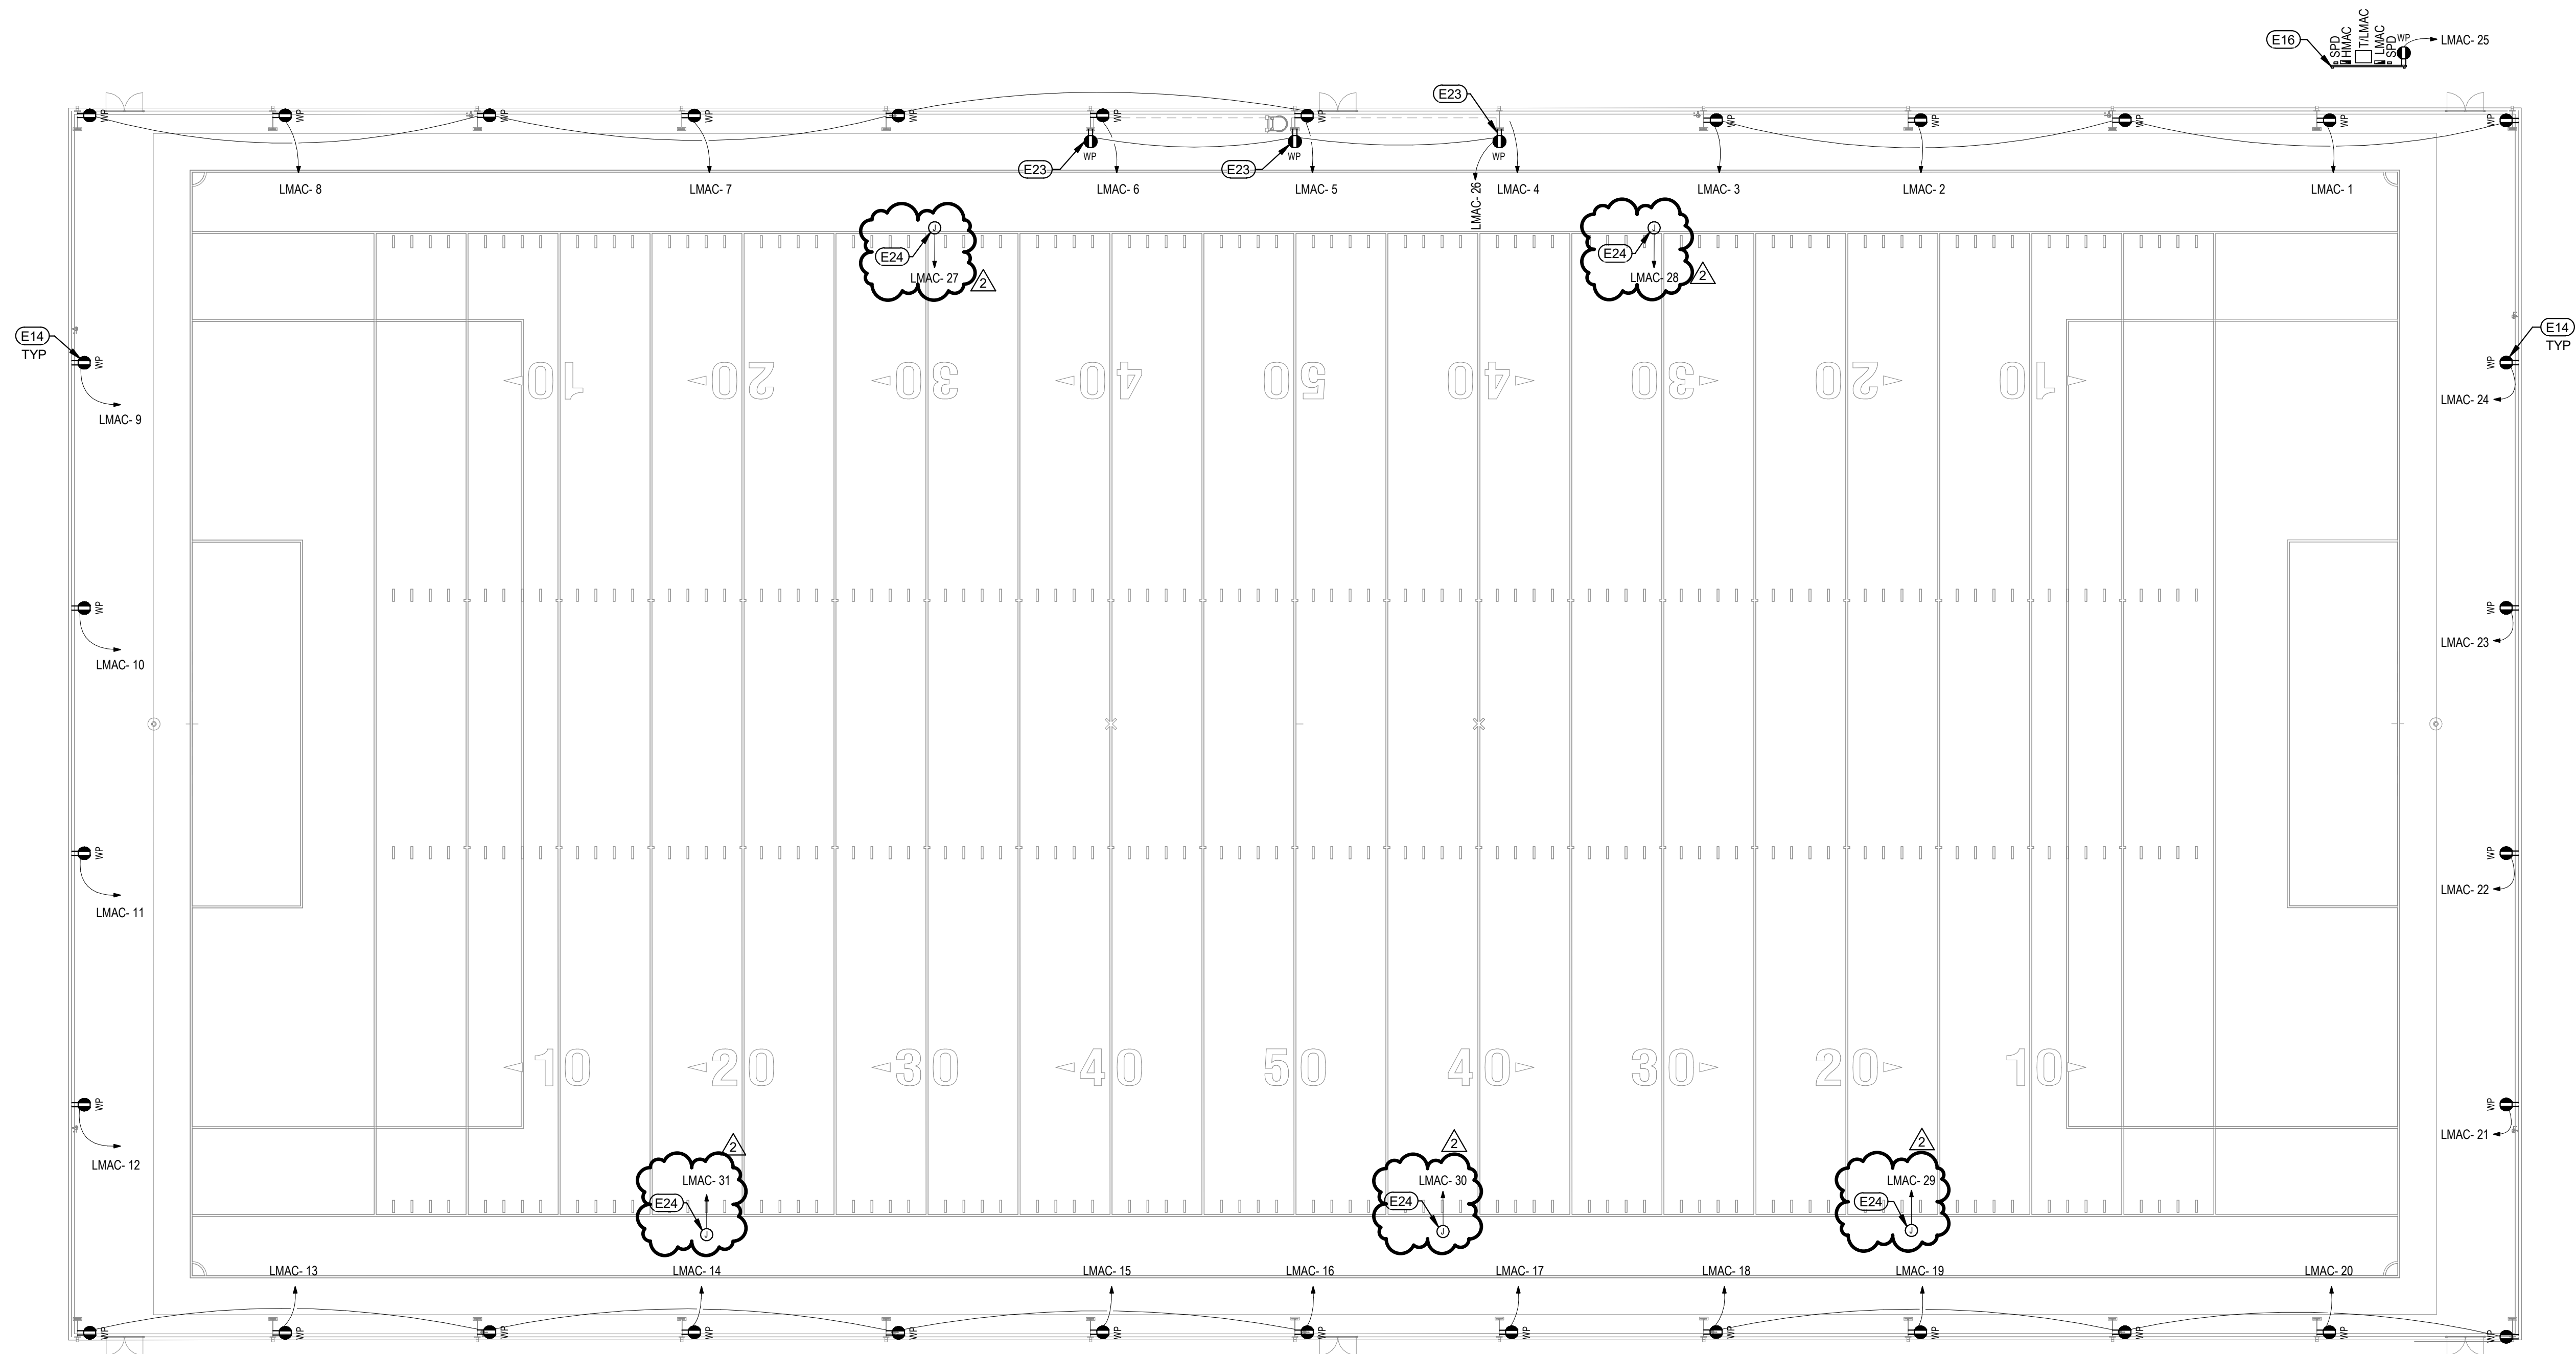

01 FIRST FLOOR PLAN - AREA A - POWER  
SCALE: 1/16" = 1'-0"



FOR LOCATIONS WHERE POWER AND DATA  
ARE SHOWN TOGETHER, DEVICE ROUGH-IN  
IS TO BE A MAXIMUM OF 6" APART.  
PROVIDE CADDY BRACKETS AS REQUIRED.

ALL 20A/1P RECEPTACLES INSTALLED AT  
AN ELEVATION LESS THAN 5'-6" AFF AND  
NOT WITHIN A DEDICATED APPLIANCE.  
SPACE SHALL BE A TAMPER RESISTANT  
RECEPTACLE PER NEC 406.12

REFERENCE MECHANICAL FAN  
SCHEDULE FOR EXHAUST FAN  
SWITCHING REQUIREMENTS.


## POWER KEY NOTES

THESE NOTES APPLY TO THIS SHEET ONLY

- E2 EWC POWER. RECEPTACLE FOR POWER BEHIND EWC TO HAVE GFCI BREAKER AT PANEL. COORDINATE FINAL ROUGH-IN LOCATION.
- E4 ELECTRICAL PANEL. DO NOT RUN ANY PIPING OR DUCTWORK OVER ELECTRIC PANELS.
- E6 AV EQUIPMENT POWER. COORDINATE RECEPTACLE LOCATIONS WITH TECHNOLOGY PRIOR TO ROUGH-IN.
- E7 FIELD COORDINATE PLACEMENT OF DISCONNECTING MEANS FOR WATER HEATERS AND RE-CIRCULATING PUMP.
- E8 COORDINATE RECEPTACLE LOCATIONS WITH MIRROR LOCATIONS AND ADJUST AS REQUIRED TO AVOID MIRRORS.
- E10 POWER FOR OVERHEAD DOOR. REFERENCE MISCELLANEOUS EQUIPMENT SCHEDULE FOR ADDITIONAL INFORMATION.
- E11 JUNCTION BOX ABOVE CEILING WITH CIRCUIT FOR FUTURE USE.
- E13 LOCATIONS SHOWN IN THIS ROOM ARE DIAGRAMMATICAL. COORDINATE WITH FIRE PROTECTION SHOP DRAWINGS PRIOR TO LOCATING ANY ROUGH-IN.
- E15 POWER FOR AV RACK. COORDINATE ROUGH-IN LOCATION AND REQUIREMENTS WITH TECHNOLOGY PLANS.
- E17 REFERENCE MECHANICAL FAN SCHEDULE FOR CONTROL OF EXHAUST FANS.
- E18 COORDINATE FINAL RECEPTACLE LOCATIONS WITH MILLWORK PRIOR TO ROUGH-IN. REVIEW FINAL ARCHITECTURAL INTERIOR ELEVATIONS FOR FINAL LAYOUTS OF EQUIPMENT TO BE POWERED.
- E19 POWER FOR H.V.L.S FAN CONTROLLER. PROVIDE SNAP SWITCH AND 120V TO 12V DC TRANSFORMER ABOVE CEILING WITH 3/4" DOWN WALL TO J-BOX FOR MOUNTING FAN CONTROLLER.
- E20 FUTURE RACK LIGHTING CONTROL WALL PANEL APPROXIMATE LOCATION. PROVIDE 3/4" TO CEILING MOUNTED J-BOX FOR RACK LIGHTING CONTROL. COORDINATE FINAL WALL PANEL LOCATION WITH OWNER PRIOR TO ROUGH-IN.
- E21 PROVIDE 3/4" DATA FROM J-BOX TO FUTURE LIGHTING CONTROLLER IN IDF ROOM.
- E22 POWER FOR FUTURE GYM EQUIPMENT LIGHTING.


CONFIRM FINAL LAYOUT AND POWER REQUIREMENTS  
WITH TECHNOLOGY PRIOR TO ROUGH-IN.

GENERAL CONTRACTOR TO PROVIDE SHOP DRAWING  
SHOWING ROOM LAYOUT OF ALL SPECIAL SYSTEMS  
EQUIPMENT PANELS INCLUDING FIRE ALARM, DDC,  
ACCESS CONTROL, SECURITY, VIDEO, ETC PRIOR TO  
INSTALLATION OF ANY ROUGH-IN FOR ELECTRICAL,  
TECHNOLOGY, AND OWNER APPROVAL.

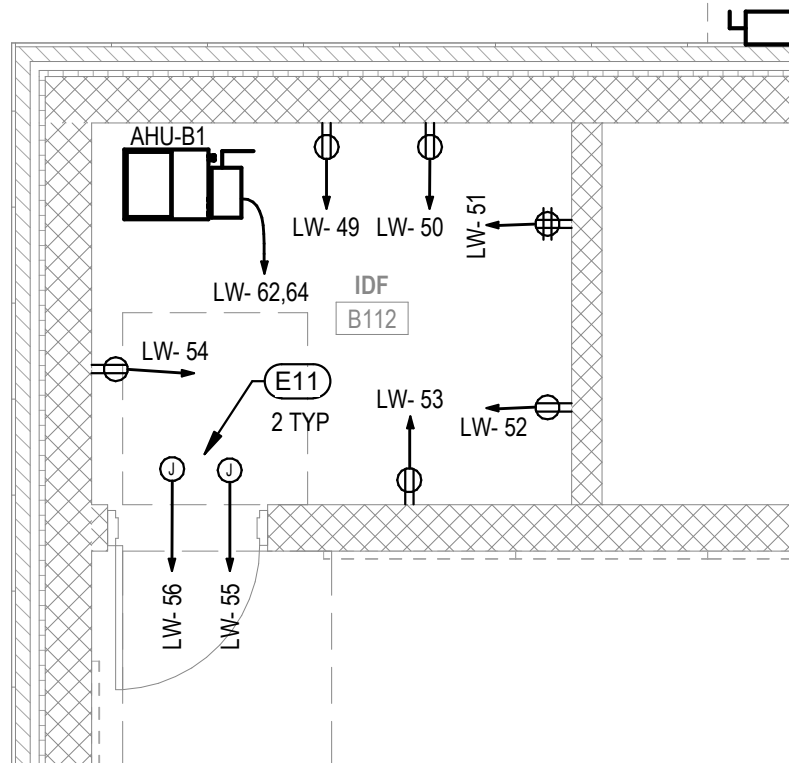



## 02 ENLARGED IDF ROOM - POWER

SCALE: 1/4" = 1'-0"

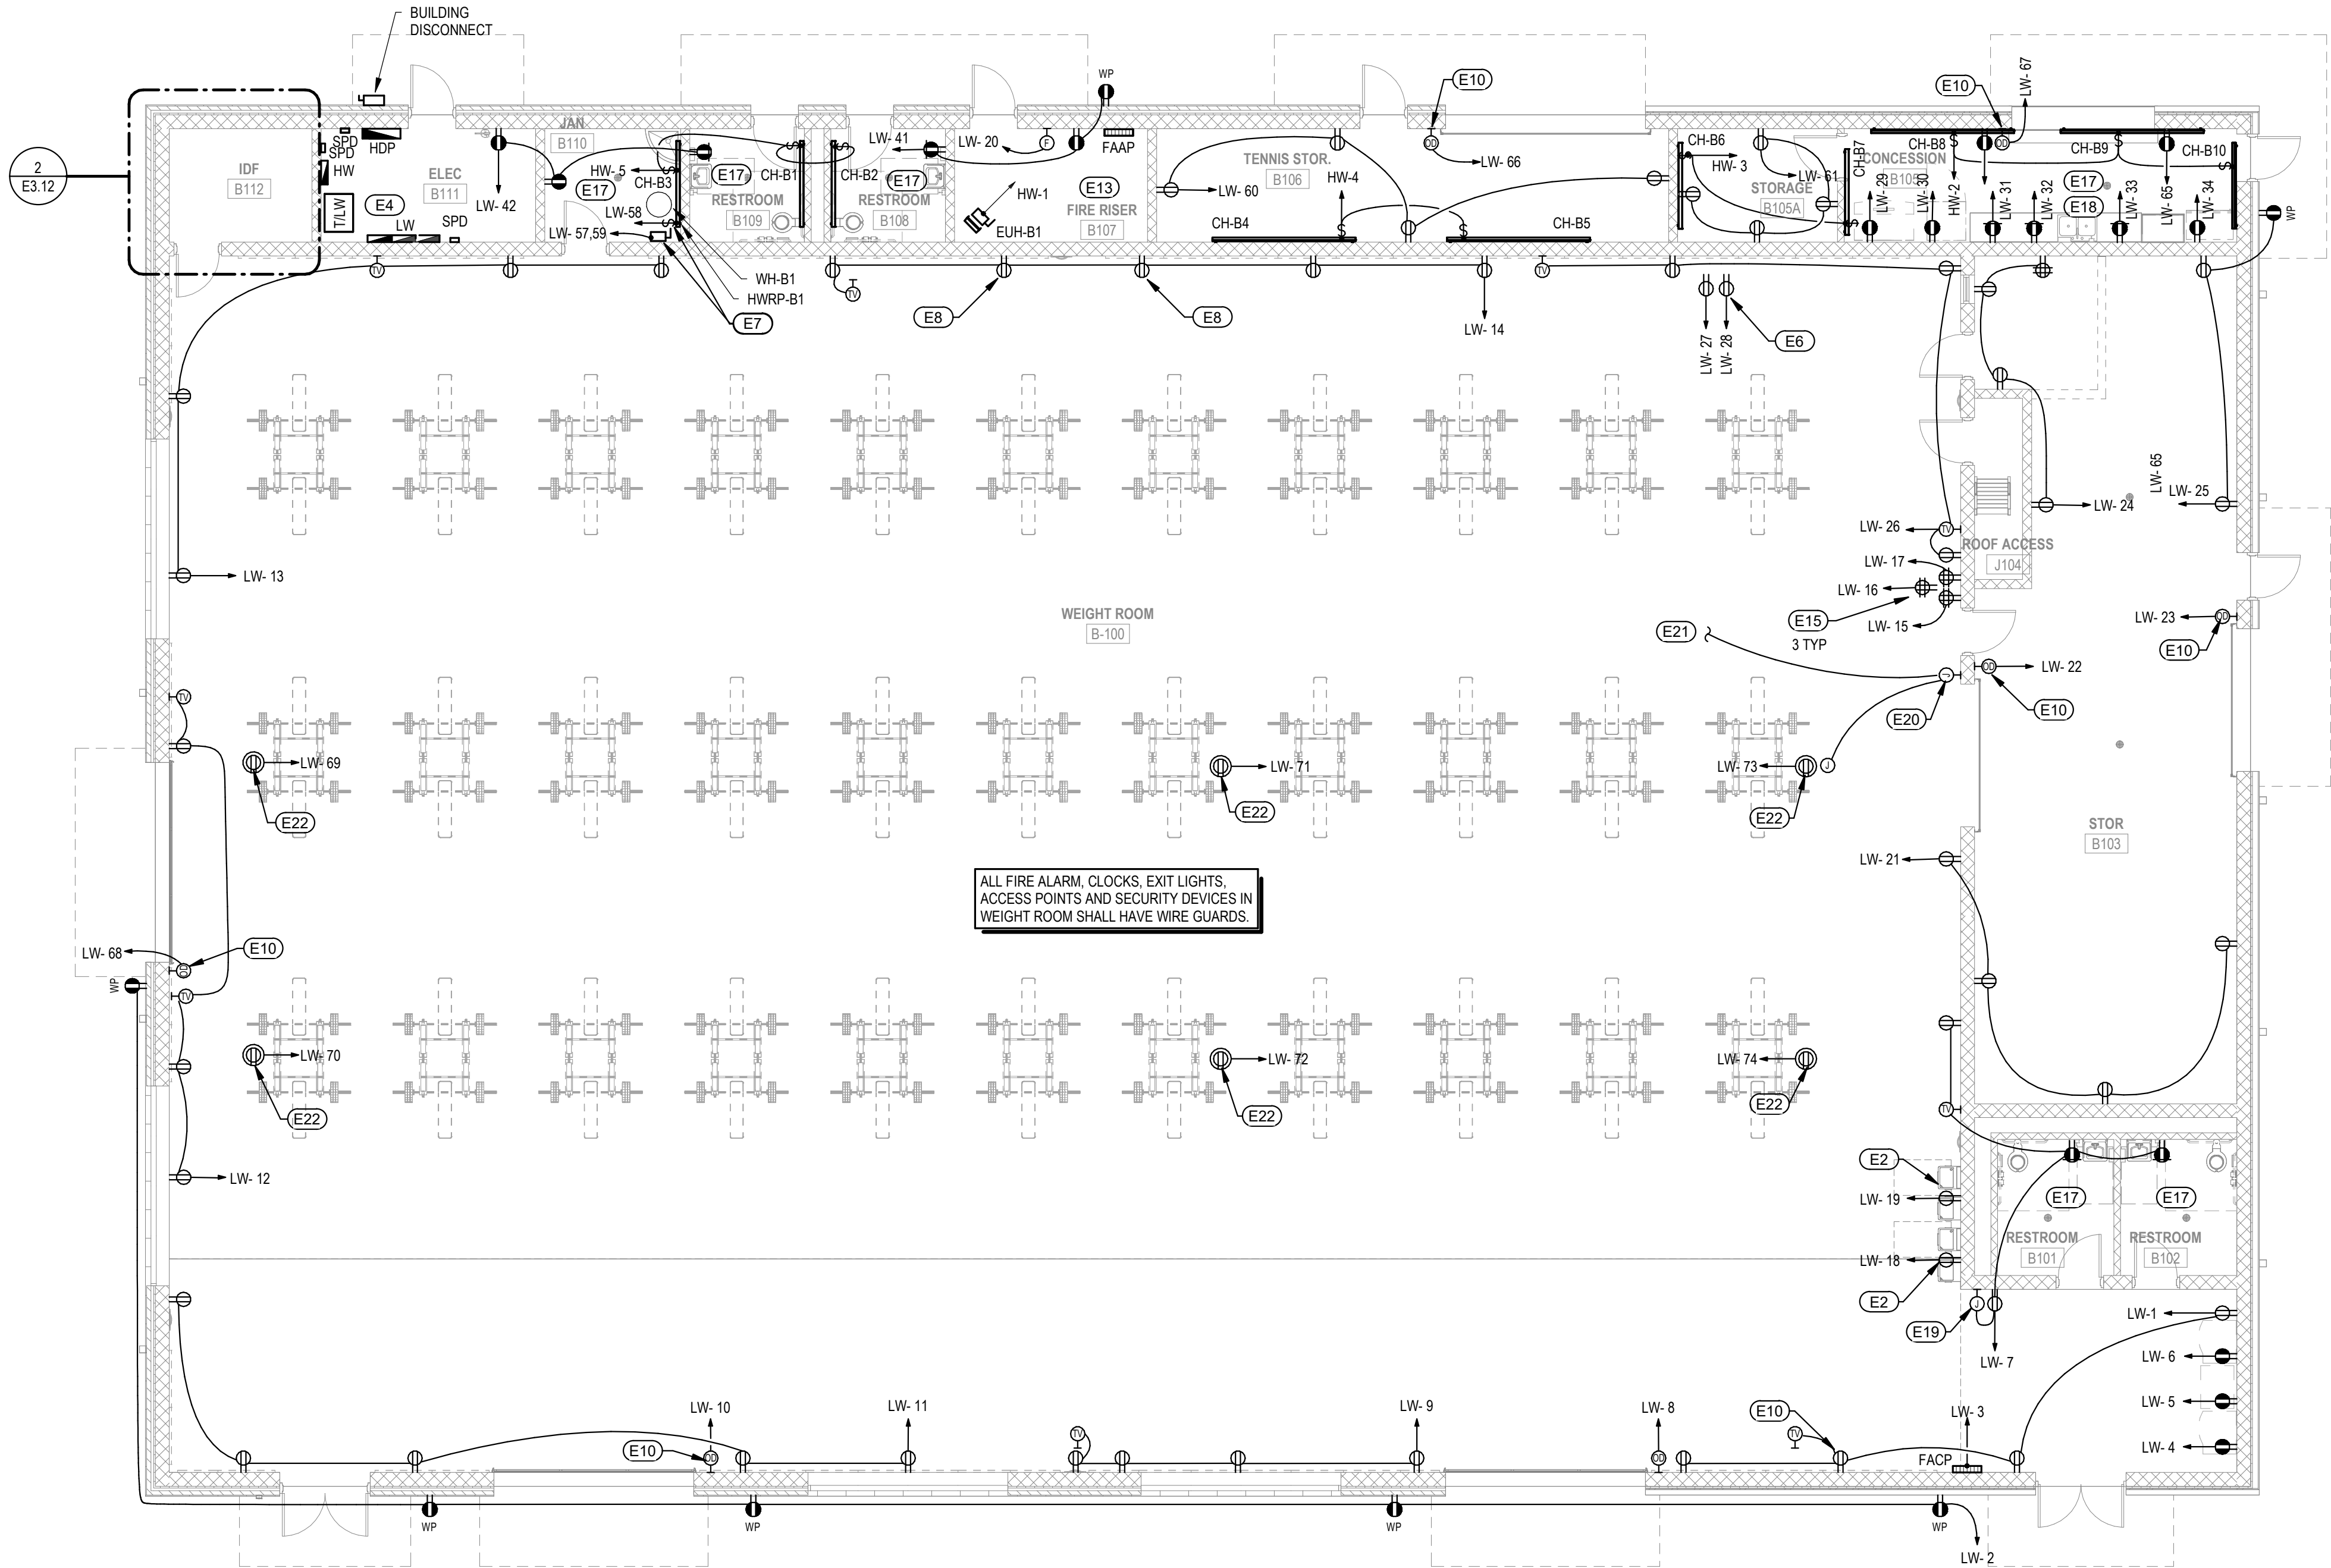

## 01 FIRST FLOOR PLAN - AREA B - POWER

SCALE: 1/8" = 1'-0"

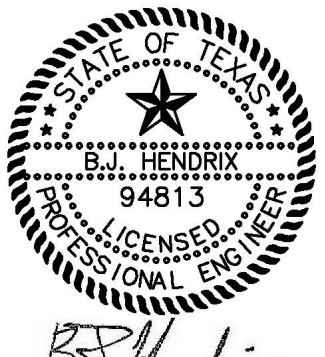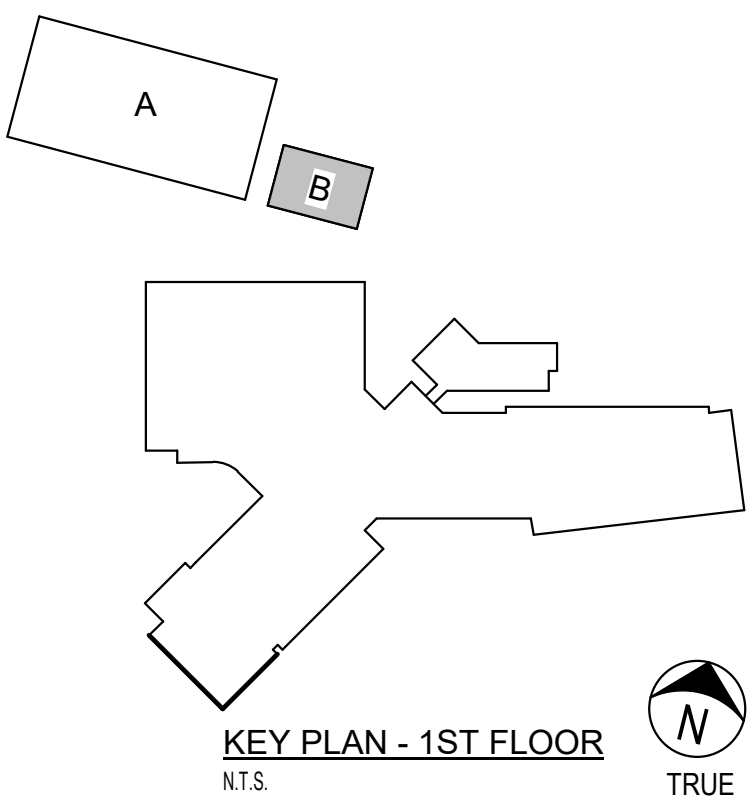

THESE DOCUMENTS ARE THE PROPERTY OF  
HENDRIX CONSULTING ENGINEERS  
AND SHALL REMAIN THE PROPERTY OF  
HENDRIX CONSULTING ENGINEERS  
IF ANY PART OF THESE DOCUMENTS  
IS REPRODUCED OR TRANSMITTED IN  
ANY FORM OR BY ANY MEANS  
ELECTRONIC OR MECHANICAL  
INCLUDING PHOTOCOPYING, RECORDING,  
OR BY ANY INFORMATION STORAGE  
AND RETRIEVAL SYSTEM  
WITHOUT WRITTEN PERMISSION FROM  
HENDRIX CONSULTING ENGINEERS.

REFERENCE GENERAL NOTES ON  
SHEETS MD-01, PD-01, AND ED-01  
FOR ADDITIONAL INFORMATION

MEP/ENERGY CONSULTANTS

HCE HENDRIX CONSULTING ENGINEERS

COMMERCIAL - FIELD INVESTIGATION

This document, the ideas and  
designs incorporated herein are  
and shall remain the property of  
Hendrix Consulting Engineers.  
These documents are not to be  
used or altered, in whole or in  
part, for other than the original  
intended use, nor are they to be  
assigned to any third party  
without written permission from  
Hendrix Consulting Engineers.

F - 4095  
HCE Job no.: 24-033

JOHNSON HIGH SCHOOL  
2025 ADDITIONS + RENOVATIONS  
FOR  
HAYS CISD  
BUDA, TX

Project:



1954-07-01  
Drawn By:  
PP, LMM  
Date:  
04/22/2025

FIRST FLOOR PLAN - AREA  
B - POWER

PACKAGE VOLUME

Job No. 1954-07-01

Sheet No. ISSUE FOR BD

03.12




## SITE KEY NOTES

THESE NOTES APPLY TO THIS SHEET ONLY


- S1 ROUTE OVERHEAD FROM EXISTING 'MSD' IN MAIN ELECTRIC ROOM TO EXTERIOR WALL. 'LB' DOWN TO BELOW GRADE AT BUILDING EXTERIOR. COORDINATE PENETRATION LOCATION WITH ARCHITECT PRIOR TO INSTALLATION.
- S2 FIELD COORDINATE WITH EXISTING SLEEVE LOCATIONS UNDER ROAD
- S3 EXTEND EXISTING SITE LIGHTING CIRCUIT TO NEW FIXTURES. WIRE/CONDUIT MARK #12.
- S4 REMOVE EXISTING FIXTURE HEAD ON EXISTING POLE AND ADD SPECIFIED HEADS AT 90 DEGREES APART IN ORIENTATION SHOWN ON PLAN. DRILL POLE FOR NEW HEADS. PLUG EXISTING HOLES. CONTRACTOR SHALL INSPECT EXISTING POLE AND BASEPLATE FOR CRACKING AND REPLACE IF REQUIRED. MAINTAIN EXISTING CIRCUITING.

ALL SITE CIRCUITING IS DIAGRAMMATIC ONLY. DOES NOT INDICATE CONDUIT ROUTING. ELECTRICAL CONTRACTOR IS TO DETERMINE ALL FINAL CONDUIT ROUTING, COORDINATED WITH ALL SITE UTILITIES AND SITE CONDITIONS. REFERENCE CIVIL AND LANDSCAPE PLANS FOR ADDITIONAL INFORMATION. ALL BURIED ELECTRICAL TO BE INSTALLED WITH WARNING TAPE ABOVE THE CONDUIT.

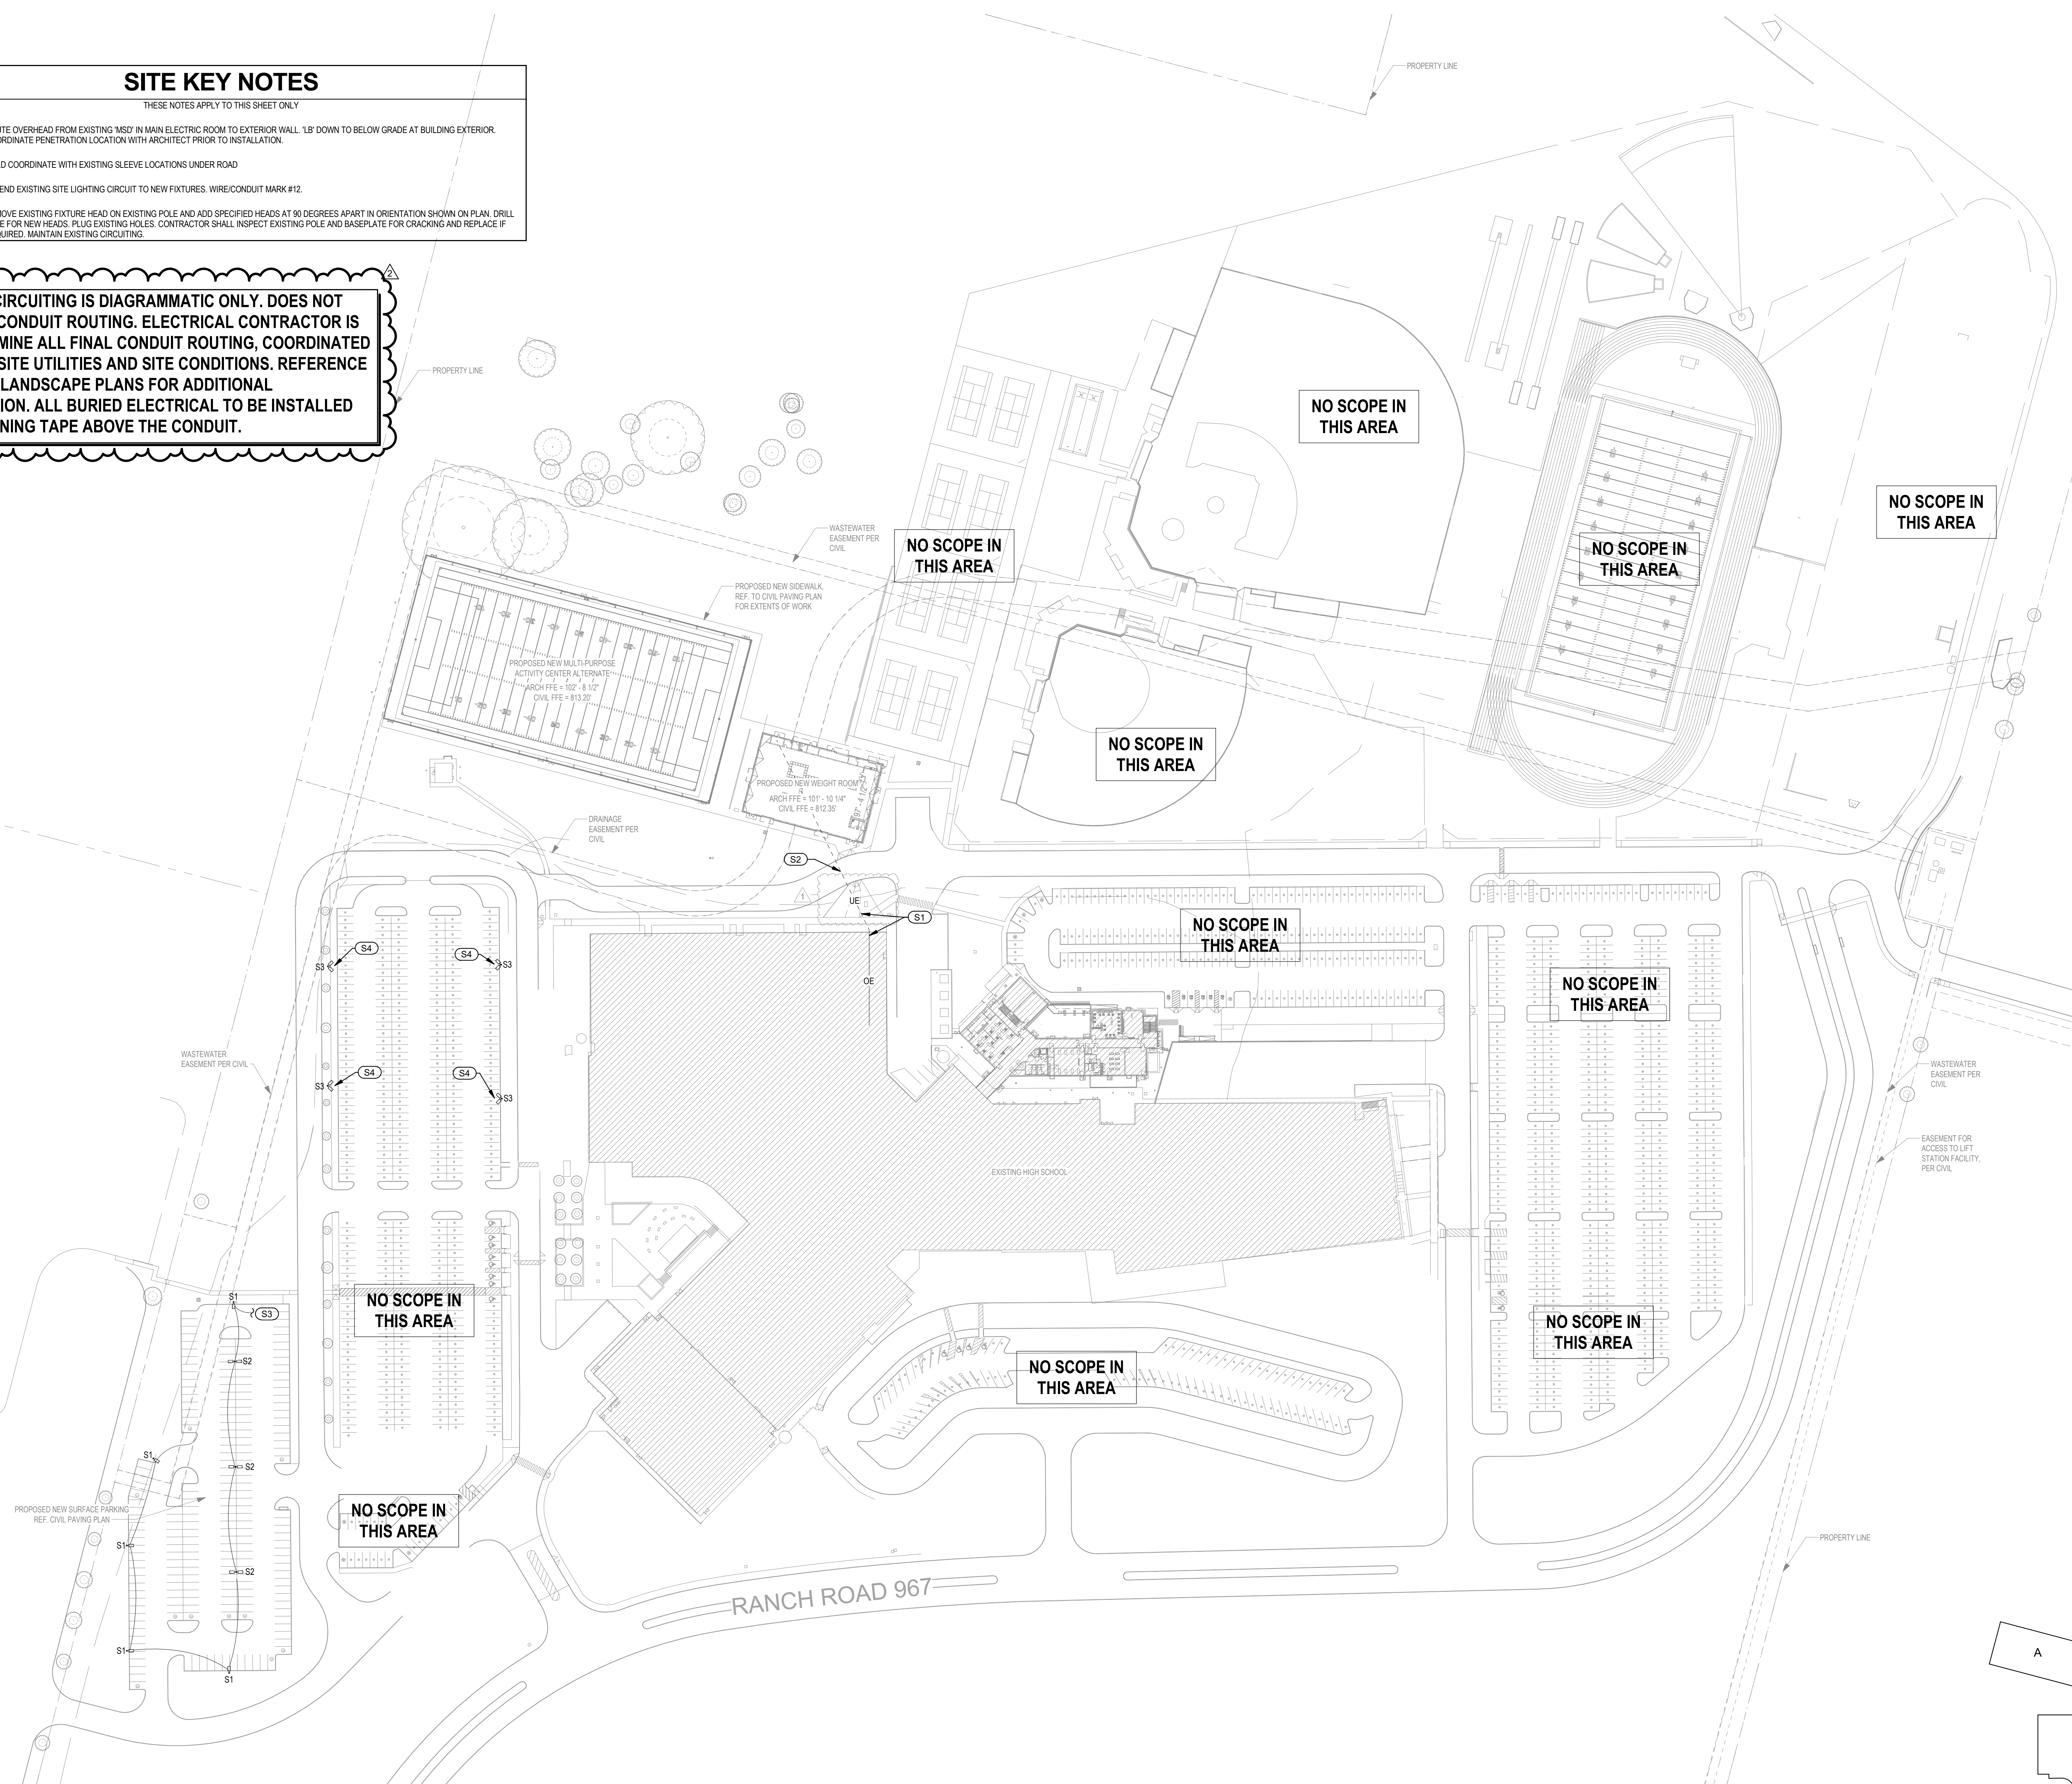

## 01 SITE PLAN - ELECTRICAL

SCALE: 1" = 80'-0"

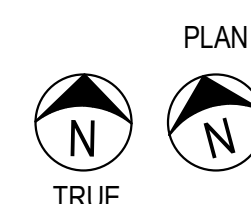

KEY PLAN - 1ST FLOOR  
N.T.S.



REFERENCE GENERAL NOTES ON SHEETS MD-01, PD-01, AND ED-01 FOR ADDITIONAL INFORMATION

MEP/ENERGY CONSULTANTS

HCE HENDRIX CONSULTING ENGINEERS

COMMISSIONING + FIELD INVESTIGATIONS

This document, the ideas and designs incorporated herein are and shall remain the property of Hendrix Consulting Engineers. These documents are not to be used or altered, in whole or in part, for other than the original intended use, nor are they to be assigned to any third party without written permission from Hendrix Consulting Engineers.

F - 4095  
HCE Job no.: 24-033